


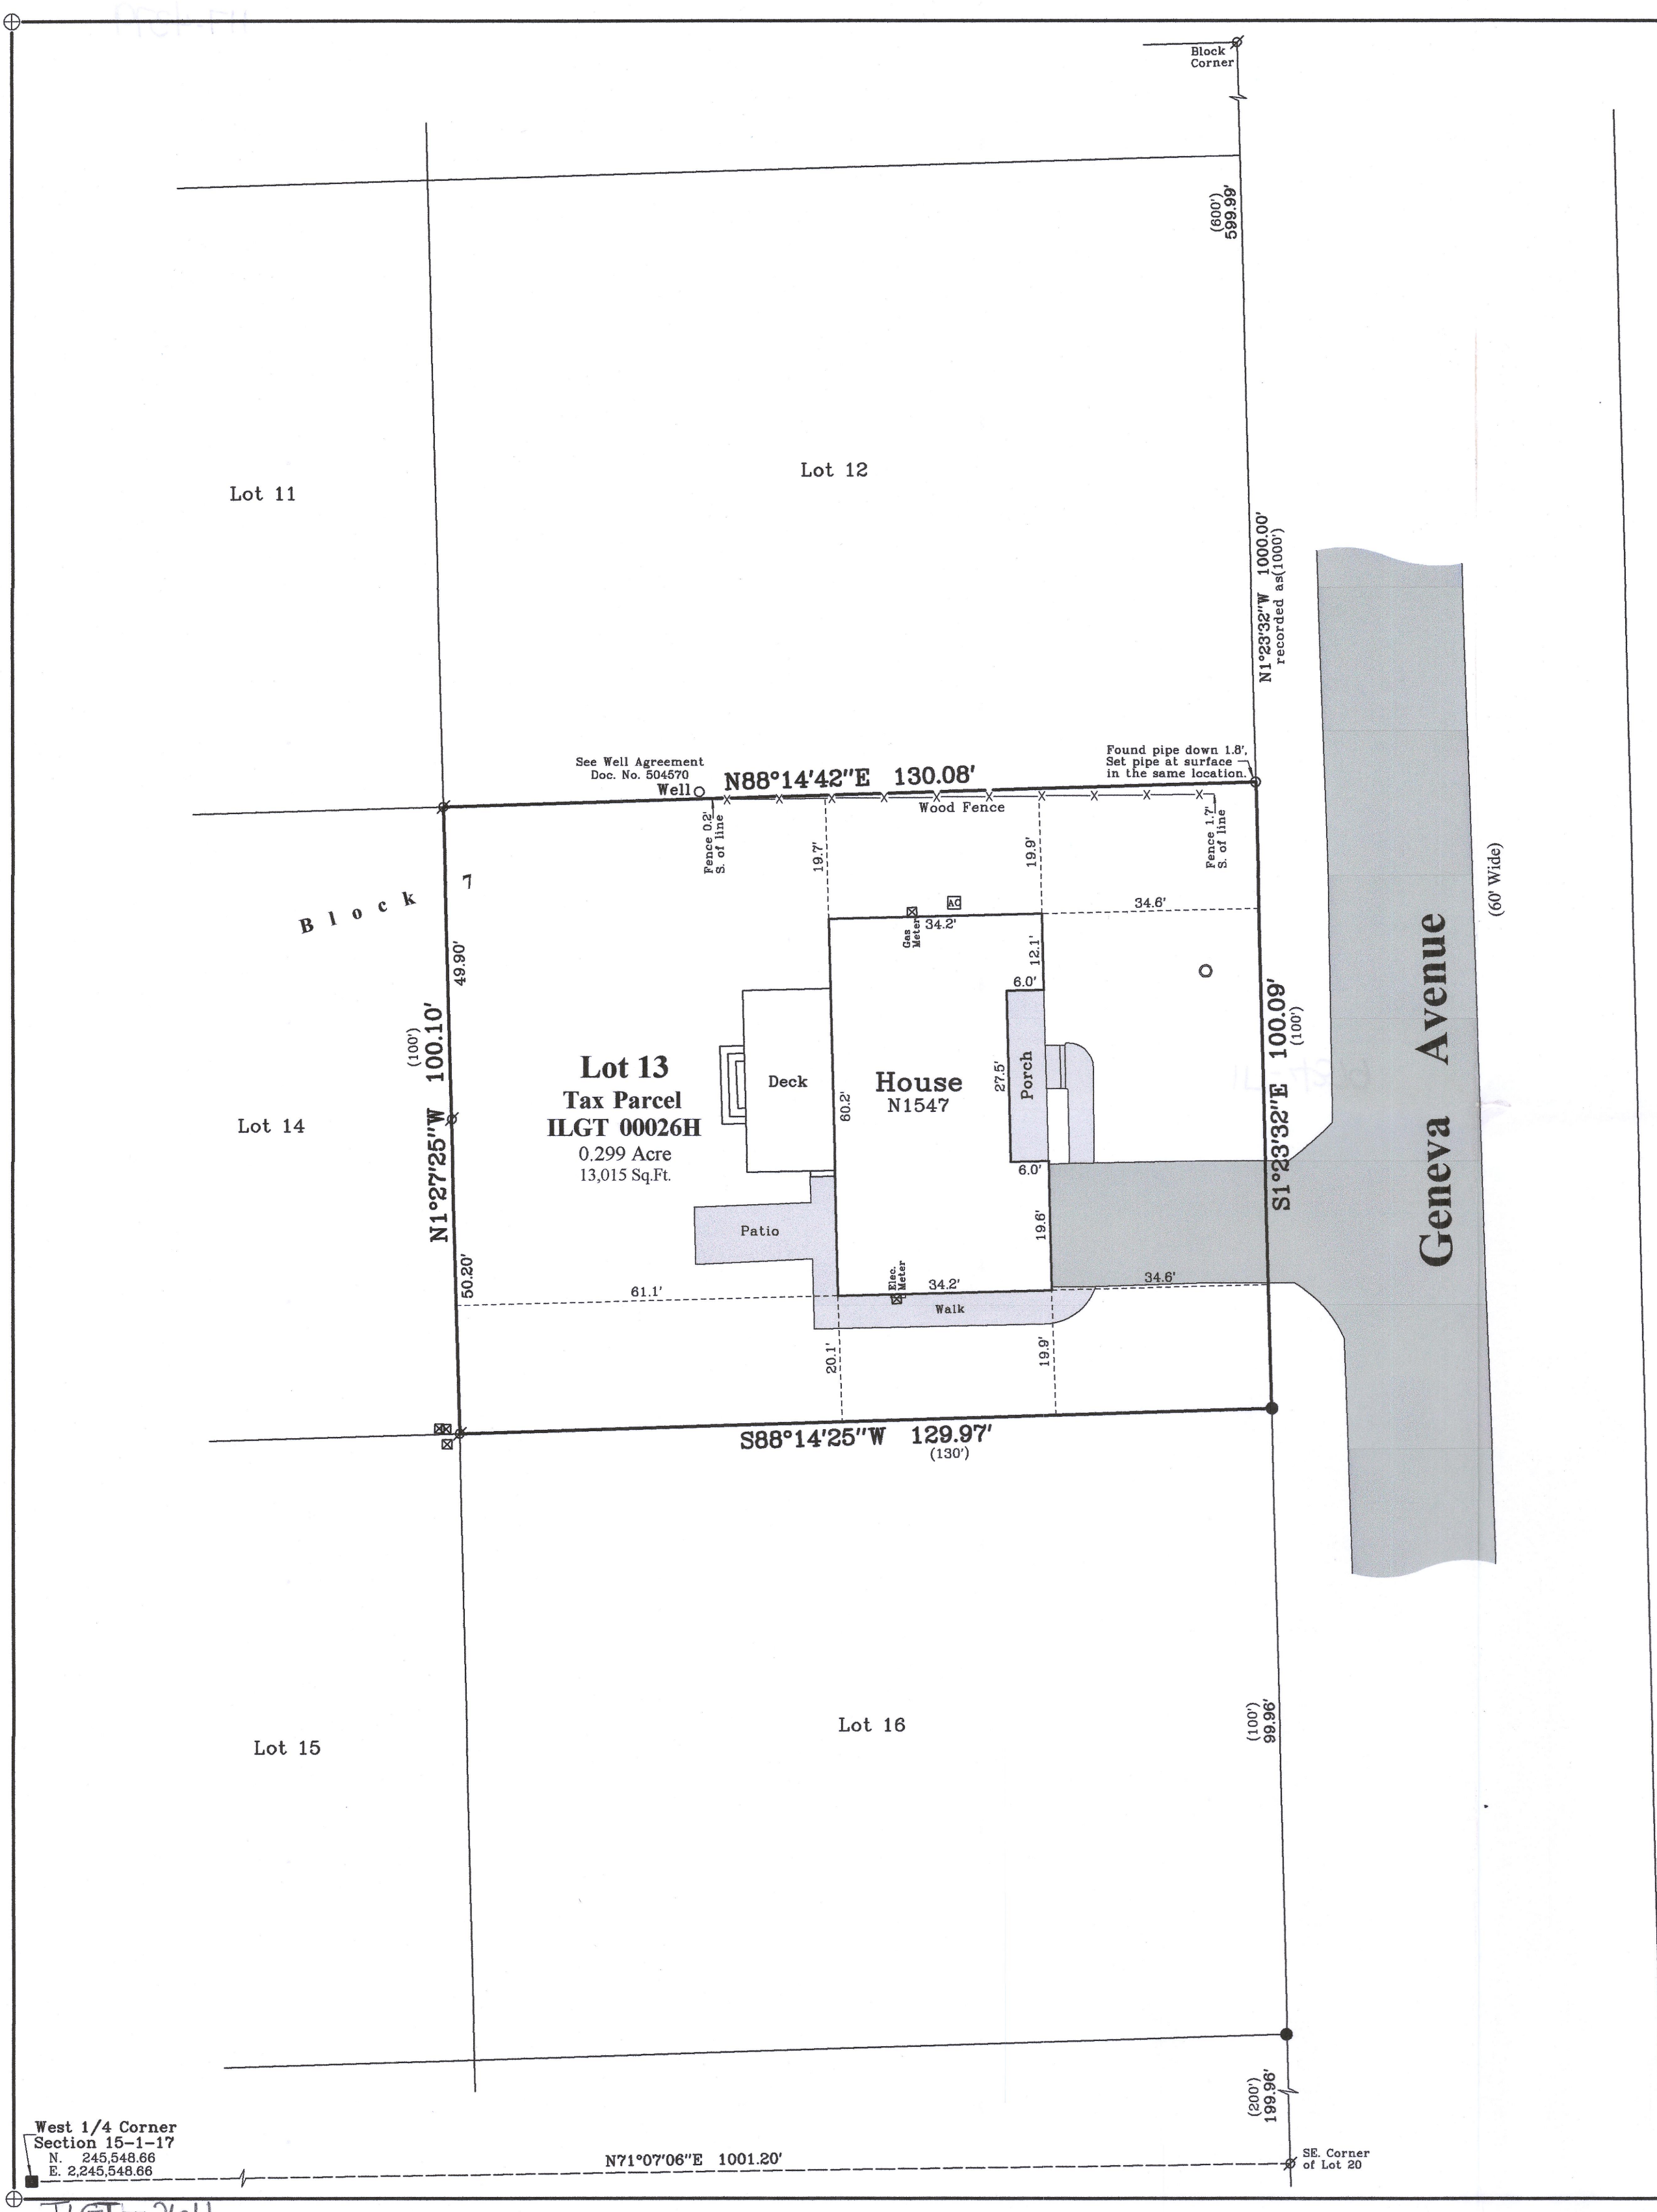


Plat of Survey

of

Lot 13 in Block 7 of Lake Geneva Terrace,



a subdivision located in the Southwest 1/4 of the Northwest 1/4 of Section 15,
Town 1 North, Range 17 East, Town of Linn, Walworth County, Wisconsin.

Surveyed for: **Watts Investments, LLC**
P.O. Box 545
Williams Bay, Wisconsin. 53191

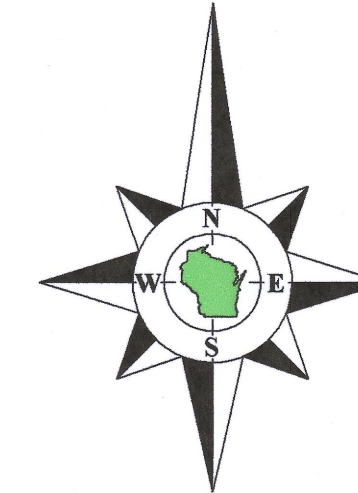

Bearings referenced to the West line of the Northwest 1/4 of Section 15-1-17,
recorded as N1°23'01\"/>

Coordinates are referenced to the Wisconsin State
Plane Coordinate System, South Zone, (NAD-27).

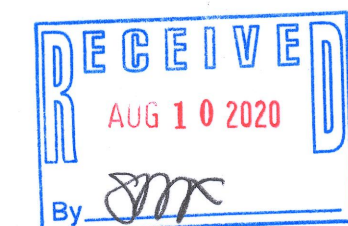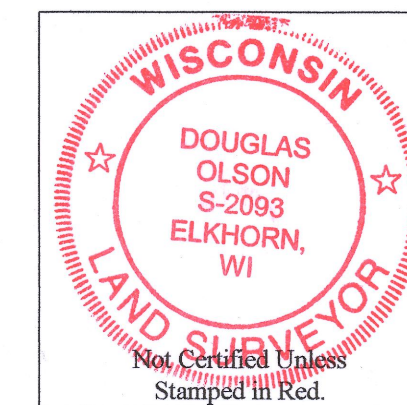

Notes:

- 1) This Plat of Survey is not certified unless signed and sealed in red ink.
- 2) This survey is subject to Wisconsin lien laws. This Plat of Survey is the notice of intent to file lien. Lien waiver required.
- 3) The Survey Date shown on this Plat of Survey is the completion date of the field work.

Copyright ©2020 by Olson Land Surveying, LLC.


All rights reserved. No part of this survey plat may be reproduced or transmitted in any form by any means - graphic, electronic, or mechanical, including photocopying, tracing, or information storage and retrieval systems - without permission in writing from Douglas G. Olson, Olson Land Surveying, LLC.

I hereby certify that I have surveyed the above described property in compliance with Chapter A-E 7 of the Wisconsin Administrative Code and that the map hereon is correct to the best of my professional knowledge and belief and shows the size and location of the property, its exterior boundaries, the location and dimensions of all visible structures thereon, boundary fences, apparent easements and roadways and visible encroachments, if any.

This survey is made for the exclusive use of the present owners of the property, and also those who purchase, mortgage or guarantee title thereto, within one year from the date hereof.

Douglas G. Olson
Wisconsin Professional Land Surveyor - 2093

Survey Date: May 20, 2020.
Revisions:

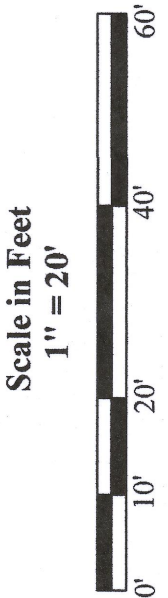

45 South Wisconsin Street | P.O. Box 322
Elkhorn, Wisconsin 53121
Telephone: (262) 723-3434
Facsimile: (262) 723-8044
Email: doug@olsonsurveying.com
Website: www.olsonsurveying.com

OLSON
LAND SURVEYING, LLC
Rural | Residential | Commercial

Legend of Symbols & Abbreviations	
	North
	Section Corner
	Found Iron Pipe
	Set Iron Pipe, 1\" data-bbox="100 760 120 790"/>
	Set Iron Pipe, 1\" data-bbox="100 730 120 760"/>
	Set Iron Pipe, 1\" data-bbox="100 700 120 730"/>
	Set Iron Pipe, 1\" data-bbox="100 670 120 700"/>
	Set Iron Pipe, 1\" data-bbox="100 640 120 670"/>
	Set Iron Pipe, 1\" data-bbox="100 610 120 640"/>
	Set Iron Pipe, 1\" data-bbox="100 580 120 610"/>
	Set Iron Pipe, 1\" data-bbox="100 550 120 580"/>
	Set Iron Pipe, 1\" data-bbox="100 520 120 550"/>
	Set Iron Pipe, 1\" data-bbox="100 490 120 520"/>
	Set Iron Pipe, 1\" data-bbox="100 460 120 490"/>
	Set Iron Pipe, 1\" data-bbox="100 430 120 460"/>
	Set Iron Pipe, 1\" data-bbox="100 400 120 430"/>
	Set Iron Pipe, 1\" data-bbox="100 370 120 400"/>
	Set Iron Pipe, 1\" data-bbox="100 340 120 370"/>
	Set Iron Pipe, 1\" data-bbox="100 310 120 340"/>
	Set Iron Pipe, 1\" data-bbox="100 280 120 310"/>
	Set Iron Pipe, 1\" data-bbox="100 250 120 280"/>
	Set Iron Pipe, 1\" data-bbox="100 220 120 250"/>
	Set Iron Pipe, 1\" data-bbox="100 190 120 220"/>
	Set Iron Pipe, 1\" data-bbox="100 160 120 190"/>
	Set Iron Pipe, 1\" data-bbox="100 130 120 160"/>
	Set Iron Pipe, 1\" data-bbox="100 100 120 130"/>
	Set Iron Pipe, 1\" data-bbox="100 70 120 100"/>
	Set Iron Pipe, 1\" data-bbox="100 40 120 70"/>
	Set Iron Pipe, 1\" data-bbox="100 10 120 40"/>

Sheet 1 of 1 Sheets
Drawing Name
Job Reference Number
2020.050

2020.050

West 1/4 Corner
Section 15-1-17
N. 245,548.66
E. 2,245,548.66

N71°07'06\"/>

SE Corner
of Lot 20

ILGT-206H

117-4379