


PLAT OF SURVEY  
-OF-

LOTS 7-11 IN BLOCK 11 OF "WOODDALE ADDITION", ACCORDING TO THE RECORDED PLAT THEREOF. SAID LAND BEING IN THE NORTHEAST 1/4 OF THE NORTHWEST 1/4 OF SECTION 16, TOWNSHIP 1 NORTH, RANGE 17 EAST OF THE FOURTH PRINCIPAL MERIDIAN, IN THE TOWN OF LINN, COUNTY OF WALWORTH AND STATE OF WISCONSIN.


SURVEY FOR: MARIANE WEIGLEY

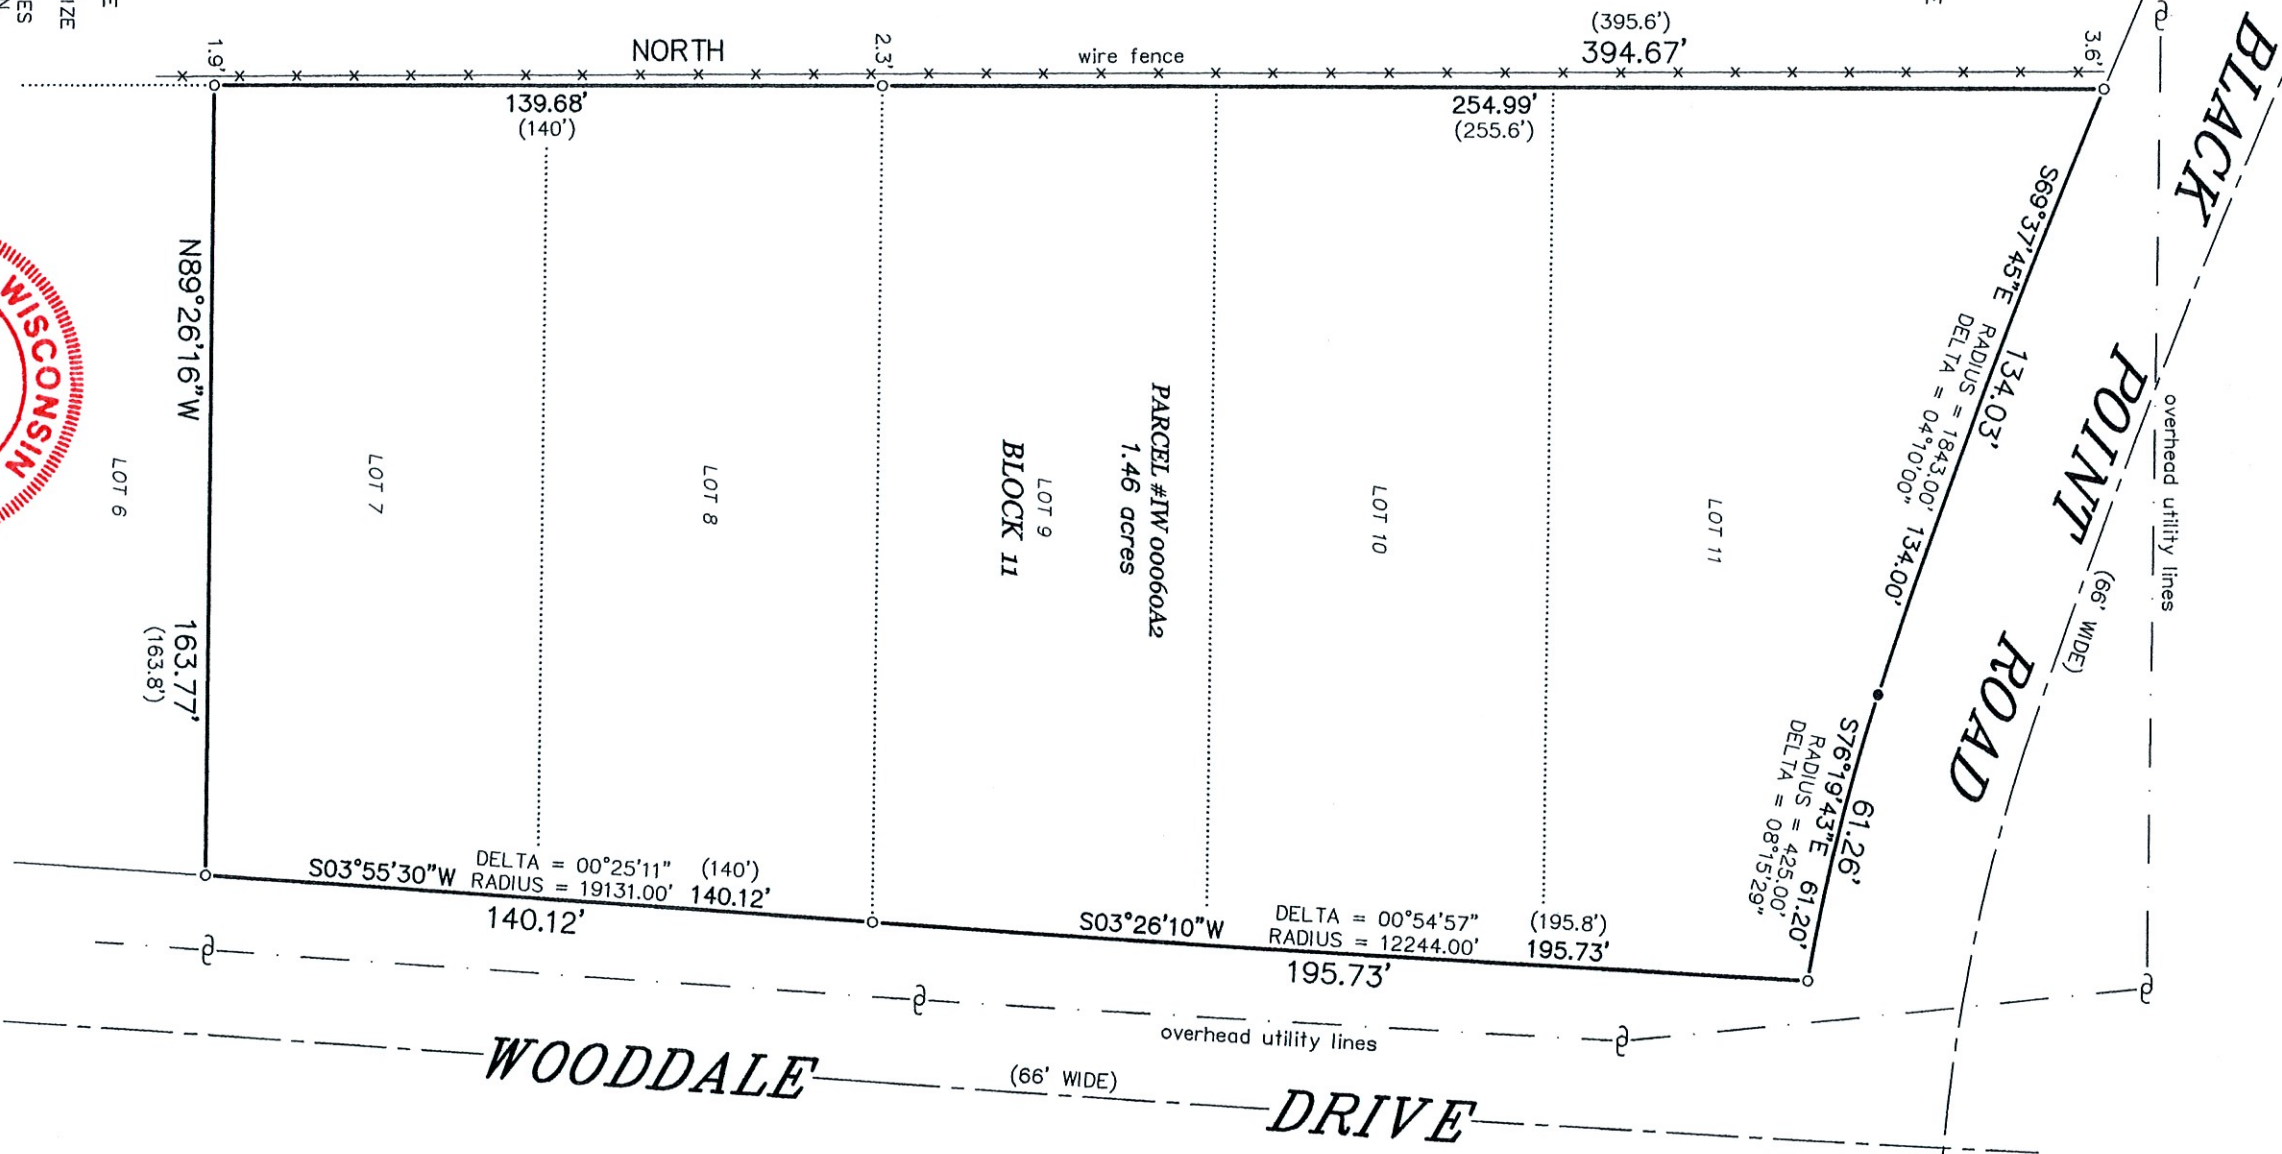

NOTE: THE RECORDED SUBDIVISION PLAT OF "WOODDALE ADDITION" IS SOMEWHAT VAGUE IN NATURE AND LACKS BEARINGS AND CURVE DATA FOR THE INDIVIDUAL LOTS. THE IRON RODS FOUND AT THE PROPERTY CORNERS WERE ACCEPTED AS THE BEST EVIDENCE OF THE PROPERTY LINES AND THE CURVES ALONG THE STREET LINES WERE ESTABLISHED USING SAID RODS AND RADIUS INFORMATION FOR THE CURVES DEPICTED ON THE RECORDED PLAT.

- LEGEND
- FOUND IRON ROD
  - SET IRON ROD
  - ( ) RECORDED AS
  - ⌒ UTILITY POLE
  - OVERHEAD UTILITY LINES

BEARINGS HEREON RELATE TO THE WEST LINE OF LOTS 7-11 IN BLOCK 11 OF "WOODDALE ADDITION" SUBDIVISION. ASSUMED BEARING OF NORTH.

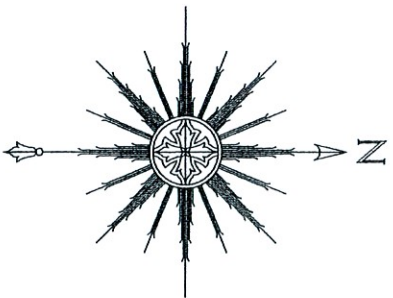

0 20' 40' 80'  
SCALE: 1" = 40'

"I, HEREBY CERTIFY THAT I HAVE SURVEYED THE ABOVE DESCRIBED PROPERTY AND THAT THE ABOVE MAP IS A CORRECT REPRESENTATION THEREOF AND SHOWS THE SIZE AND LOCATION OF THE PROPERTY, ITS EXTERIOR BOUNDARIES, THE LOCATION OF ALL VISIBLE STRUCTURES AND DIMENSIONS OF ALL PRINCIPAL BUILDINGS THEREON, BOUNDARY FENCES, APPARENT EASEMENTS, ROADWAYS AND ENCROACHMENTS, IF ANY."

"THIS SURVEY IS MADE FOR THE USE OF THE PRESENT OWNERS OF THE PROPERTY, AND THOSE WHO PURCHASE, MORTGAGE, OR GUARANTEE THE TITLE THERETO WITHIN ONE YEAR FROM DATE HEREOF."

**SATTER SURVEYING, LLC**  
LAND SURVEYS, MAPPING AND PLANNING  
272 ORIGIN STREET  
BURLINGTON, WI 53105  
262-661-4239



THIS IS NOT AN ORIGINAL PRINT  
UNLESS THIS SEAL IS RED.

OCTOBER 21, 2020  
DATE

102001  
JOB NUMBER

*Thomas L. Satter*  
THOMAS L. SATTER S-2850