


HAROLD H. KOLB

REGISTERED PROFESSIONAL LAND SURVEYOR
LAKE GENEVA, WISCONSIN



N

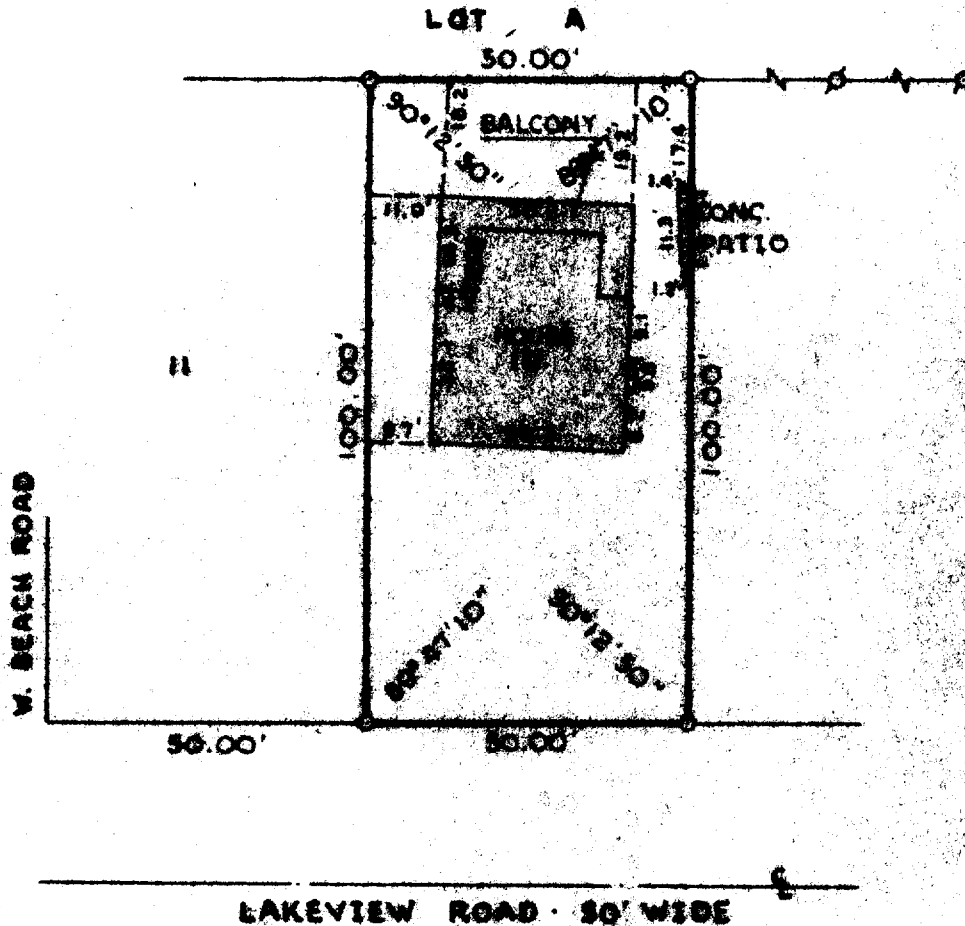

SCALE: 1"=30'

LEGEND


- ♦ - IRON PIPE FOUND
- - IRON PIPE PLACED
- - CONCRETE MONUMENT
- x - SPIKE

OWNER: Ruth Morgan

ACCURACY: Distances $\pm 0.01'$
Angles $\pm 05''$
Error of closure
less than $1/3000$

PLAT OF SURVEY OF
Lot 10, Lake Geneva Highlands, a sub-
division located in the Southeast $\frac{1}{4}$ of
Section 8, T 1 N, R 17 E, Walworth
County, Wisconsin.

I, HAROLD H. KOLB, DO HEREBY CERTIFY THAT I HAVE
SURVEYED THE PROPERTY HEREON DESCRIBED ACCORDING
TO THE OFFICIAL RECORDS AND THAT THE PLAT HEREON
IS A CORRECT REPRESENTATION OF THE LOT LINES.

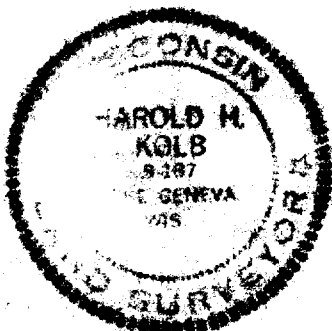

Harold H. Kolb

HAROLD H. KOLB
WISCONSIN REGISTERED LAND SURVEYOR, 9-187
DATE August 19, 1974

ELG H-10

107-447