


HAROLD H. KOLB

REGISTERED PROFESSIONAL LAND SURVEYOR
LAKE GENEVA, WISCONSIN

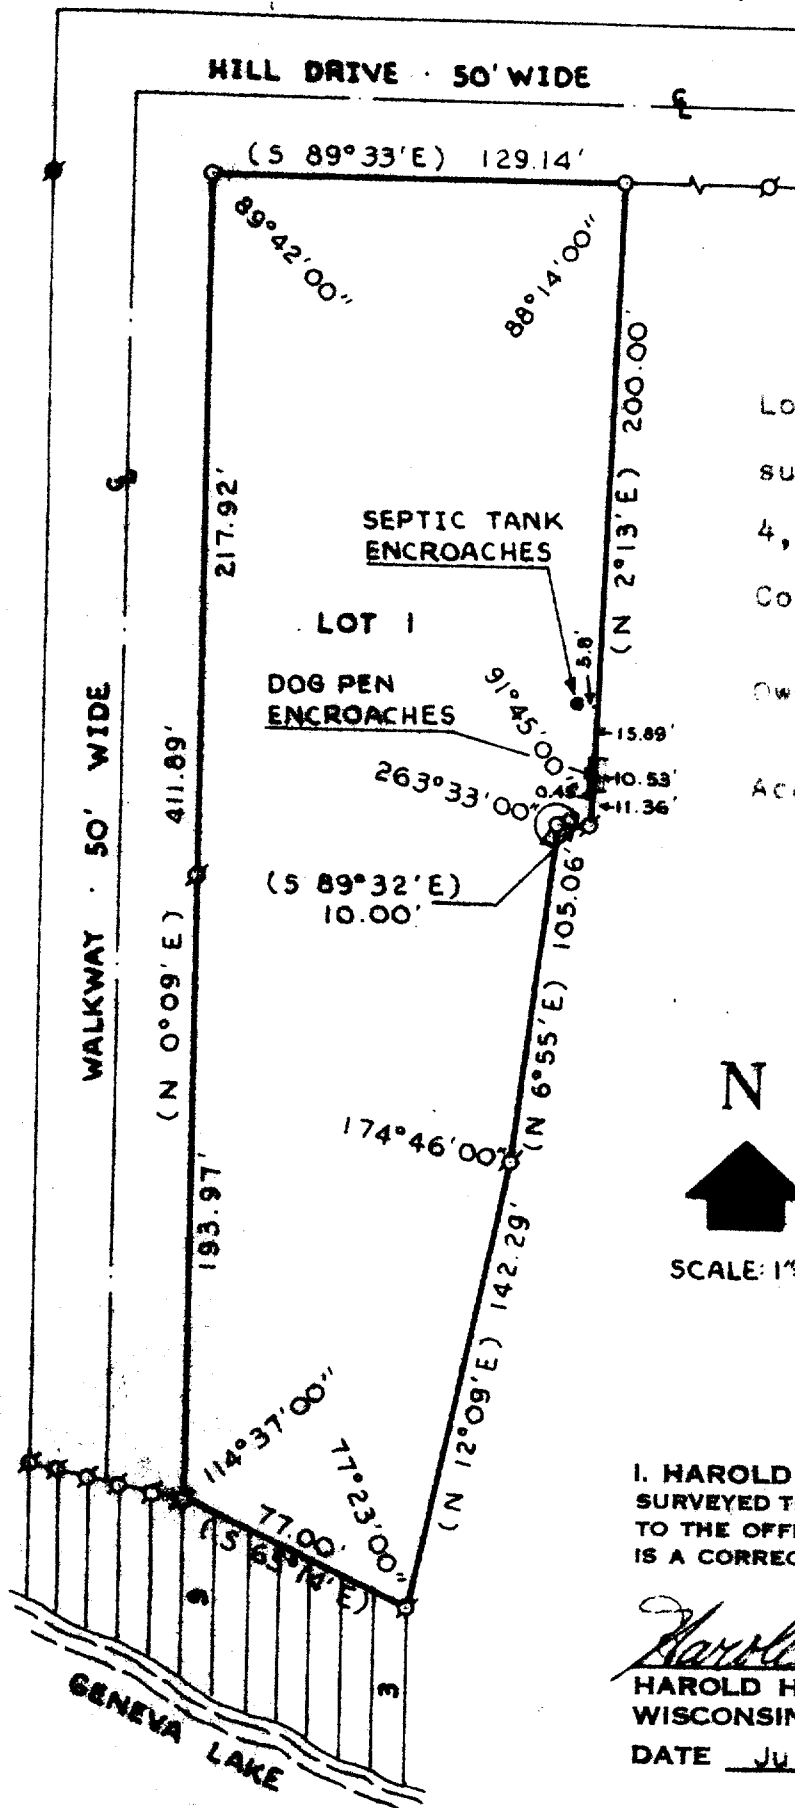

PLAT OF SURVEY OF
Lot 1, Alta Vista Estates, a
subdivision located in Section
4, T 1 N, R 17 E, Walworth
County, Wisconsin.

Owner: Robert Metcalf


Accuracy: Distances $\pm 0.01'$
Angles $\pm 05''$
Error of Closure less
than 1/3000

LEGEND

- Concrete Monument Found
- Iron Pipe Found
- Iron Pipe Placed
- ()—Platted

N

SCALE: 1"=60'

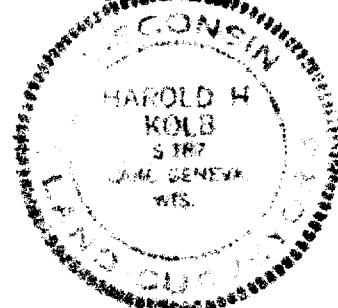

I, HAROLD H. KOLB, DO HEREBY CERTIFY THAT I HAVE
SURVEYED THE PROPERTY HEREON DESCRIBED ACCORDING
TO THE OFFICIAL RECORDS, AND THAT THE PLAT HEREON
IS A CORRECT REPRESENTATION OF THE LOT LINES.

Harold H. Kolb
HAROLD H. KOLB
WISCONSIN REGISTERED LAND SURVEYOR, S-187
DATE July 30, 1974

IAN-1

117-449