


PLAT OF SURVEY & TOPOGRAPHIC MAPPING LOTS 49 & 50 OF BLOCK J OF CISCO BEACH, A SUBDIVISION

LOCATED IN PART OF THE NW 1/4 OF THE NE 1/4
OF SECTION 5, TOWN 1 NORTH, RANGE 17 EAST,
TOWN OF LINN, WALWORTH COUNTY, WISCONSIN

ASSIGNED WEST LINE OF LANDS SURVEYED
N 00°00'00" W

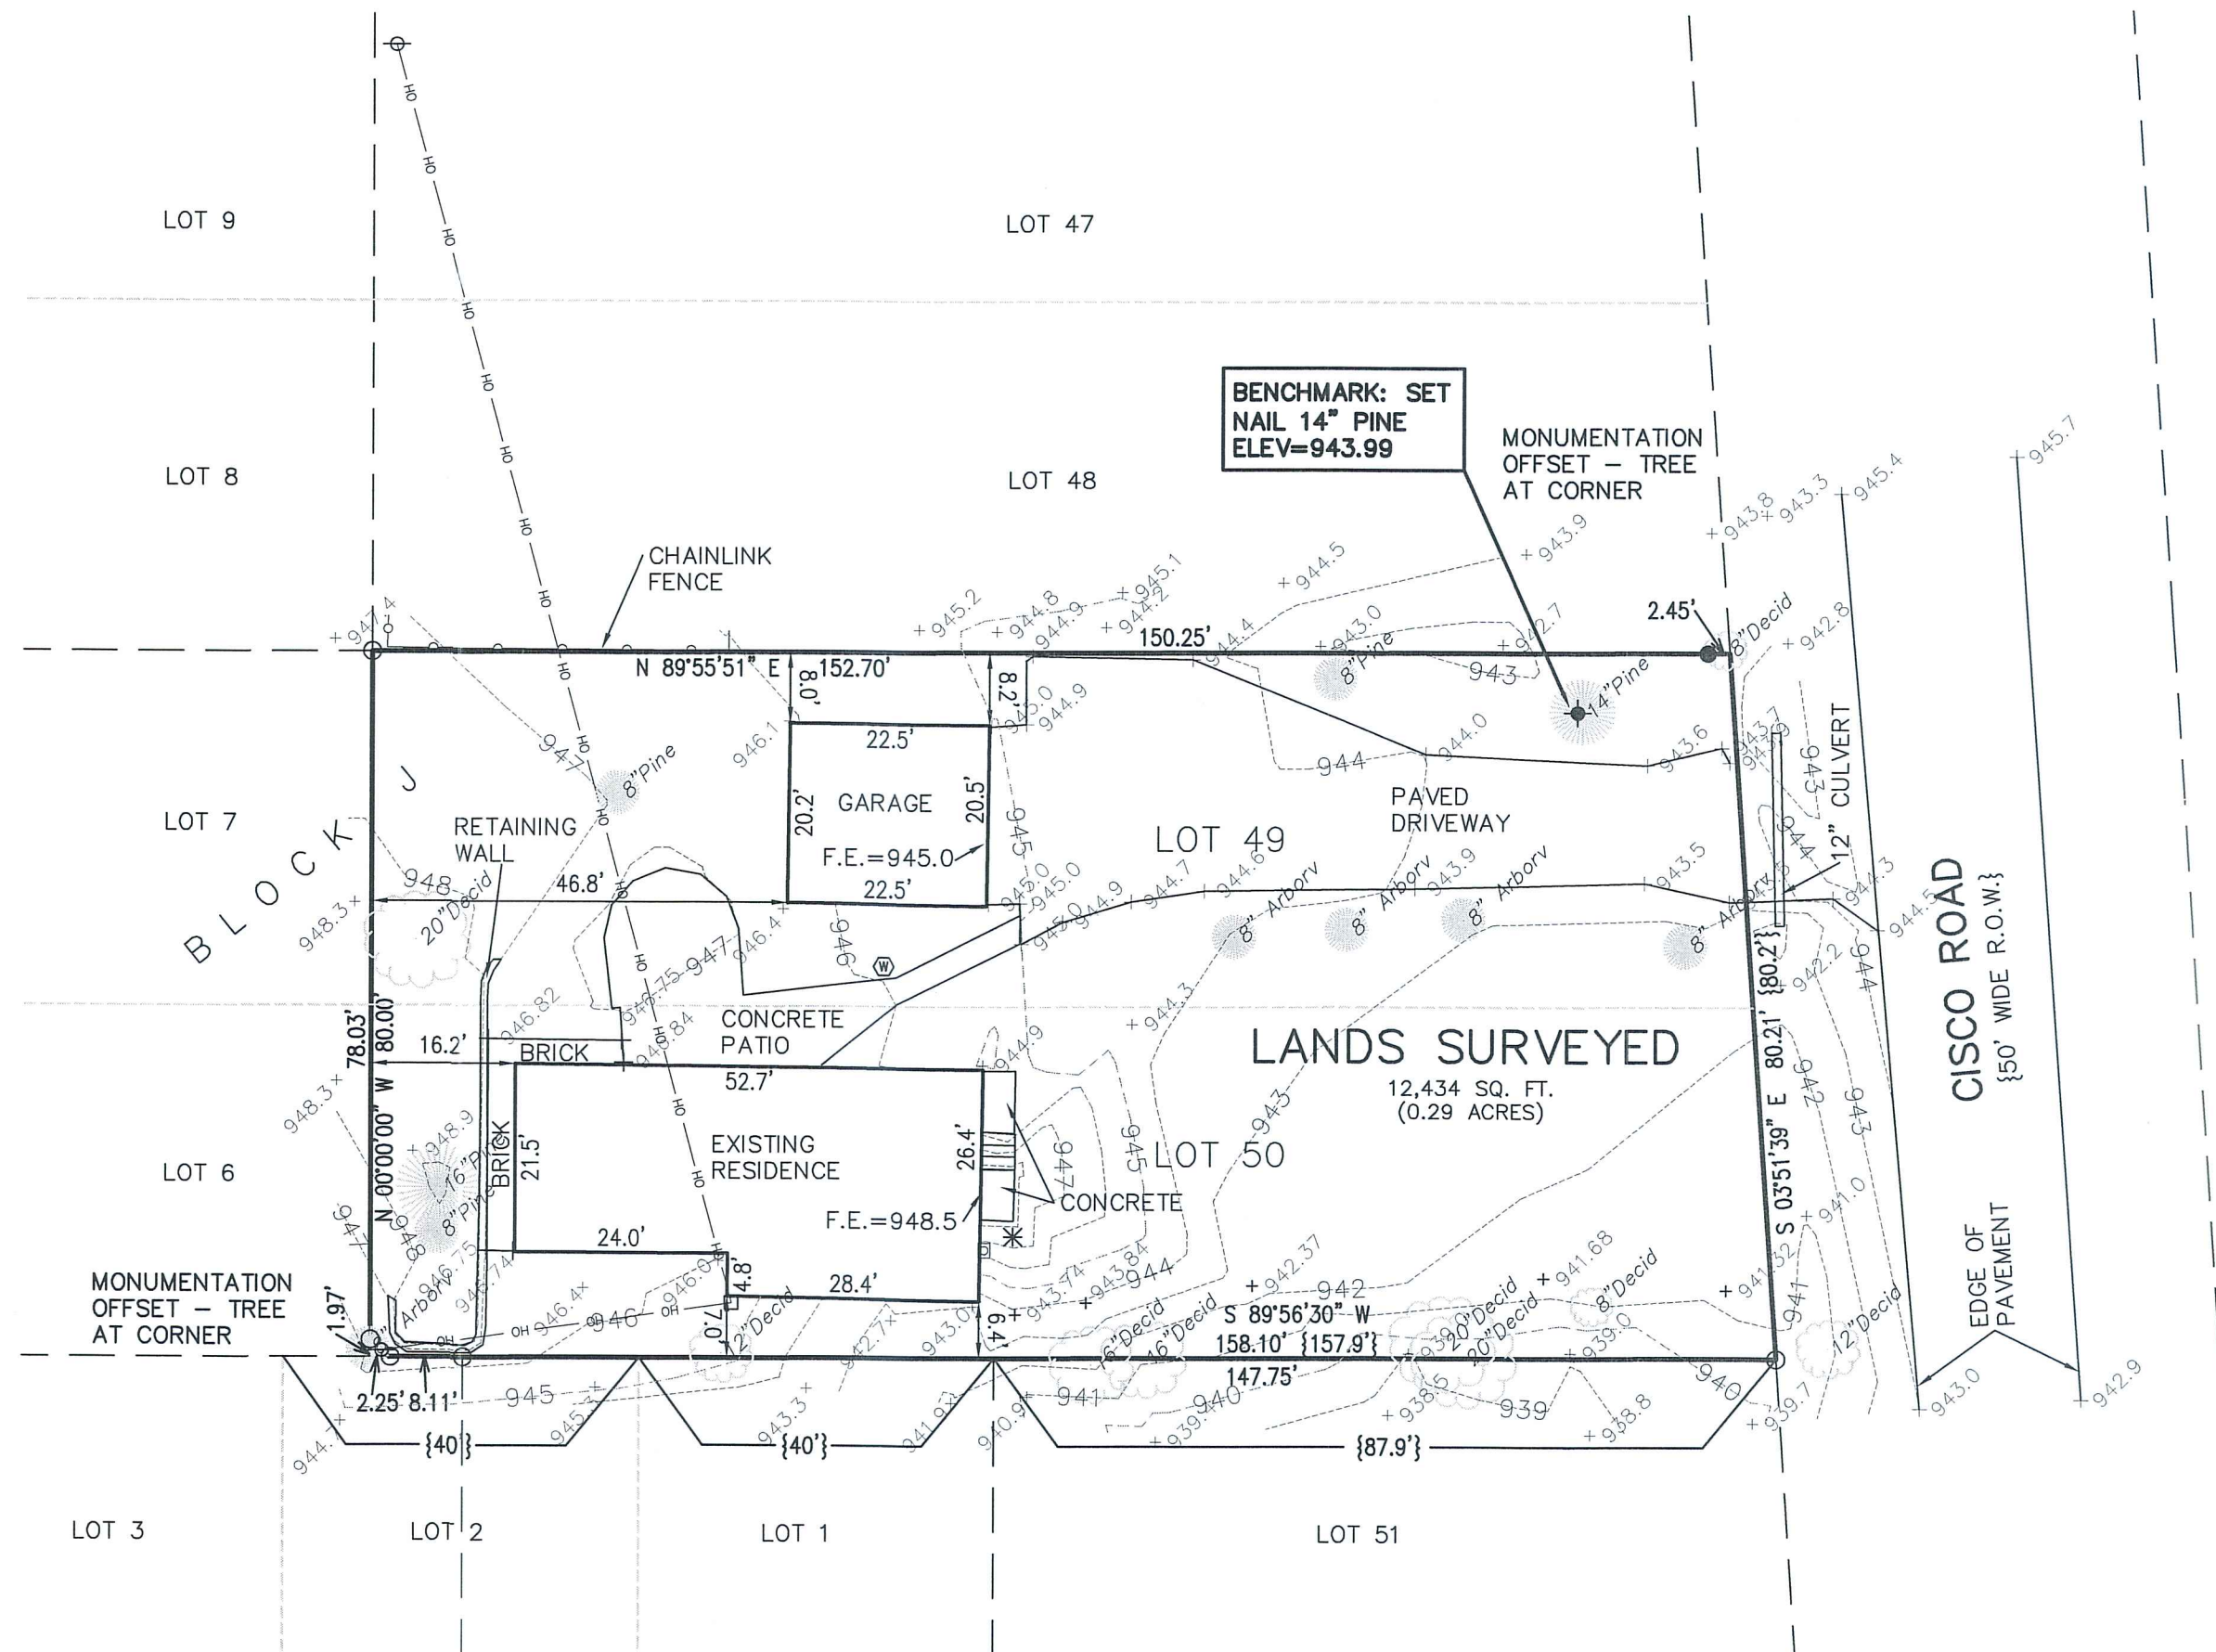

- LEGEND
- = FOUND IRON PIPE STAKE
 - = FOUND REBAR STAKE
 - ⊕ = WELL
 - = ELECTRIC METER
 - * = AIR CONDITIONING UNIT
 - ⊞ = GAS METER
 - ⊕ = UTILITY POLE
 - OH — = OVERHEAD WIRE
 - F.E. = FLOOR ELEVATION
 - +xxxx+ = EXISTING GROUND ELEVATION
 - XXXX--- = EXISTING LAND CONTOURS

MAP SCALE IN FEET - ORIGINAL 1"=20'



NOTE: COPIES OF THIS MAP TO WHICH THE FOLLOWING CERTIFICATE WILL APPLY SHOW THE SURVEYOR'S ORIGINAL SEAL AND SIGNATURE IN RED INK. COPIES BY ANY OTHER MEANS MAY HAVE ALTERATIONS WHICH DO NOT REPRESENT THE SURVEYOR'S WORK PRODUCT.

I HEREBY CERTIFY THAT THE ABOVE DESCRIBED PROPERTY HAS BEEN SURVEYED UNDER MY DIRECTION AND THAT THE ABOVE MAP IS A TRUE REPRESENTATION THEREOF AND SHOWS THE SIZE AND LOCATION OF THE PROPERTY AND ITS EXTERIOR BOUNDARIES. THIS SURVEY IS MADE FOR THE USE OF THE PRESENT OWNERS OF THE PROPERTY, AND ALSO THOSE WHO PURCHASE, MORTGAGE, OR GUARANTEE THE TITLE THERETO WITHIN ONE YEAR FROM THE DATE HEREOF.

DATED: 04/14/2021
CHRISTOPHER A. HODGES P.L.S. 2760



TOPOGRAPHIC SURVEY
N2433 CISCO ROAD
LAKE GENEVA, WI 53147

WORK ORDERED BY -
DAVE LIGMAN
N2433 CISCO ROAD
LAKE GENEVA, WI 53147

FARRIS, HANSEN & ASSOCIATES, INC.
ENGINEERING - ARCHITECTURE - SURVEYING
7 RIDGWAY COURT P.O. BOX 437
ELKHORN, WISCONSIN 53121
OFFICE: (262) 723-2098 FAX: (262) 723-5886

REVISIONS
04/14/2021 - LB
TOPO. SURVEY

PROJECT NO.
10424
DATE:
04/14/2021
SHEET NO.
1 OF 1