
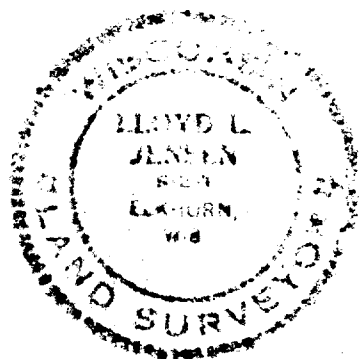


PLAT OF SURVEY

OF

LOTS 15, 16, 17, 18, 19, 20, 21, 22, 23 AND 24
BLOCK 4, LAKE GENEVA TERRACE, A
SUBDIVISION LOCATED IN SECTION 15,
T1N, R17E WALWORTH COUNTY, WISCONSIN

NW CORNER SECTION 15, T1N R17E

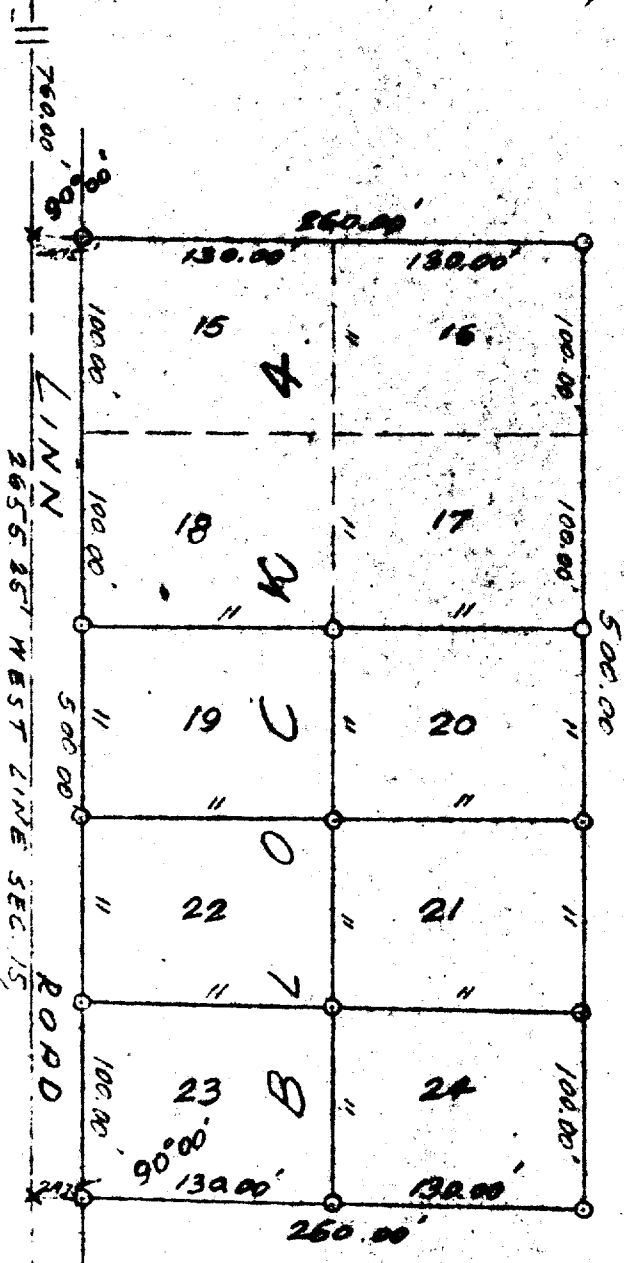

SURVEY AND PLAT BY

JENSEN & JOHNSON, INC.
CIVIL ENGINEERS AND SURVEYORS

Elkhorn, Wisconsin

LEGEND

- — Iron Pipe
- — Concrete Monument
- x — SPIKE
- Scale 1" = 100'

WE CERTIFY: That we have surveyed the above described property and that the plat shown hereon is an accurate survey and a true representation thereof and correctly shows the exterior boundary lines and all divisions of said property.

Date MAY 14, 1974

Lloyd L. Jensen
LLOYD L. JENSEN,

Wisconsin Registered Land Surveyor, No. S-211