
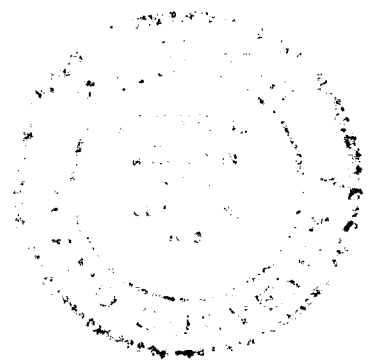
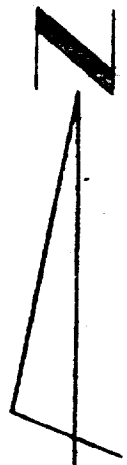


PLAT OF SURVEY

OF

LOTS 58 AND 59 BLOCK 2 LAKEVIEW PARK,
A SUBDIVISION LOCATED IN SECTION 16, T1N,
R17E WALWORTH COUNTY, WISCONSIN

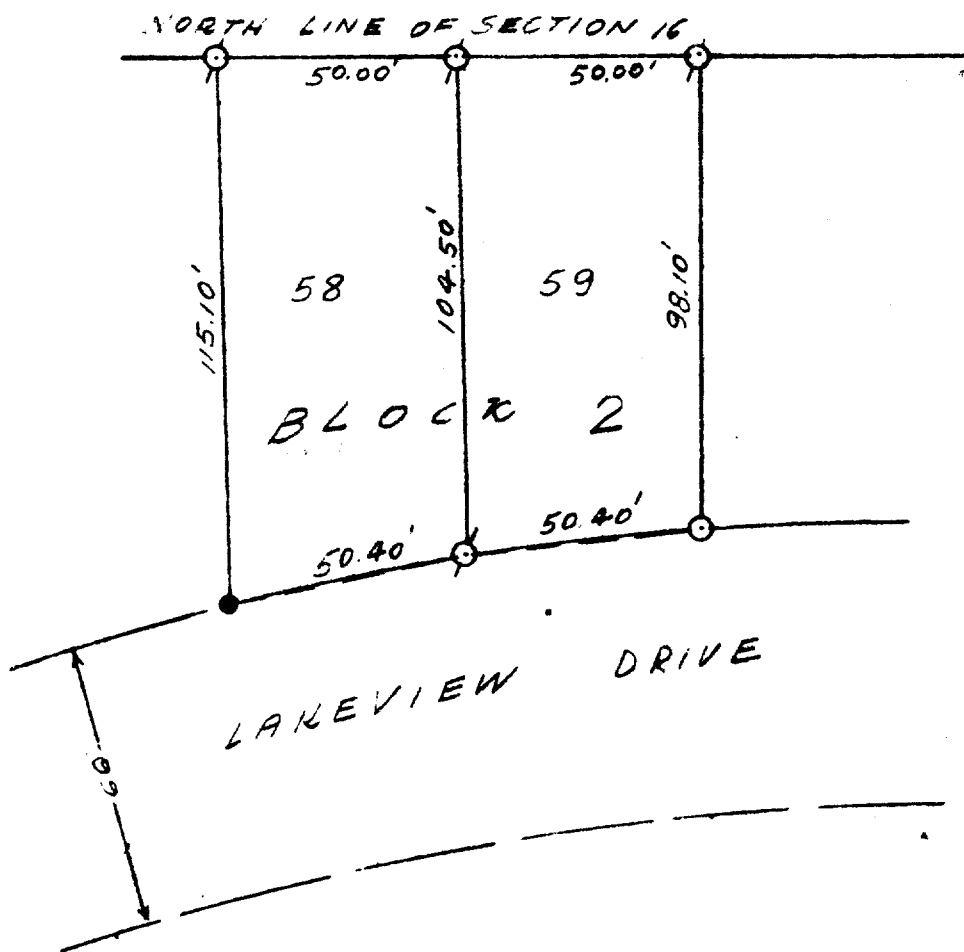

SURVEY AND PLAT BY

JENSEN & JOHNSON, INC.
CIVIL ENGINEERS AND SURVEYORS

Elkhorn, Wisconsin

LEGEND

- — Iron Pipe SET FOUND IN
- — SET IRON PIPE
- — Concrete Monument

Scale 1" = 40'

WE CERTIFY: That we have surveyed the above described property and that the plat shown hereon is an accurate survey and a true representation thereof and correctly shows the exterior boundary lines and all divisions of said property.

Date May 16 1974

Lloyd L. Jensen
LLOYD L. JENSEN,

Wisconsin Registered Land Surveyor, No. S-211

ILWP-11A