


LEGEND

- = IRON PIPE FOUND
- = IRON PIPE SET
- ⊙ = POSEY PIN FOUND AND REPLACED WITH IRON PIPE
- △ = POSEY PIN FOUND

NOTE:
A "POSEY PIN" IS AN IRON STAKE OF THE SAME TYPE
OFTEN USED BY SURVEYOR GEORGE W. POSEY

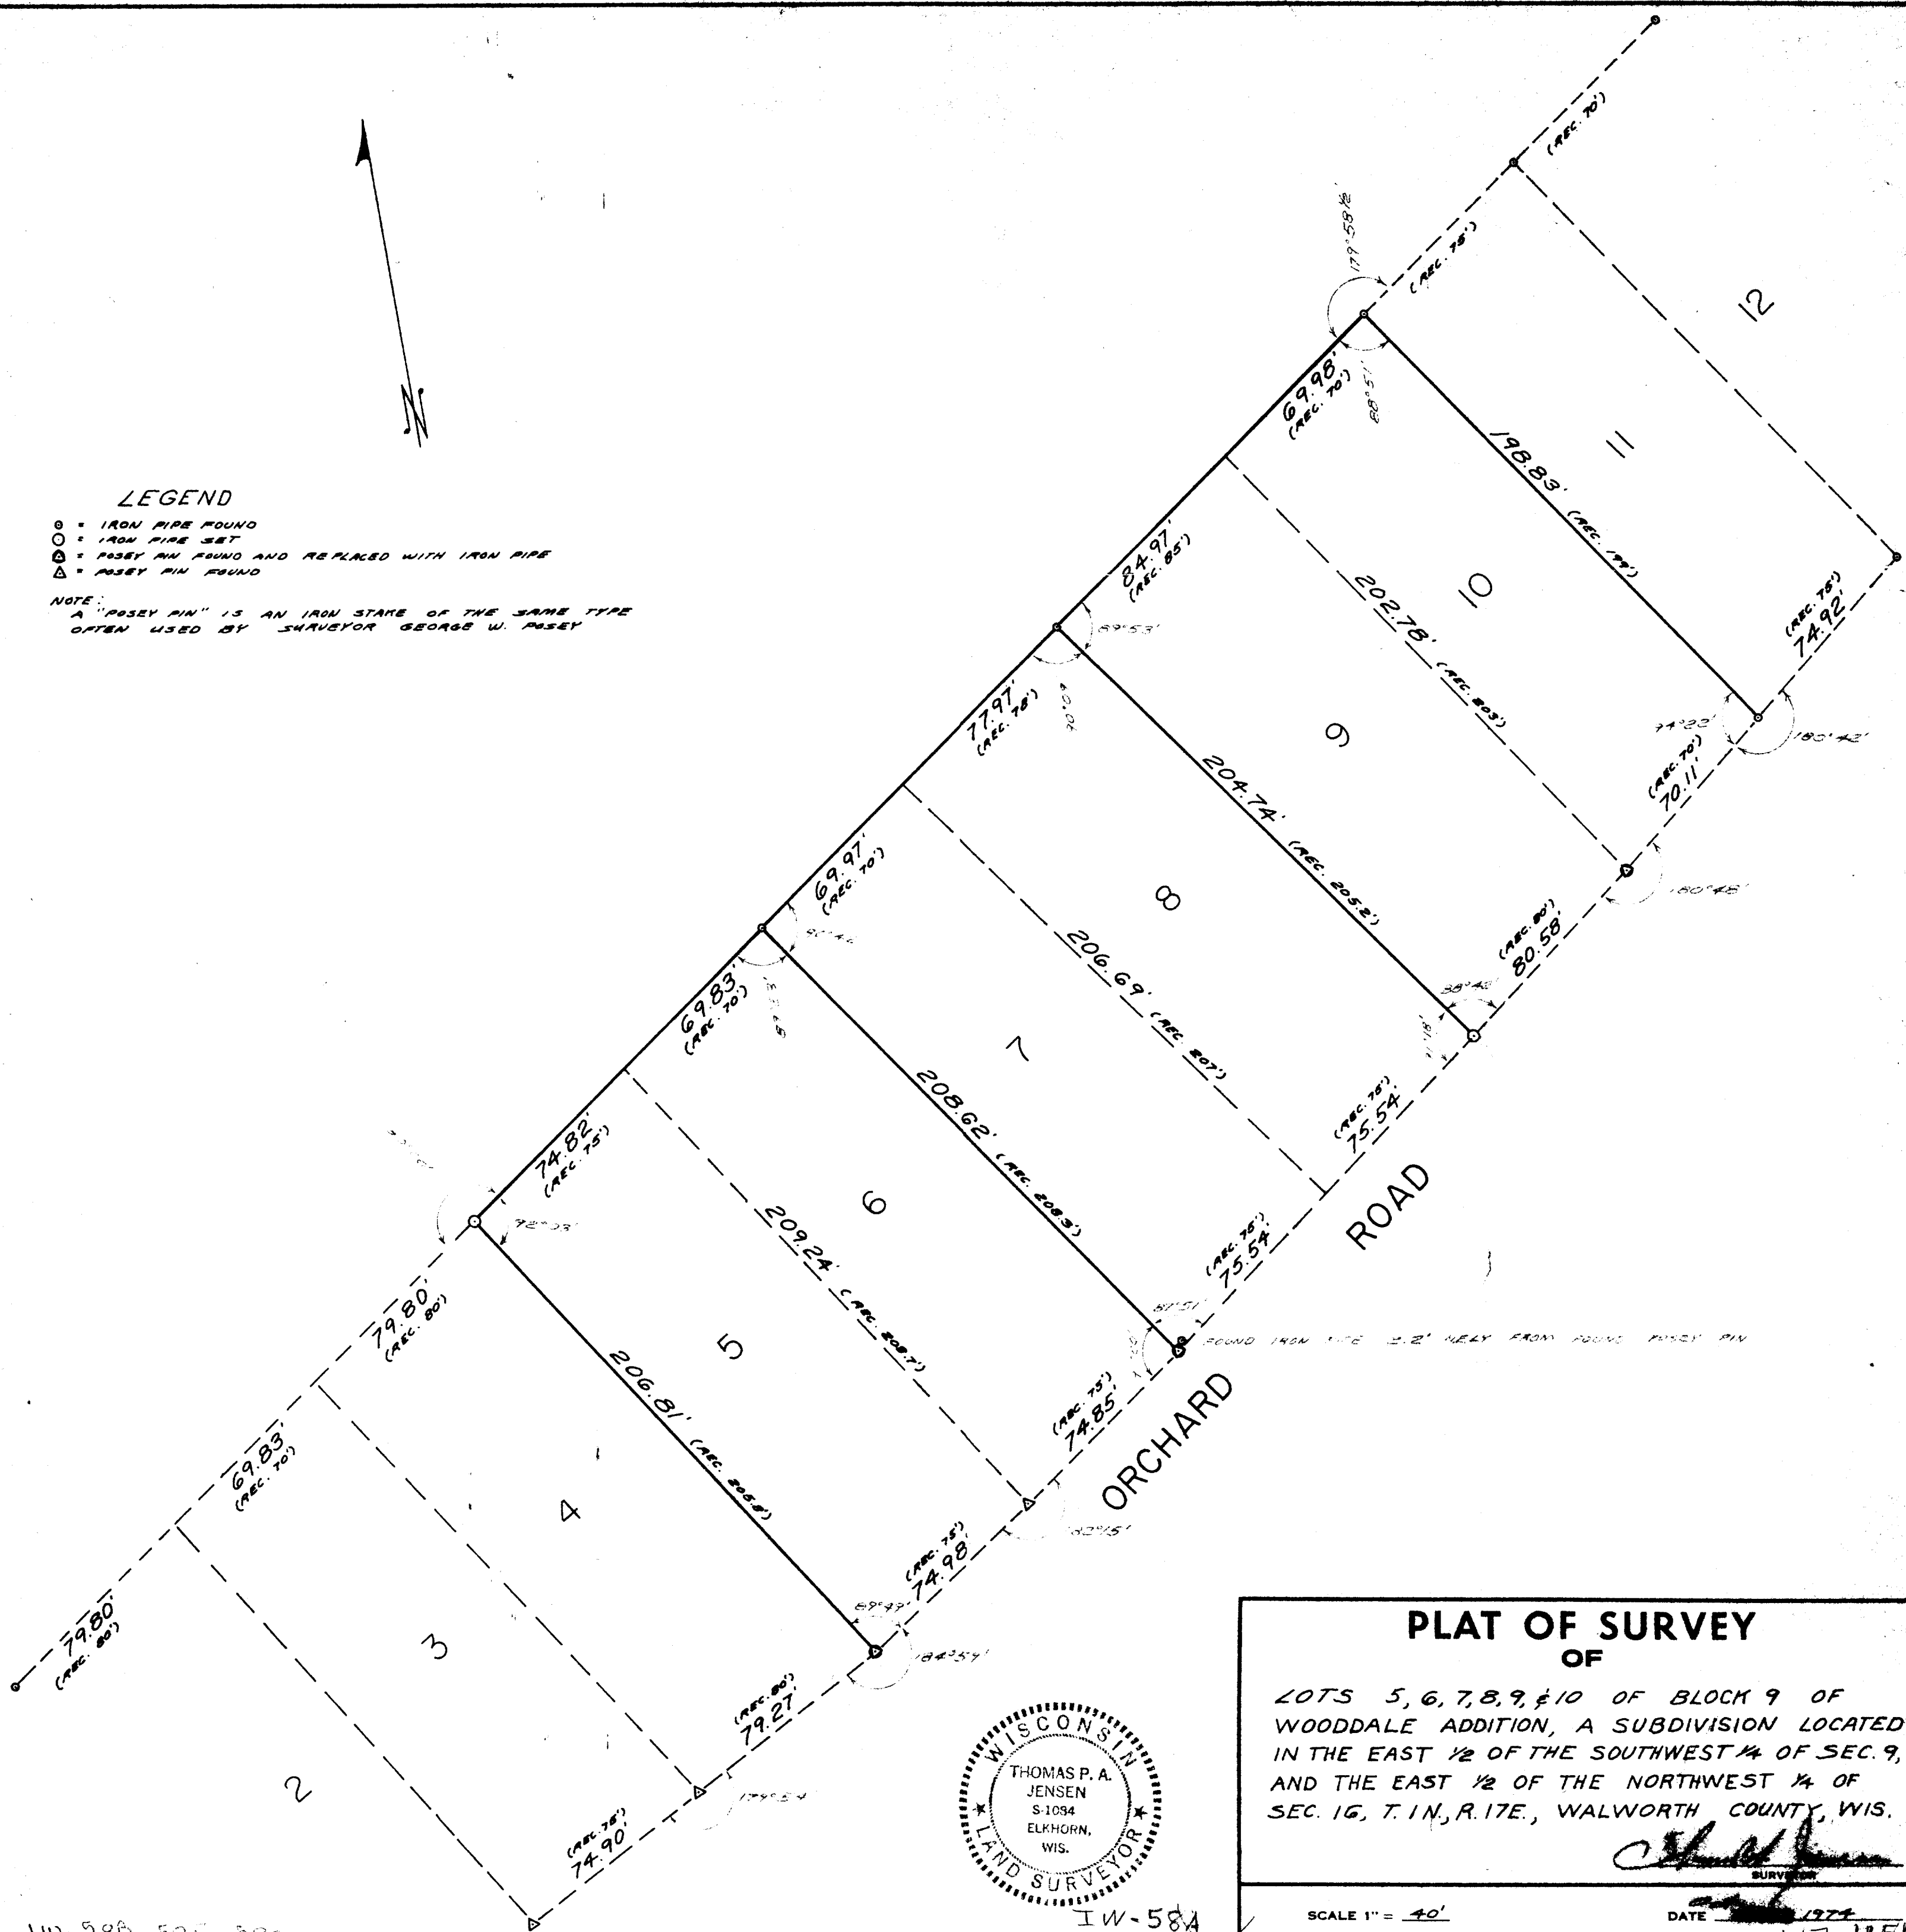

PLAT OF SURVEY OF

LOTS 5, 6, 7, 8, 9, & 10 OF BLOCK 9 OF
WOODDALE ADDITION, A SUBDIVISION LOCATED
IN THE EAST 1/2 OF THE SOUTHWEST 1/4 OF SEC. 9,
AND THE EAST 1/2 OF THE NORTHWEST 1/4 OF
SEC. 16, T. 1 N., R. 17 E., WALWORTH COUNTY, WIS.

Thomas P. A. Jensen
SURVEYOR

SCALE 1" = 40'

DATE 1974

117-454 J