

PLAT OF SURVEY

A PARCEL OF LAND LOCATED IN THE SOUTHEAST 1/4 OF THE NORTHWEST 1/4 AND THE NORTHEAST 1/4 OF THE SOUTHWEST 1/4 OF SECTION 9 IN TOWNSHIP 1 NORTH, RANGE 17 EAST, IN THE TOWN OF LINN, WALWORTH COUNTY, WISCONSIN.

LEGAL DESCRIPTION PER DEED AS:


THE EAST 10' OF LOT 10, BLOCK 1, WOODDALE ADDITION, SITUATE IN THE TOWN OF LINN, WALWORTH COUNTY, WISCONSIN, ALSO, LOT 11 OF BLOCK 1, OF THE SAME SUBDIVISION, EXCEPT A STRIP ON THE EAST END WHICH IS DESCRIBED AS FOLLOWS: STARTING AT THE SOUTHEAST CORNER OF SAID LOT 11, RUN THENCE NORTHERLY ALONG THE EAST LINE OF LOT 11, 185.2' TO THE LOW WATER MARK OF GENEVA LAKE; THENCE WESTERLY ALONG THE SHORE OF GENEVA LAKE, A DISTANCE OF 30' TO AN IRON STAKE; THENCE 180' SOUTHERLY TO AN IRON STAKE SET IN THE SOUTH LINE OF LOT 11, AND 15' WESTERLY FROM THE SOUTHEAST CORNER OF LOT 11; THENCE EASTERLY ALONG THE SOUTHERLY LINE OF LOT 11, 15 FEET TO THE PLACE OF BEGINNING.



0 20 40
SCALE: 1=20' Feet

LEGEND

●	FOUND 1" IRON PIPE
[E]	ELECTRICAL BOX
[P]	POWER POLE
[S]	SEPTIC VALVE
[B]	EXISTING BUILDING
[C]	CONCRETE DRIVE
[P]	CONCRETE PAVERS
[G]	GRAVEL PATH
(XX)	RECORDED AS
[T]	TREE

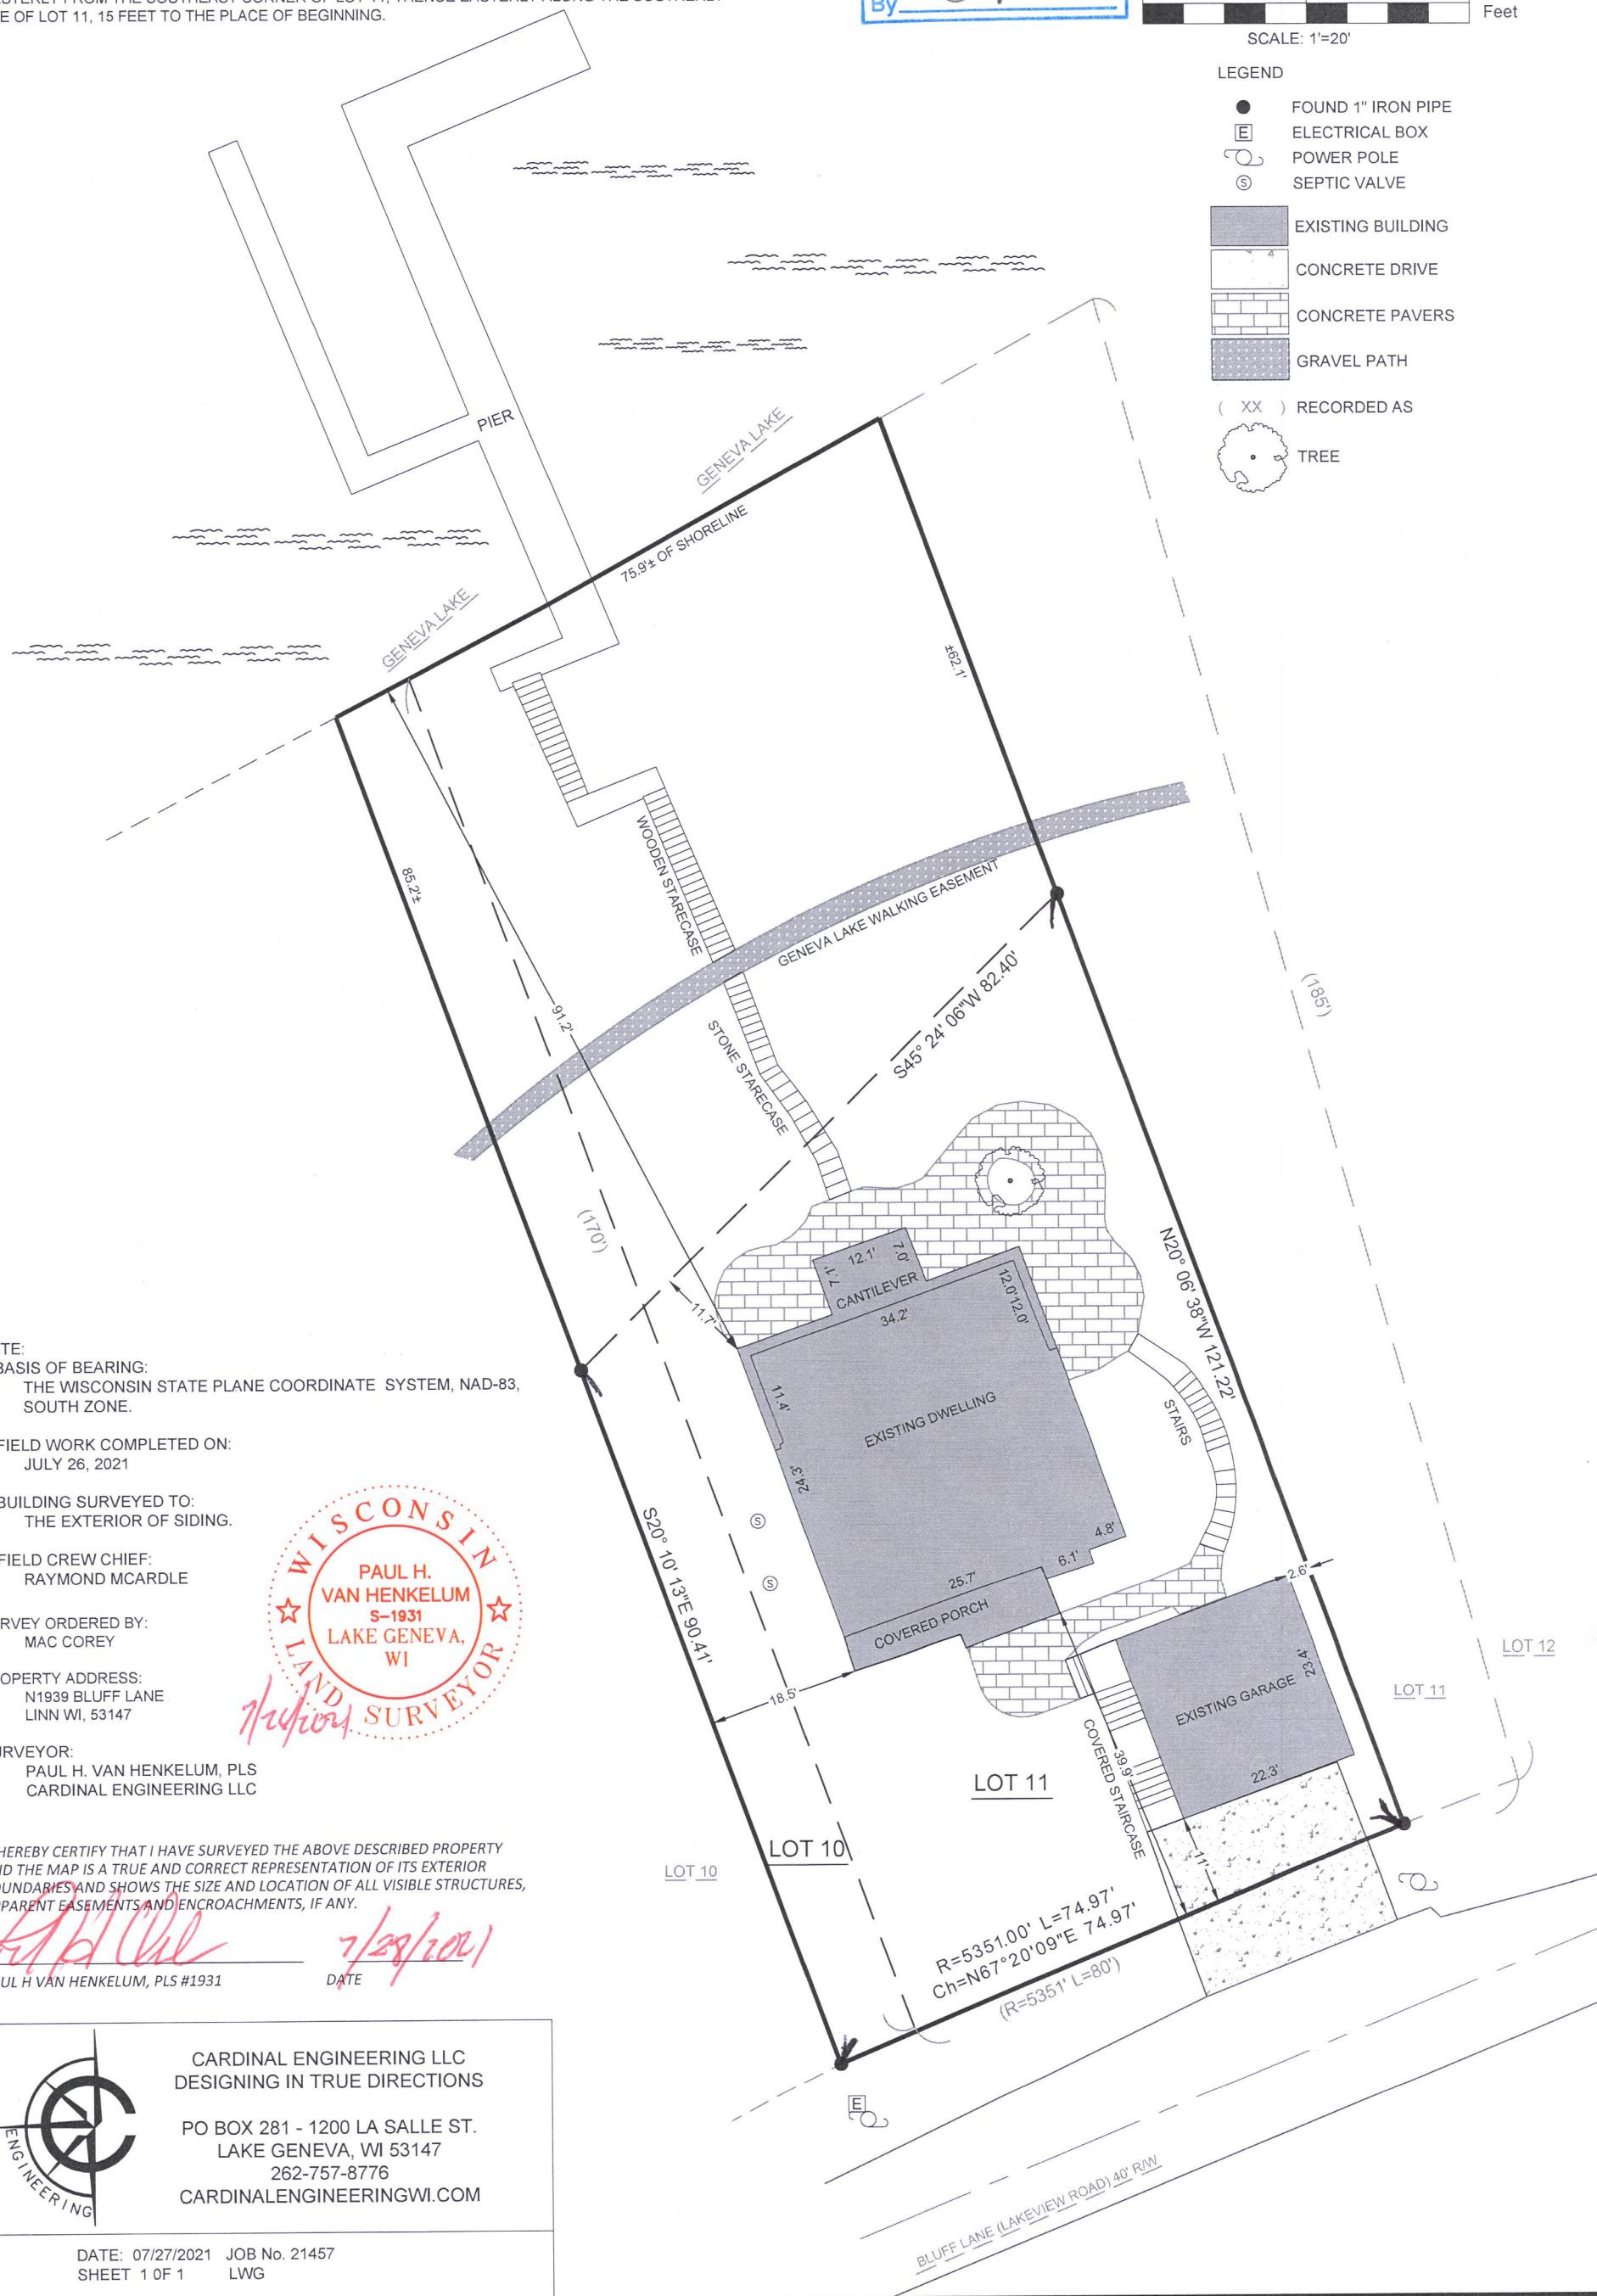

IW-14

117-4544