

EXHIBIT

EXHIBIT OF BOTH LOT 1 AND OUTLOT 1 OF THE SYLVAN TRAIL ESTATES.




SCALE: 1"=40'

LEGEND

- FOUND 1" IRON PIPE
- FOUND IRON ROD
- △ FOUND MAGNAIL
- ⊕ UTILITY POLE
- EXISTING BUILDING
- EXISTING DECK
- EXISTING CONCRETE
- EXISTING BRICK PAVERS
- EXISTING ASPHALT DRIVE
- (XX) RECORDED AS
- xc EXISTING WIRE FENCE
- EXISTING TREE LINE



- NOTE:
1. BASIS OF BEARING:
THE WISCONSIN STATE PLANE COORDINATE SYSTEM, NAD-83, SOUTH ZONE.
 2. FIELD WORK COMPLETED:
JULY 12, 2021
 3. BUILDING SURVEYED TO:
THE EXTERIOR OF SIDING.
 4. FIELD CREW CHIEF:
RAYMOND MCARDLE
- SURVEY ORDERED BY:
BOB WEBSTER
- PROPERTY ADDRESS:
W4237 ORIOLE DRIVE
OUTLOT 1
LAKE GENEVA WI, 53147
- SURVEYOR:
PAUL H. VAN HENKELUM, PLS
CARDINAL ENGINEERING LLC

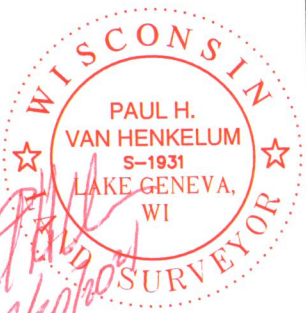

CARDINAL ENGINEERING LLC
DESIGNING IN TRUE DIRECTIONS
PO BOX 281 - 1200 LA SALLE ST.
LAKE GENEVA, WI 53147
262-757-8776
CARDINALENGINEERINGWI.COM

DATE: 20/07/2021 JOB No. 21451
SHEET 1 OF 1 LWG

IA 675-1 IA 675-4

117-8547