


PLAT OF SURVEY

A PARCEL OF LAND LOCATED IN THE NORTHWEST 1/4 OF THE NORTHEAST 1/4 OF SECTION 5 IN TOWNSHIP 1 NORTH, RANGE 17 EAST, IN THE TOWN OF LINN, WALWORTH COUNTY, WISCONSIN.

MORE PARTICULARLY DESCRIBED AS:
LOT 36, BLOCK C OF THE CISCO BEACH SUBDIVISION AS RECORDED IN DOCUMENT NO. P259331 PER THE WALWORTH COUNTY REGISTER OF DEEDS.

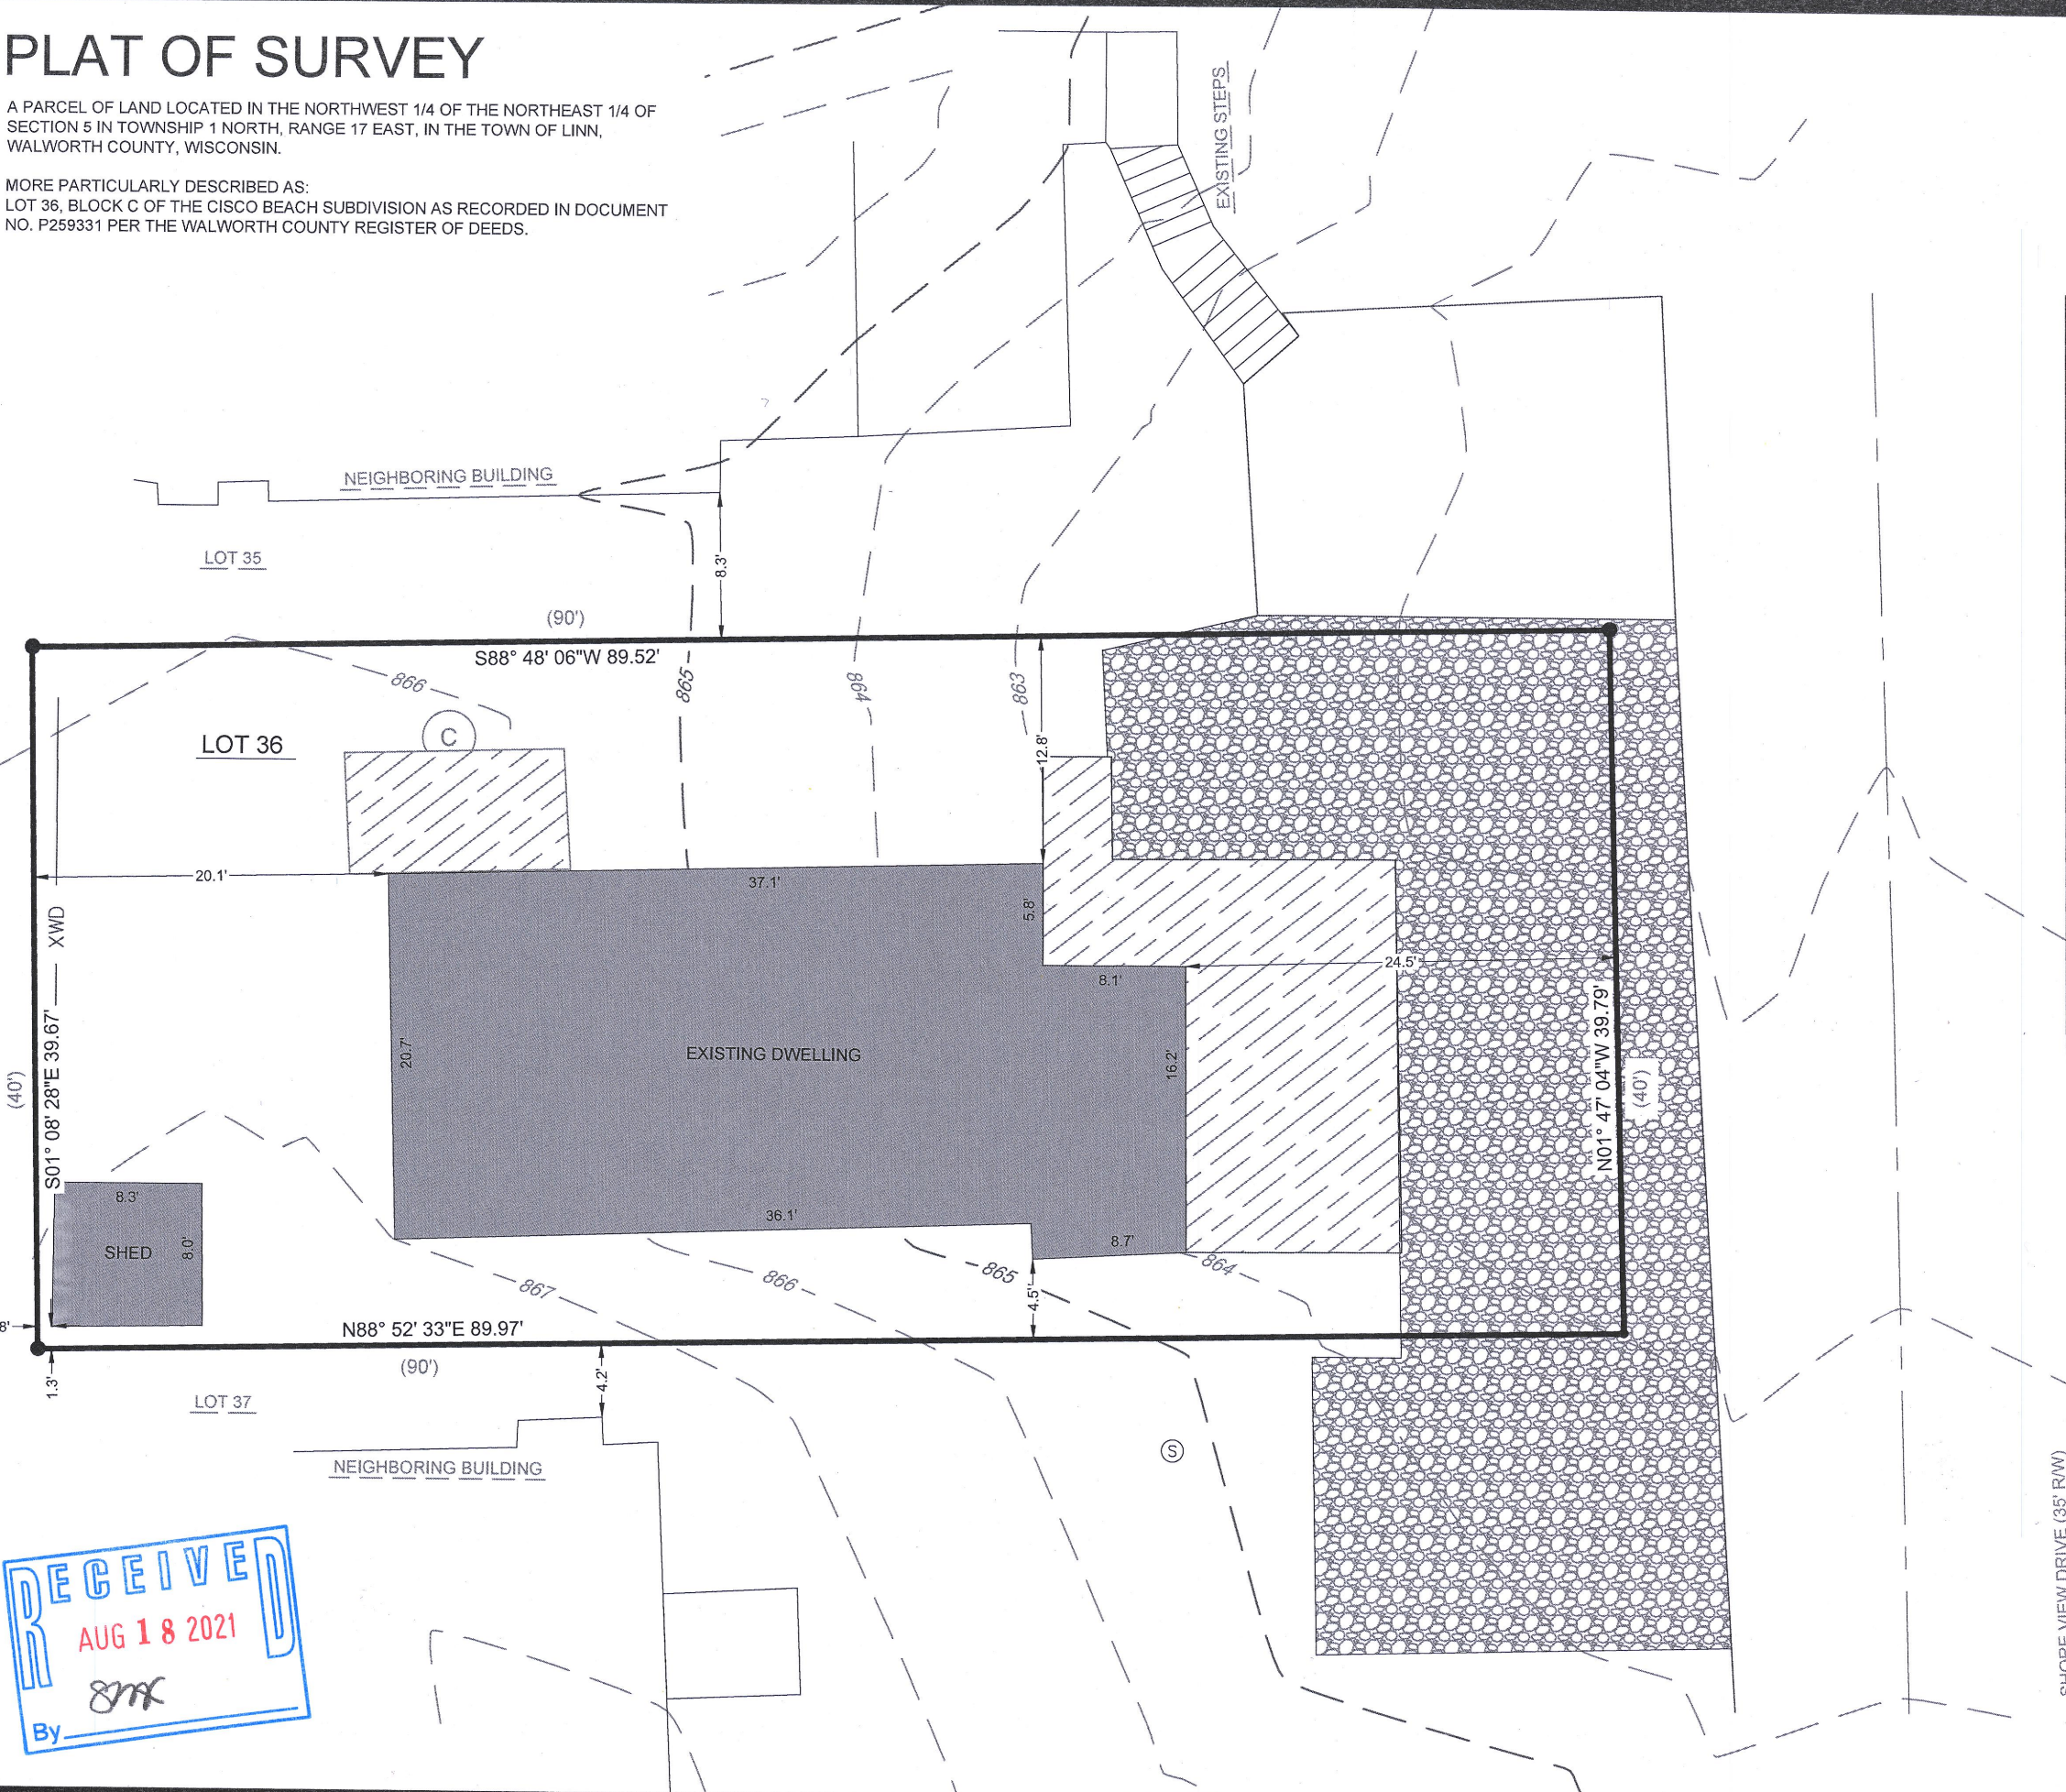

LEGEND

●	FOUND 1" IRON PIPE	EXISTING BUILDING
●	FOUND IRON ROD	EXISTING DECK
(C)	4' CONCRETE LID	EXISTING GRAVEL
(S)	SEPTIC VENT	WOOD FENCE
(XX)	RECORDED AS	

NOTE:
1. BASIS OF BEARING:
THE WISCONSIN STATE PLANE COORDINATE SYSTEM, NAD-83, SOUTH ZONE.

2. FIELD WORK COMPLETED:
AUGUST 4, 2021

3. BUILDING SURVEYED TO:
THE EXTERIOR OF SIDING.

4. FIELD CREW CHIEF:
RAYMOND MCARDLE

5. THRESHOLD ELEVATION:
867.84

SURVEY ORDERED BY:
WHITNEY MILLS

PROPERTY ADDRESS:
N2405 SHORE VIEW DRIVE
LAKE GENEVA WI, 53147

SURVEYOR:
PAUL H. VAN HENKELUM, PLS
CARDINAL ENGINEERING LLC

"I HEREBY CERTIFY THAT I HAVE SURVEYED THE ABOVE DESCRIBED PROPERTY AND THE MAP IS A TRUE AND CORRECT REPRESENTATION OF ITS EXTERIOR BOUNDARIES AND SHOWS THE SIZE AND LOCATION OF ALL VISIBLE STRUCTURES, APPARENT EASEMENTS AND ENCROACHMENTS, IF ANY."

Paul H. Van Henkelum
PAUL H VAN HENKELUM, PLS #1931




8/9/2021
DATE



CARDINAL ENGINEERING LLC
DESIGNING IN TRUE DIRECTIONS
PO BOX 281 - 1200 LA SALLE ST.
LAKE GENEVA, WI 53147
262-757-8776
CARDINALENGINEERINGWI.COM

DATE: 08/06/2021
SHEET 1 OF 1

JOB No. 21464
LWG

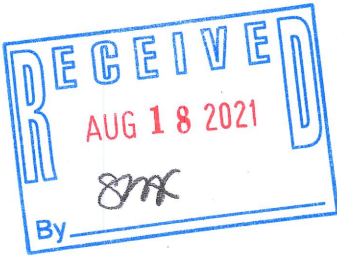

117-4548