



NOTE: REFER TO A CURRENT TITLE REPORT FOR
EASEMENTS, RESTRICTIONS OR COVENANTS WHICH
MAY AFFECT THIS PROPERTY.

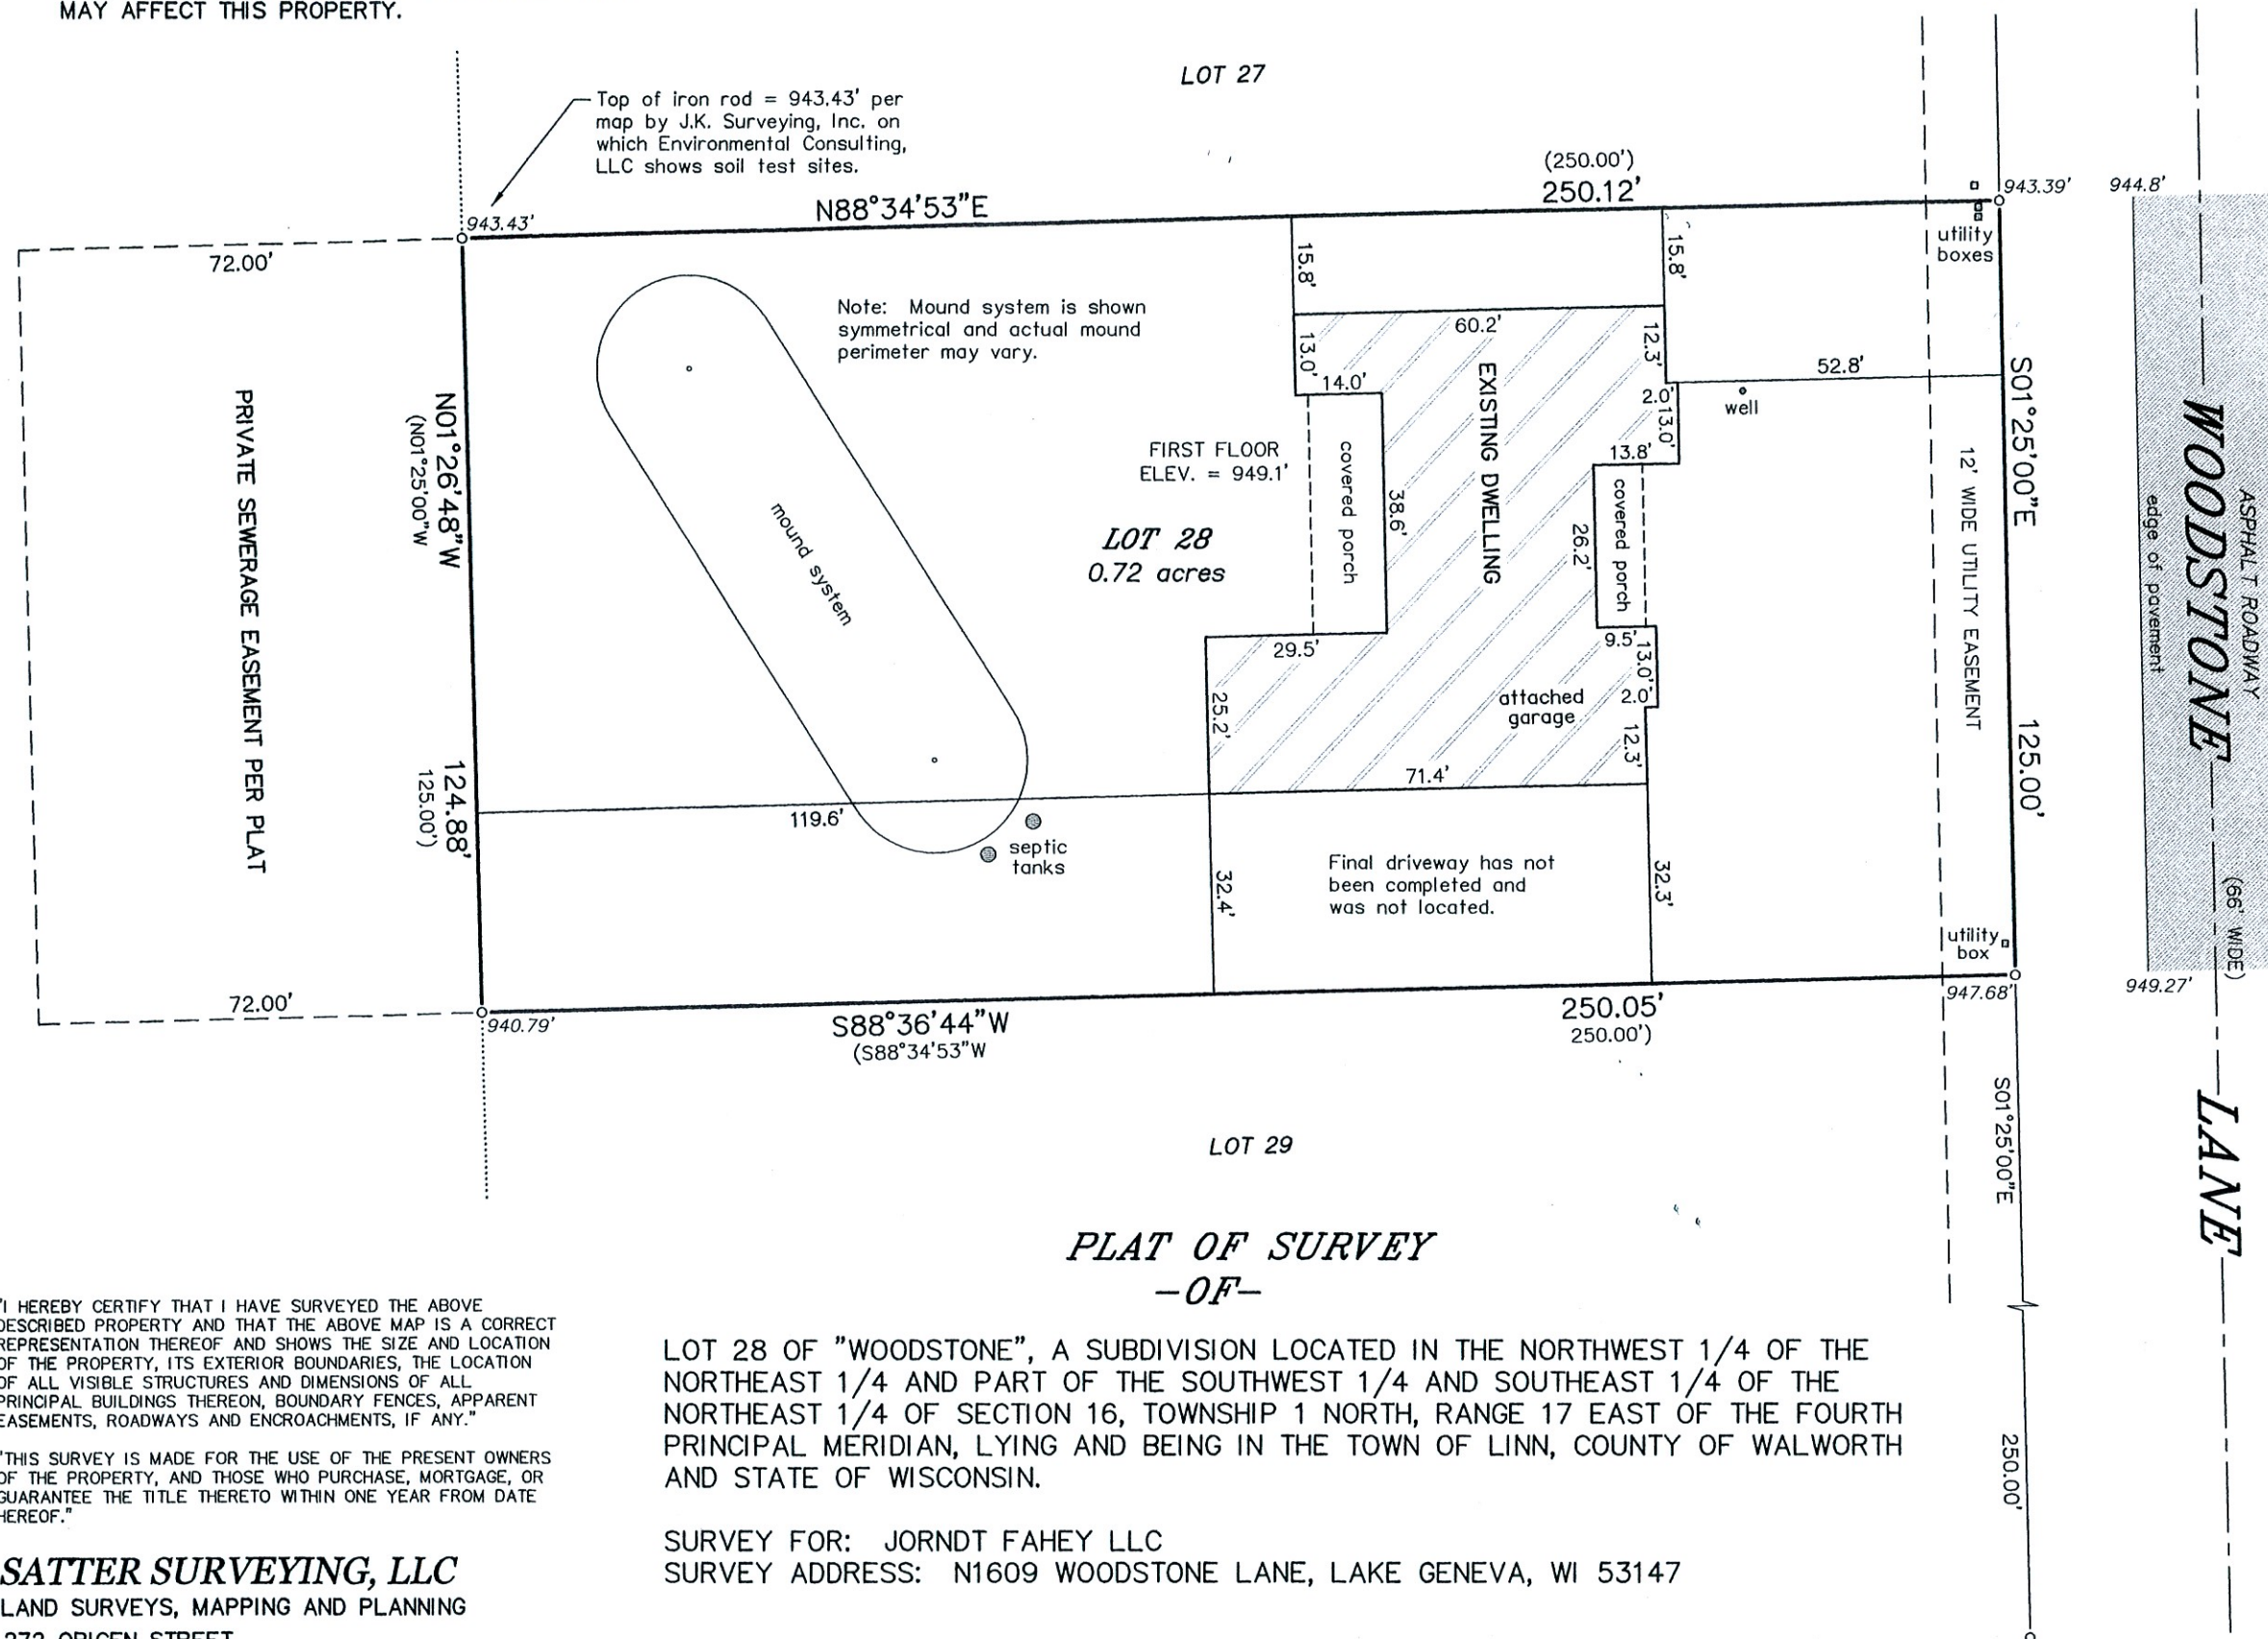

LEGEND

- o FOUND IRON ROD
() RECORDED AS
945.0' EXISTING ELEVATION

BEARINGS HEREON RELATE TO THE
WEST RIGHT-OF-WAY LINE OF
WOODSTONE LANE. ASSUMED BEARING
OF SOUTH 01°25'00" EAST AS PLATTED.

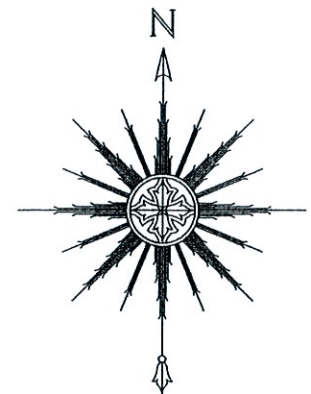

SCALE: 1" = 30'



THIS IS NOT AN ORIGINAL PRINT
UNLESS THIS SEAL IS RED.

Thomas L. Satter

THOMAS L. SATTER S-2850

REVISÉD: 10/25/2021

REVISÉ: 11/24/2020

OCTOBER 22, 2020

DATE _____

082014

JOB NUMBER