



BEARINGS HEREON RELATE TO THE NORTH LINE OF THE SURVEYED PROPERTY. ASSUMED BEARING OF NORTH 87°20'10" EAST TO ORIENTATE WITH A PREVIOUS SURVEY BY KROTT SURVEYING INC. DATED MAY 27, 2011 OF LOTS 6-7 AND 80-83 IN BLOCK 4 OF LAKEVIEW PARK SUBDIVISION.

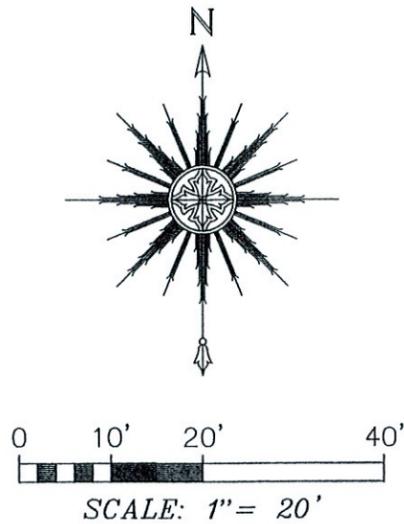

LEGEND

- FOUND 1-5/16" O.D. IRON PIPE
- ∕ FOUND 1" O.D. IRON PIPE
- FOUND 5/8" DIA. IRON ROD
- () RECORDED AS
- 100.0 EXISTING ELEVATION

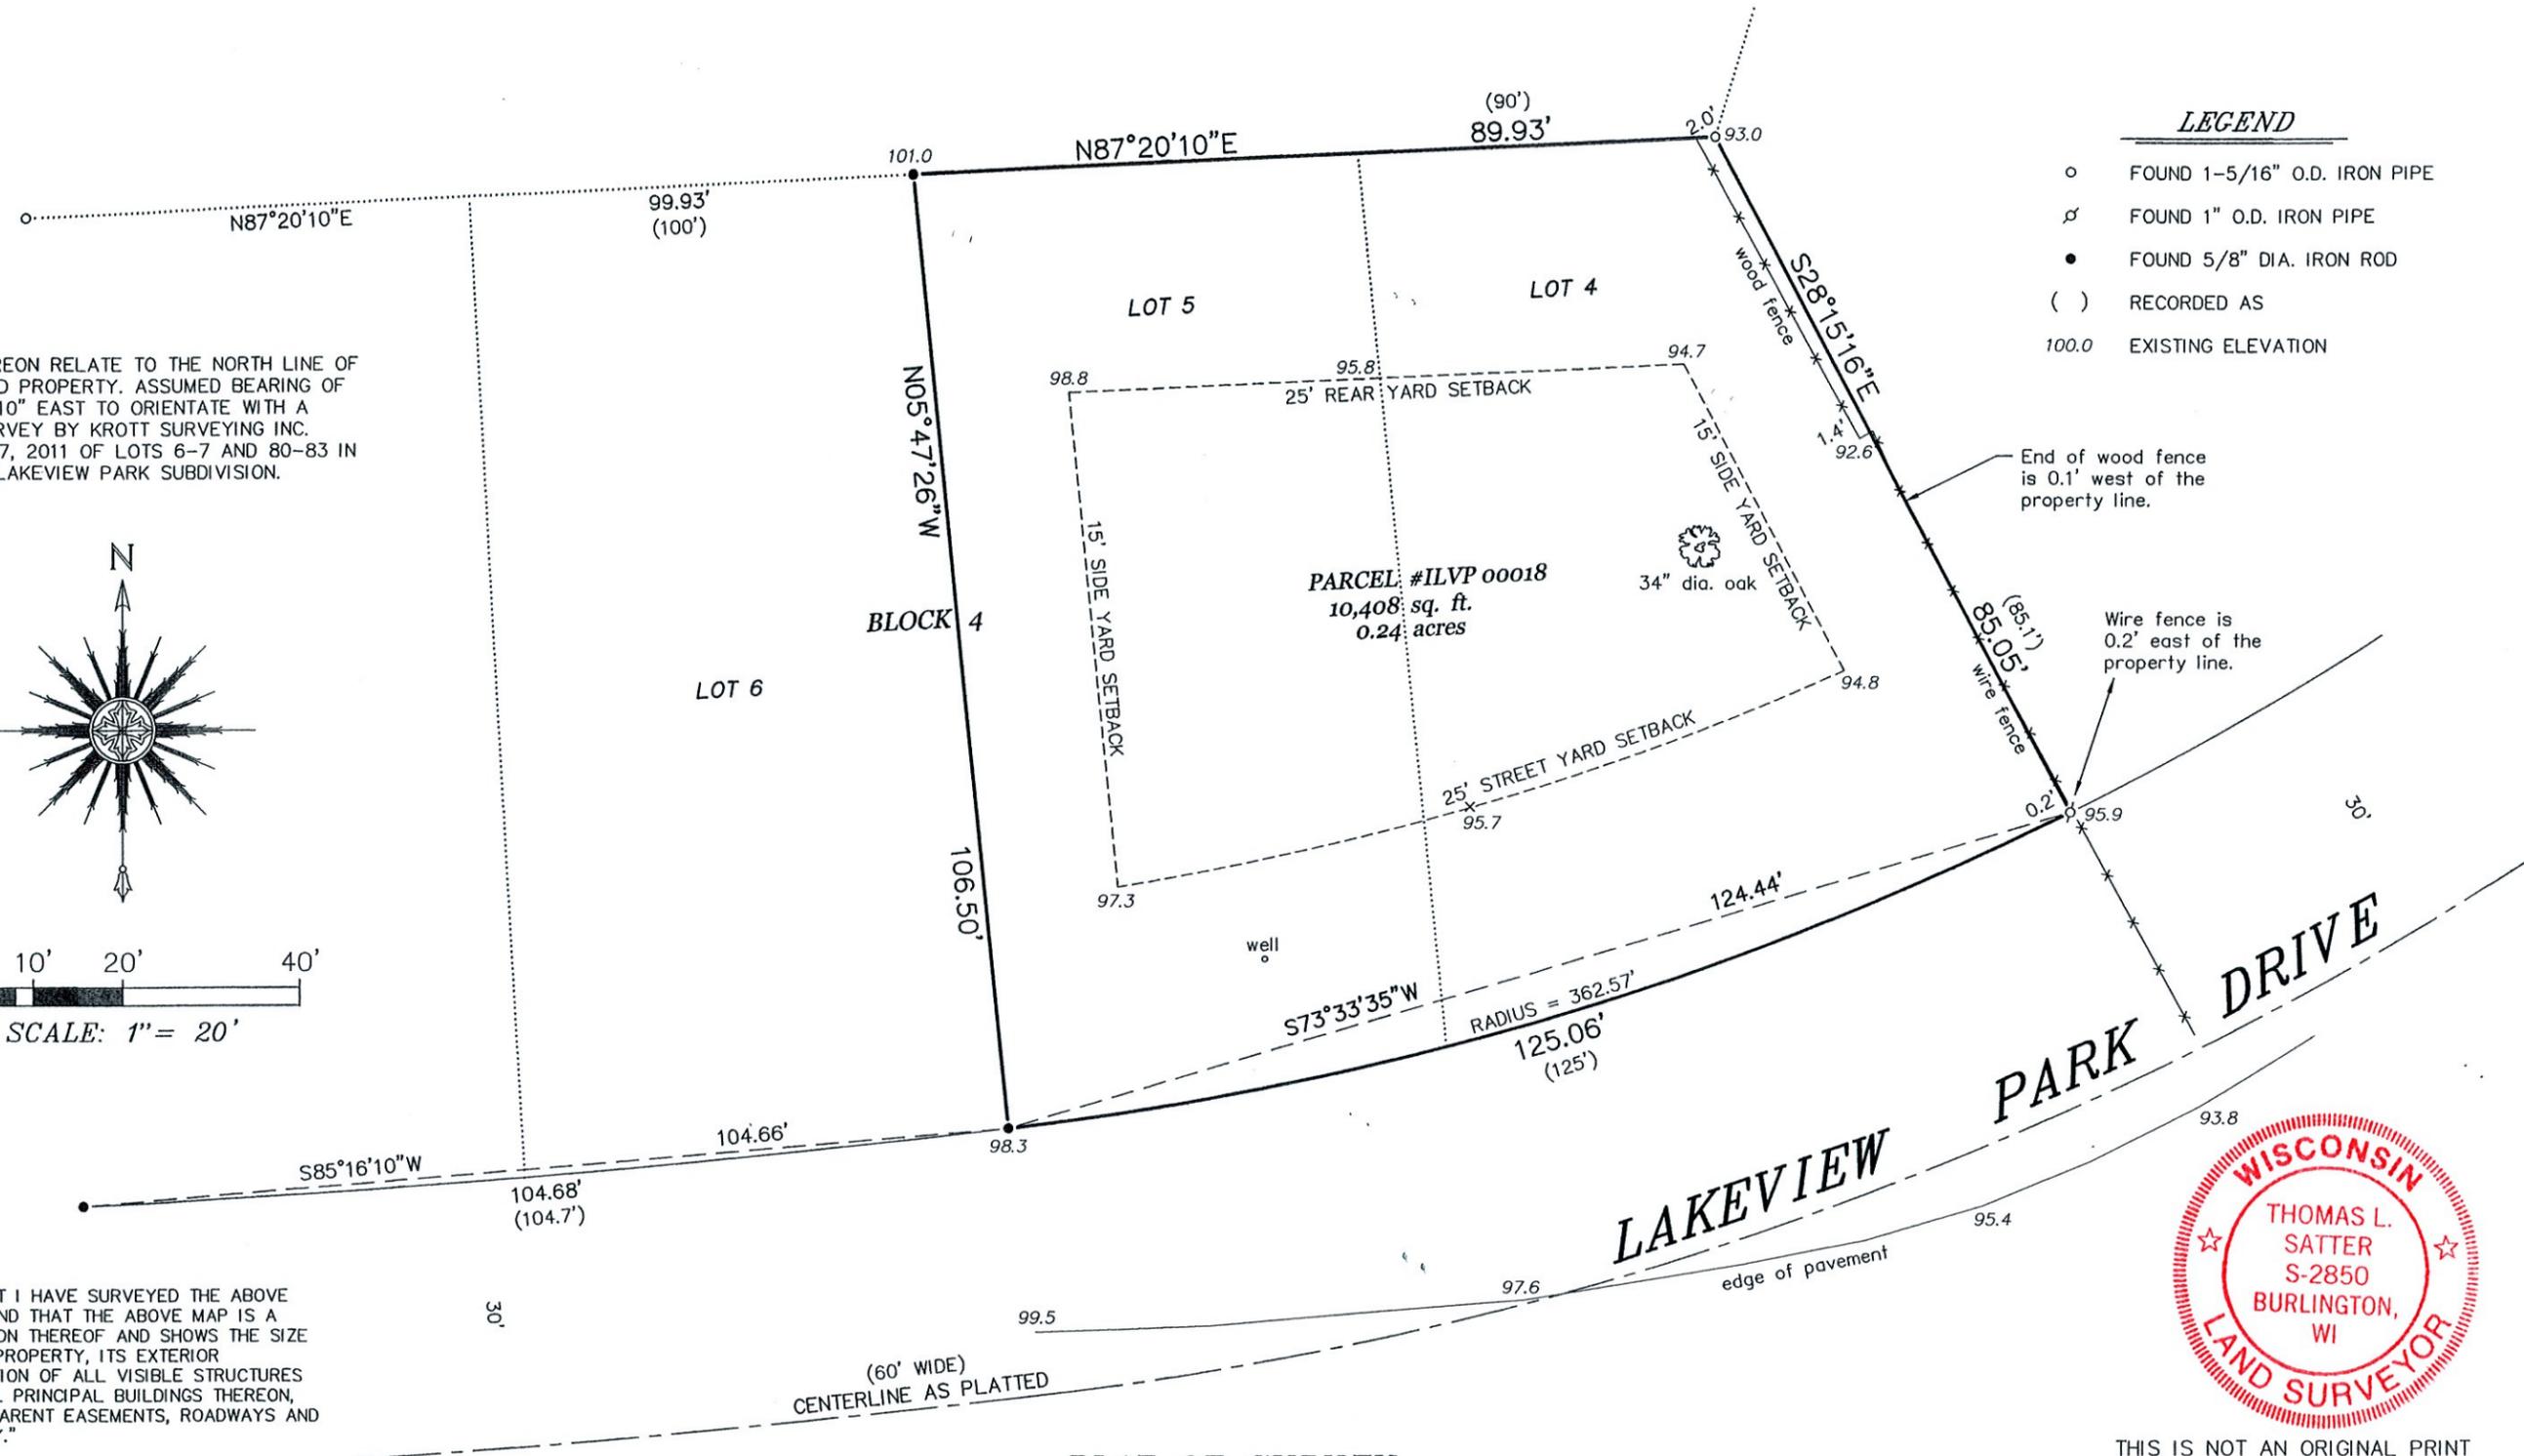

"I HEREBY CERTIFY THAT I HAVE SURVEYED THE ABOVE DESCRIBED PROPERTY AND THAT THE ABOVE MAP IS A CORRECT REPRESENTATION THEREOF AND SHOWS THE SIZE AND LOCATION OF THE PROPERTY, ITS EXTERIOR BOUNDARIES, THE LOCATION OF ALL VISIBLE STRUCTURES AND DIMENSIONS OF ALL PRINCIPAL BUILDINGS THEREON, BOUNDARY FENCES, APPARENT EASEMENTS, ROADWAYS AND ENCROACHMENTS, IF ANY."


"THIS SURVEY IS MADE FOR THE USE OF THE PRESENT OWNERS OF THE PROPERTY, AND THOSE WHO PURCHASE, MORTGAGE, OR GUARANTEE THE TITLE THERETO WITHIN ONE YEAR FROM DATE HEREOF."

SATTER SURVEYING, LLC
 LAND SURVEYS, MAPPING AND PLANNING
 272 ORIGEN STREET
 BURLINGTON, WI 53105
 262-661-4239

LOTS 4 AND 5 IN BLOCK 4 OF "LAKEVIEW PARK", A SUBDIVISION LOCATED IN THE NORTHEAST 1/4 OF SECTION 16, TOWNSHIP 1 NORTH, RANGE 17 EAST OF THE FOURTH PRINCIPAL MERIDIAN, IN THE TOWN OF LINN, COUNTY OF WALWORTH AND STATE OF WISCONSIN.

SURVEY FOR: DARIUS DIRMANTAS SURVEY ADDRESS: W3734 LAKEVIEW PARK DRIVE, LAKE GENEVA, WI 53147

PLAT OF SURVEY
 -OF-

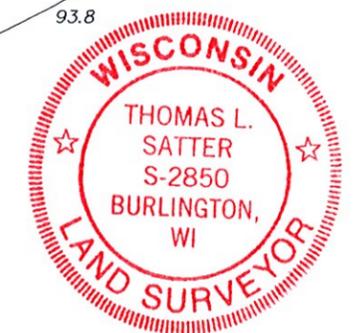

THIS IS NOT AN ORIGINAL PRINT UNLESS THIS SEAL IS RED.
Thomas L. Satter
 THOMAS L. SATTER S-2850

NOVEMBER 2, 2021 DATE 102103 JOB NUMBER