
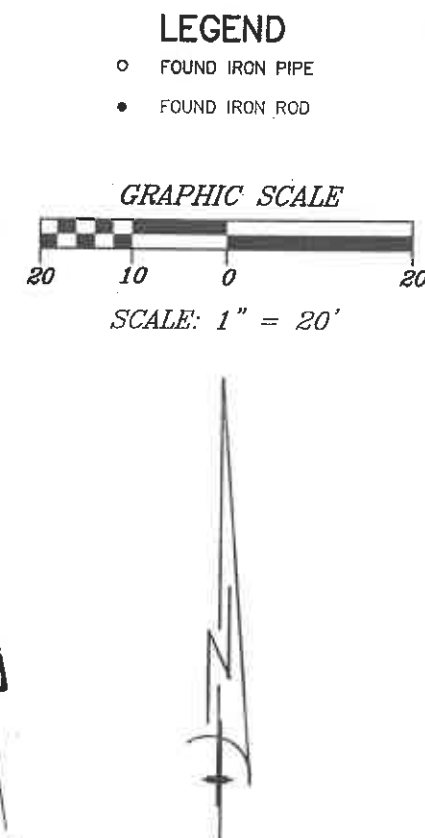


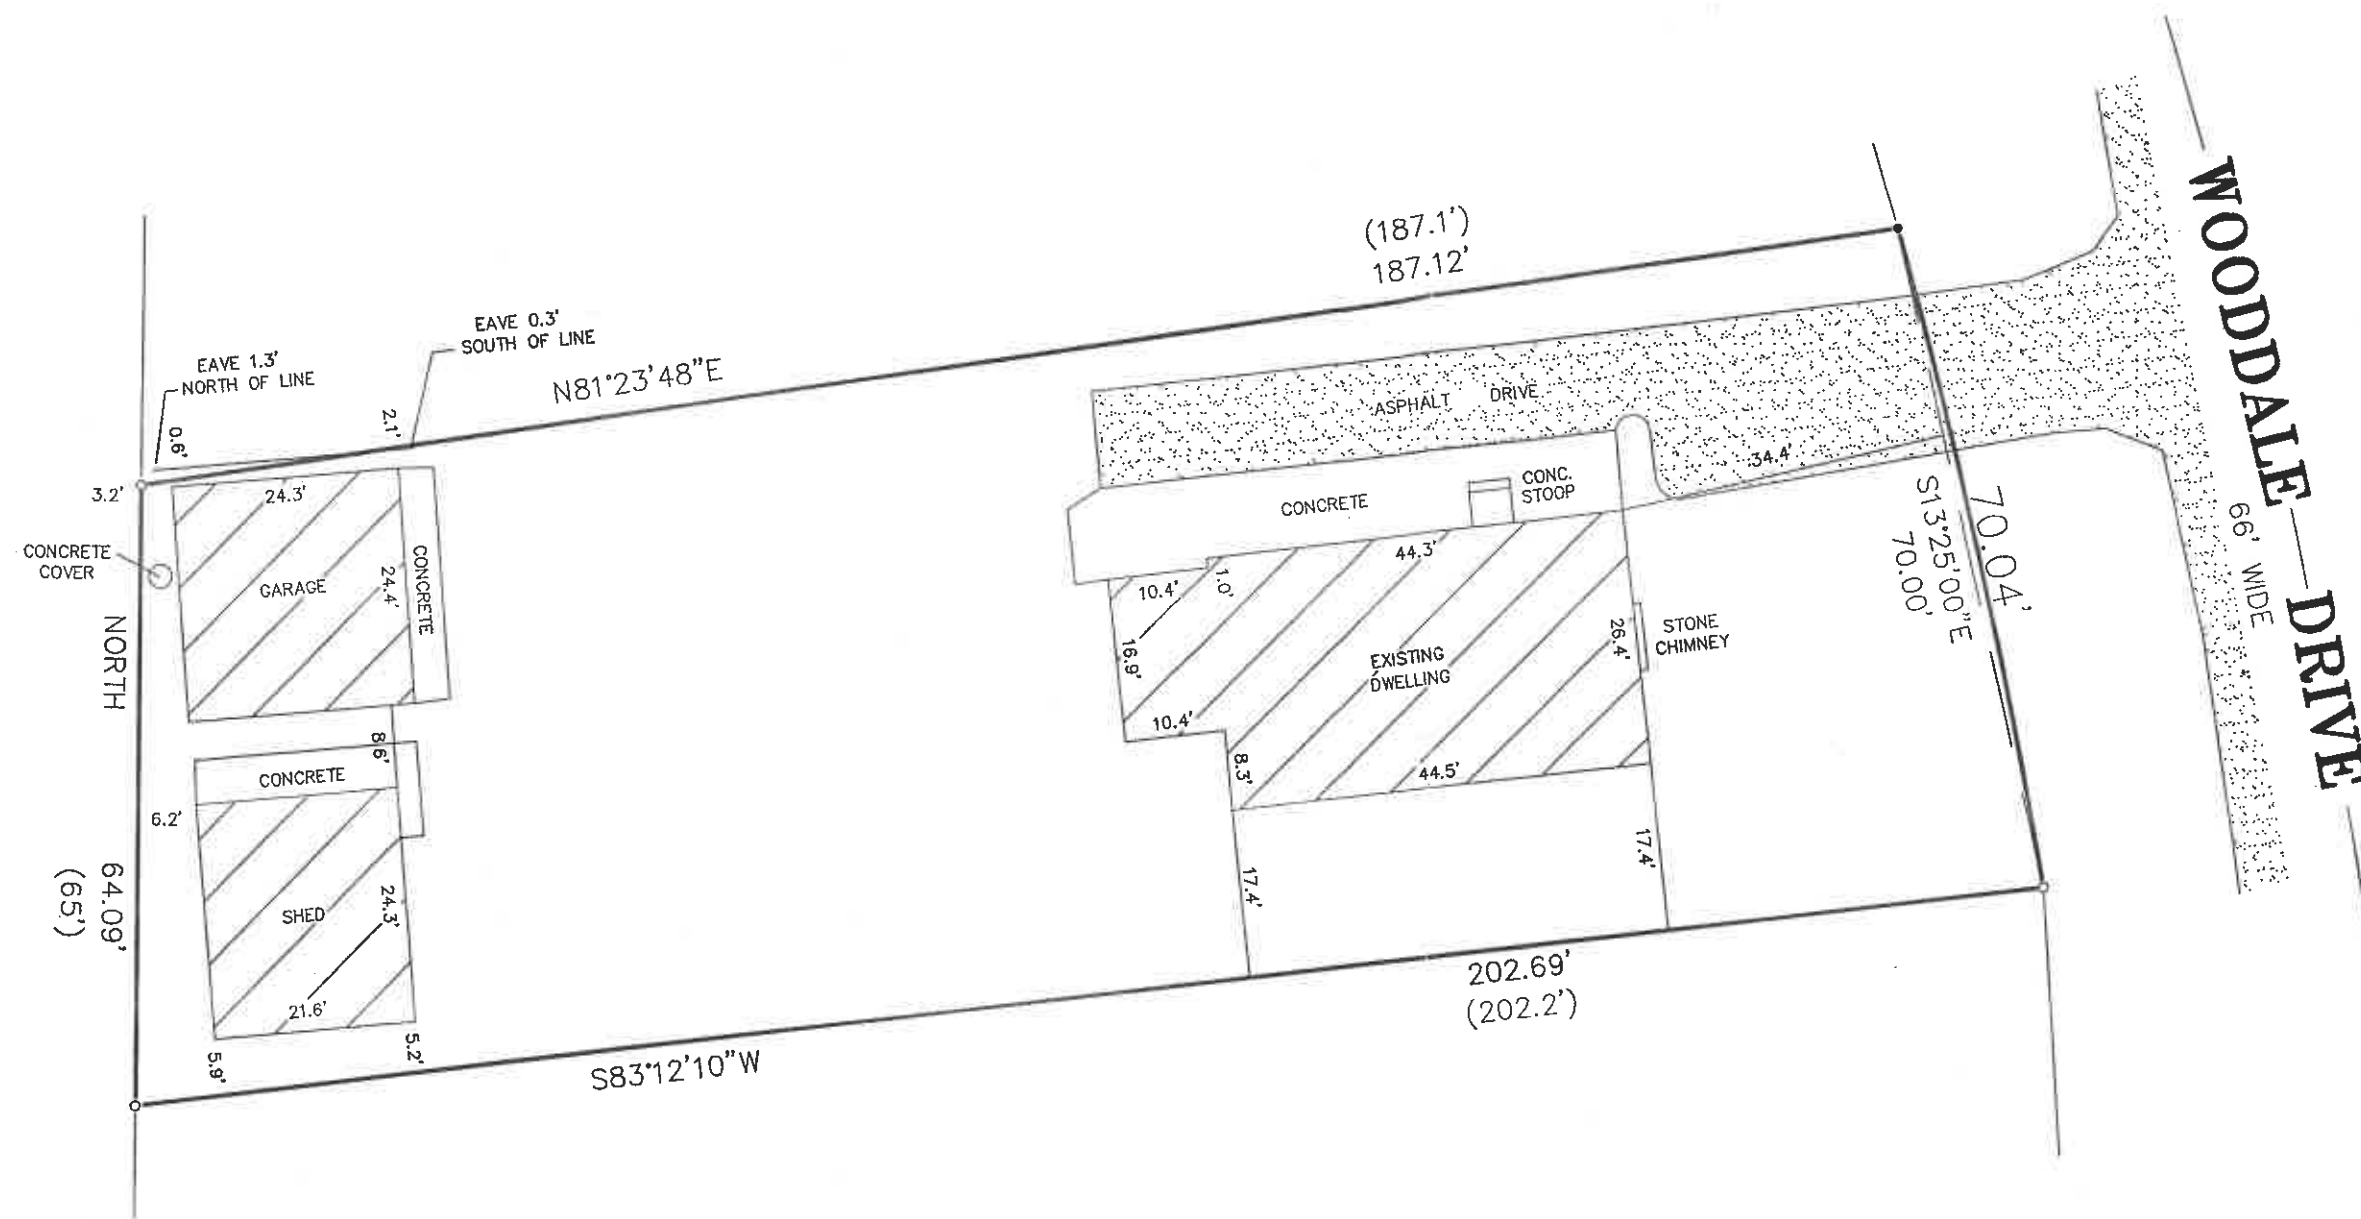

"I hereby certify that I have surveyed the above described property and that the above map is a correct representation thereof and shows the size and location of the property, its exterior boundaries, the location of all visible structures and dimensions of all principal buildings thereon, boundary fences, apparent easements, roadways and encroachments, if any."

"This survey is made for the use of the present owners of the property, and those who purchase, mortgage, or guarantee the title thereto within one year from date hereof."

PLAT OF SURVEY -OF-

LOT 10, BLOCK 14, WOODDALE ADDITION, TOWN OF LINN, WALWORTH COUNTY, WISCONSIN.

SURVEY FOR: KEEFE REAL ESTATE
 SURVEY LOCATION: N1607 WOODDALE DRIVE

BEARINGS HEREON RELATE TO THE WEST LINE OF LOT 10, BLOCK 14 OF WOODDALE ADDITION, ASSUMED BEARING NORTH.

THIS IS NOT AN ORIGINAL PRINT
 UNLESS THIS SEAL IS RED.



B.W. SURVEYING, INC.
 LAND SURVEYS
 MAPPING AND PLANNING
 412 N. PINE STREET
 BURLINGTON, WI 53105
 (262)-767-0225

Robert J. Wetzel
 ROBERT J. WETZEL S-1778

NOVEMBER 1, 2021
 DATE

10543
 JOB NUMBER