
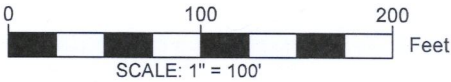


PLAT OF SURVEY


LEGAL DESCRIPTION:
A PARCEL OF LAND LOCATED IN THE NORTHWEST AND SOUTHWEST 1/4 OF THE NORTHWEST 1/4 OF SECTION 4 IN TOWNSHIP 1 NORTH, RANGE 17 EAST, IN THE TOWN OF LINN, WALWORTH COUNTY, WISCONSIN.

MORE PARTICULARLY DESCRIBED AS:

LOT 2 OF CSM NO. 3932 AS RECORDED IN DOCUMENT NO. 675443 PER THE WALWORTH COUNTY REGISTER OF DEEDS.

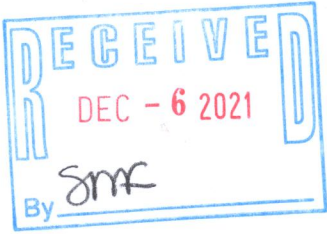


- LEGEND
- EXISTING BUILDING
 - EXISTING ASPHALT
 - EXISTING CONCRETE
 - EXISTING STONE
 - EXISTING DECK
 - FOUND 1" IRON PIPE
 - FOUND IRON ROD
 - (xx) RECORDED AS
 - SET 1" IRON PIPE

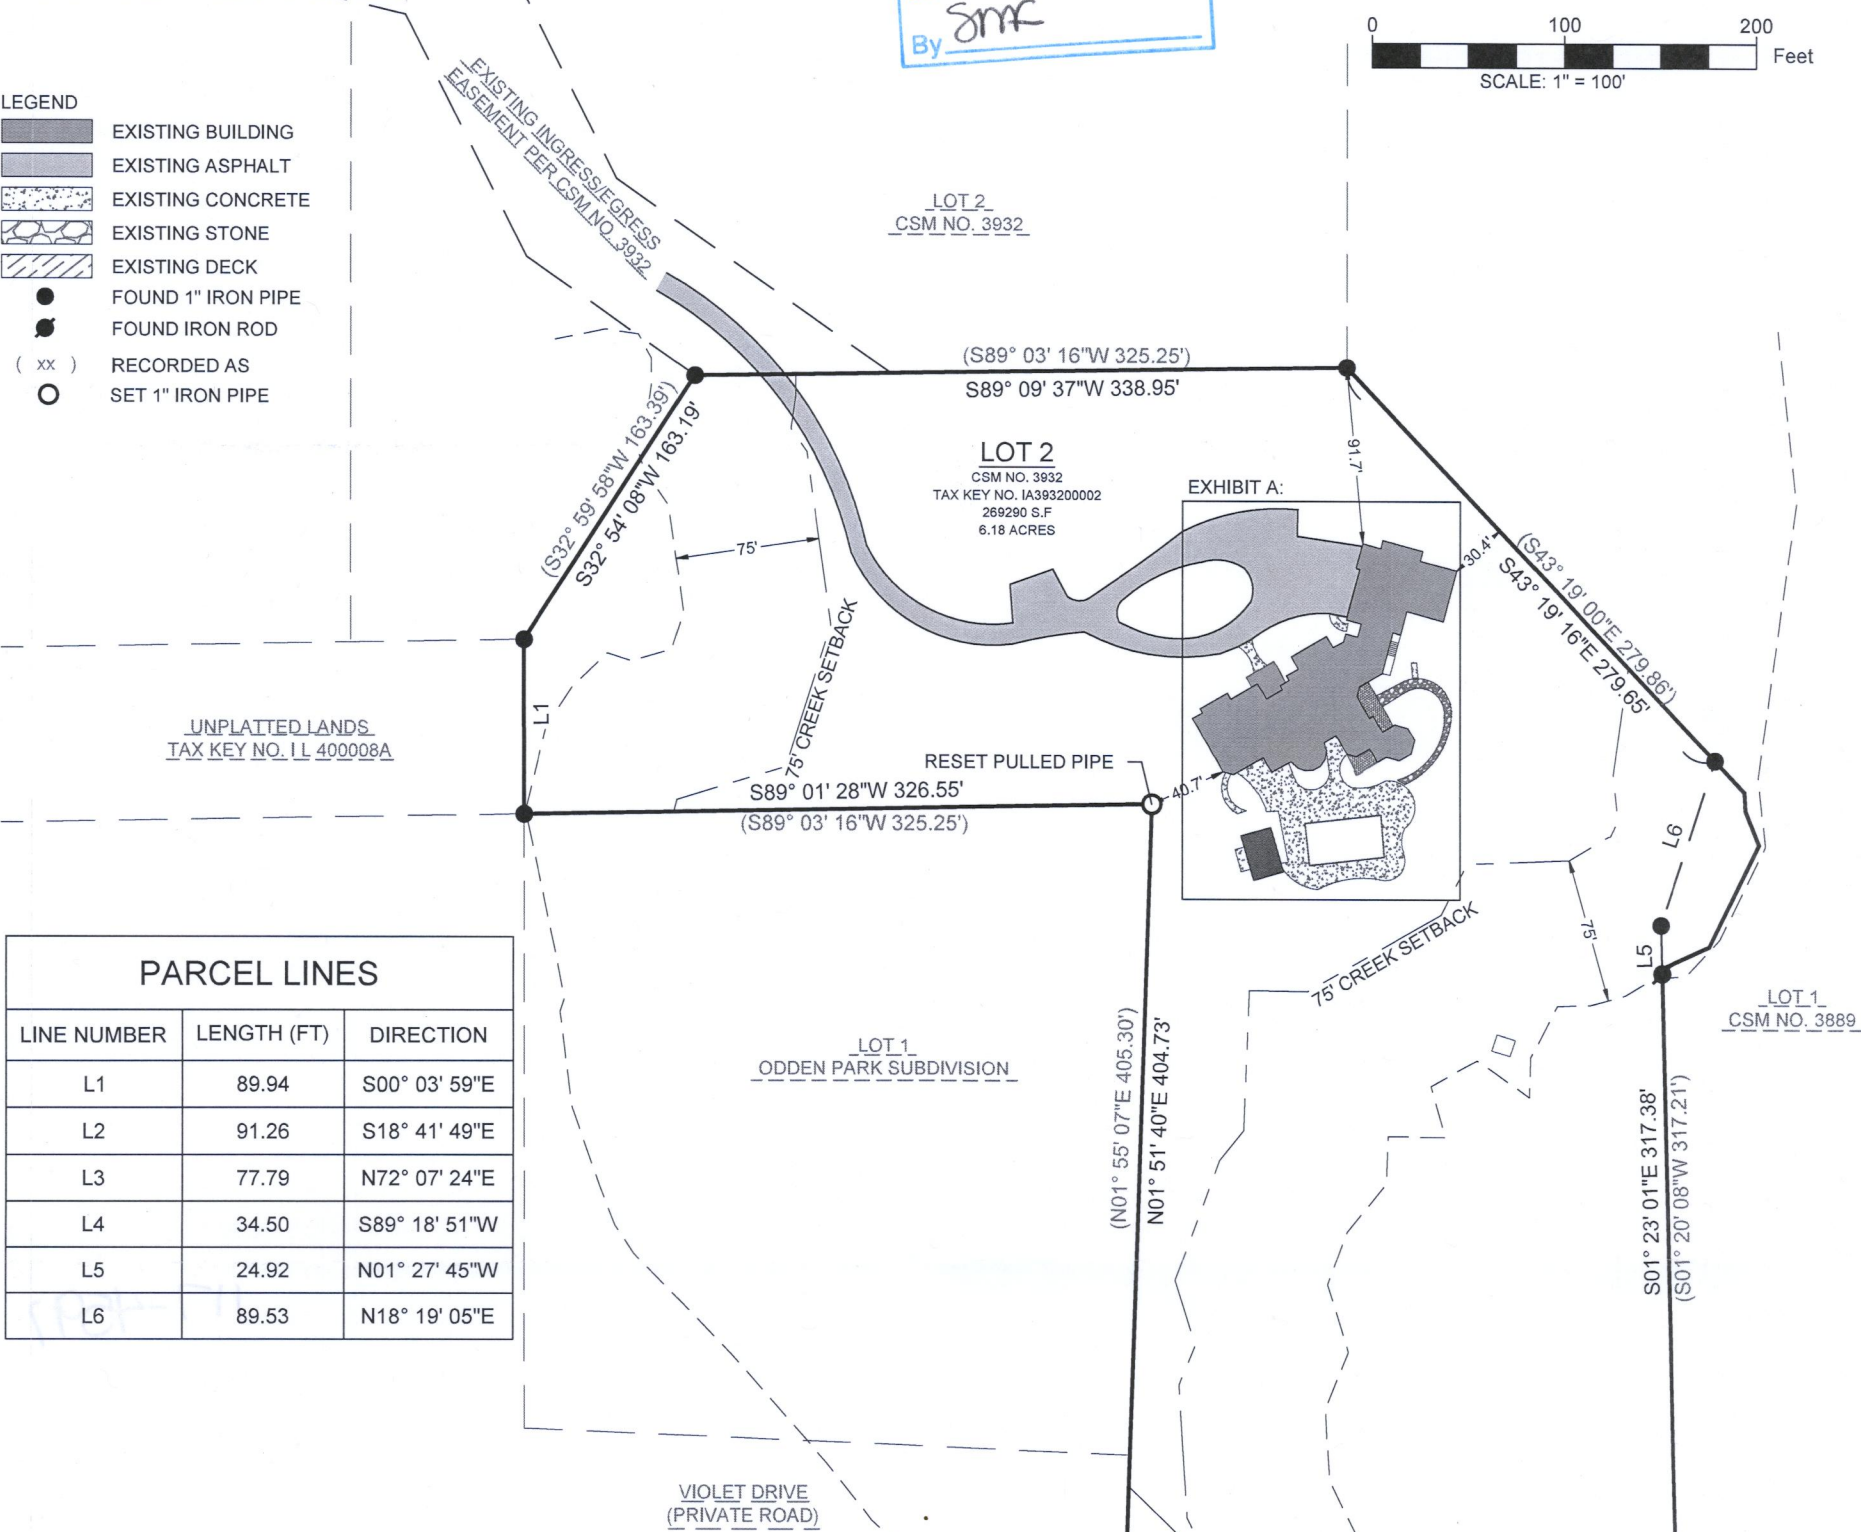

PARCEL LINES

LINE NUMBER	LENGTH (FT)	DIRECTION
L1	89.94	S00° 03' 59"E
L2	91.26	S18° 41' 49"E
L3	77.79	N72° 07' 24"E
L4	34.50	S89° 18' 51"W
L5	24.92	N01° 27' 45"W
L6	89.53	N18° 19' 05"E

EXHIBIT A:

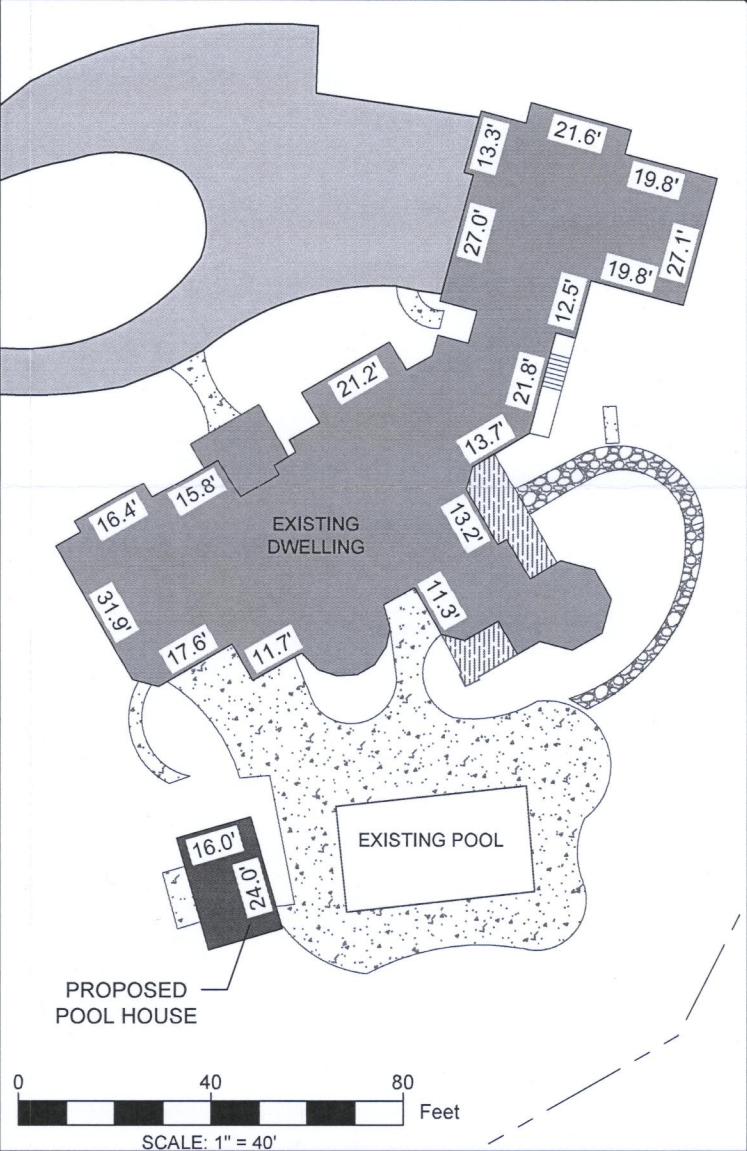

"I HEREBY CERTIFY THAT I HAVE SURVEYED THE ABOVE DESCRIBED PROPERTY AND THE MAP IS A TRUE AND CORRECT REPRESENTATION OF ITS EXTERIOR BOUNDARIES AND SHOWS THE SIZE AND LOCATION OF ALL VISIBLE STRUCTURES, APPARENT EASEMENTS AND ENCROACHMENTS, IF ANY."

Paul H. Van Henkelum
PAUL H VAN HENKELUM, PLS #1931
DATE 11/30/2021



CARDINAL ENGINEERING LLC
DESIGNING IN TRUE DIRECTIONS
PO BOX 281 - 1200 LA SALLE ST.
LAKE GENEVA, WI 53147
262-757-8776
CARDINALENGINEERINGWI.COM

DATE: 11 / 28 / 2021 JOB No. 21550
SHEET 1 OF 1 EJO

PLOTTED: IA3932a-2

117-4591