


PLAT OF SURVEY & TOPOGRAPHIC MAPPING
LOT 8 AND PART OF LOT 7 OF CISCO BEACH

LOCATED IN PART OF THE SW 1/4 OF THE NE 1/4 OF SECTION 5,
TOWN 1 NORTH, RANGE 17 EAST, WALWORTH COUNTY, WISCONSIN

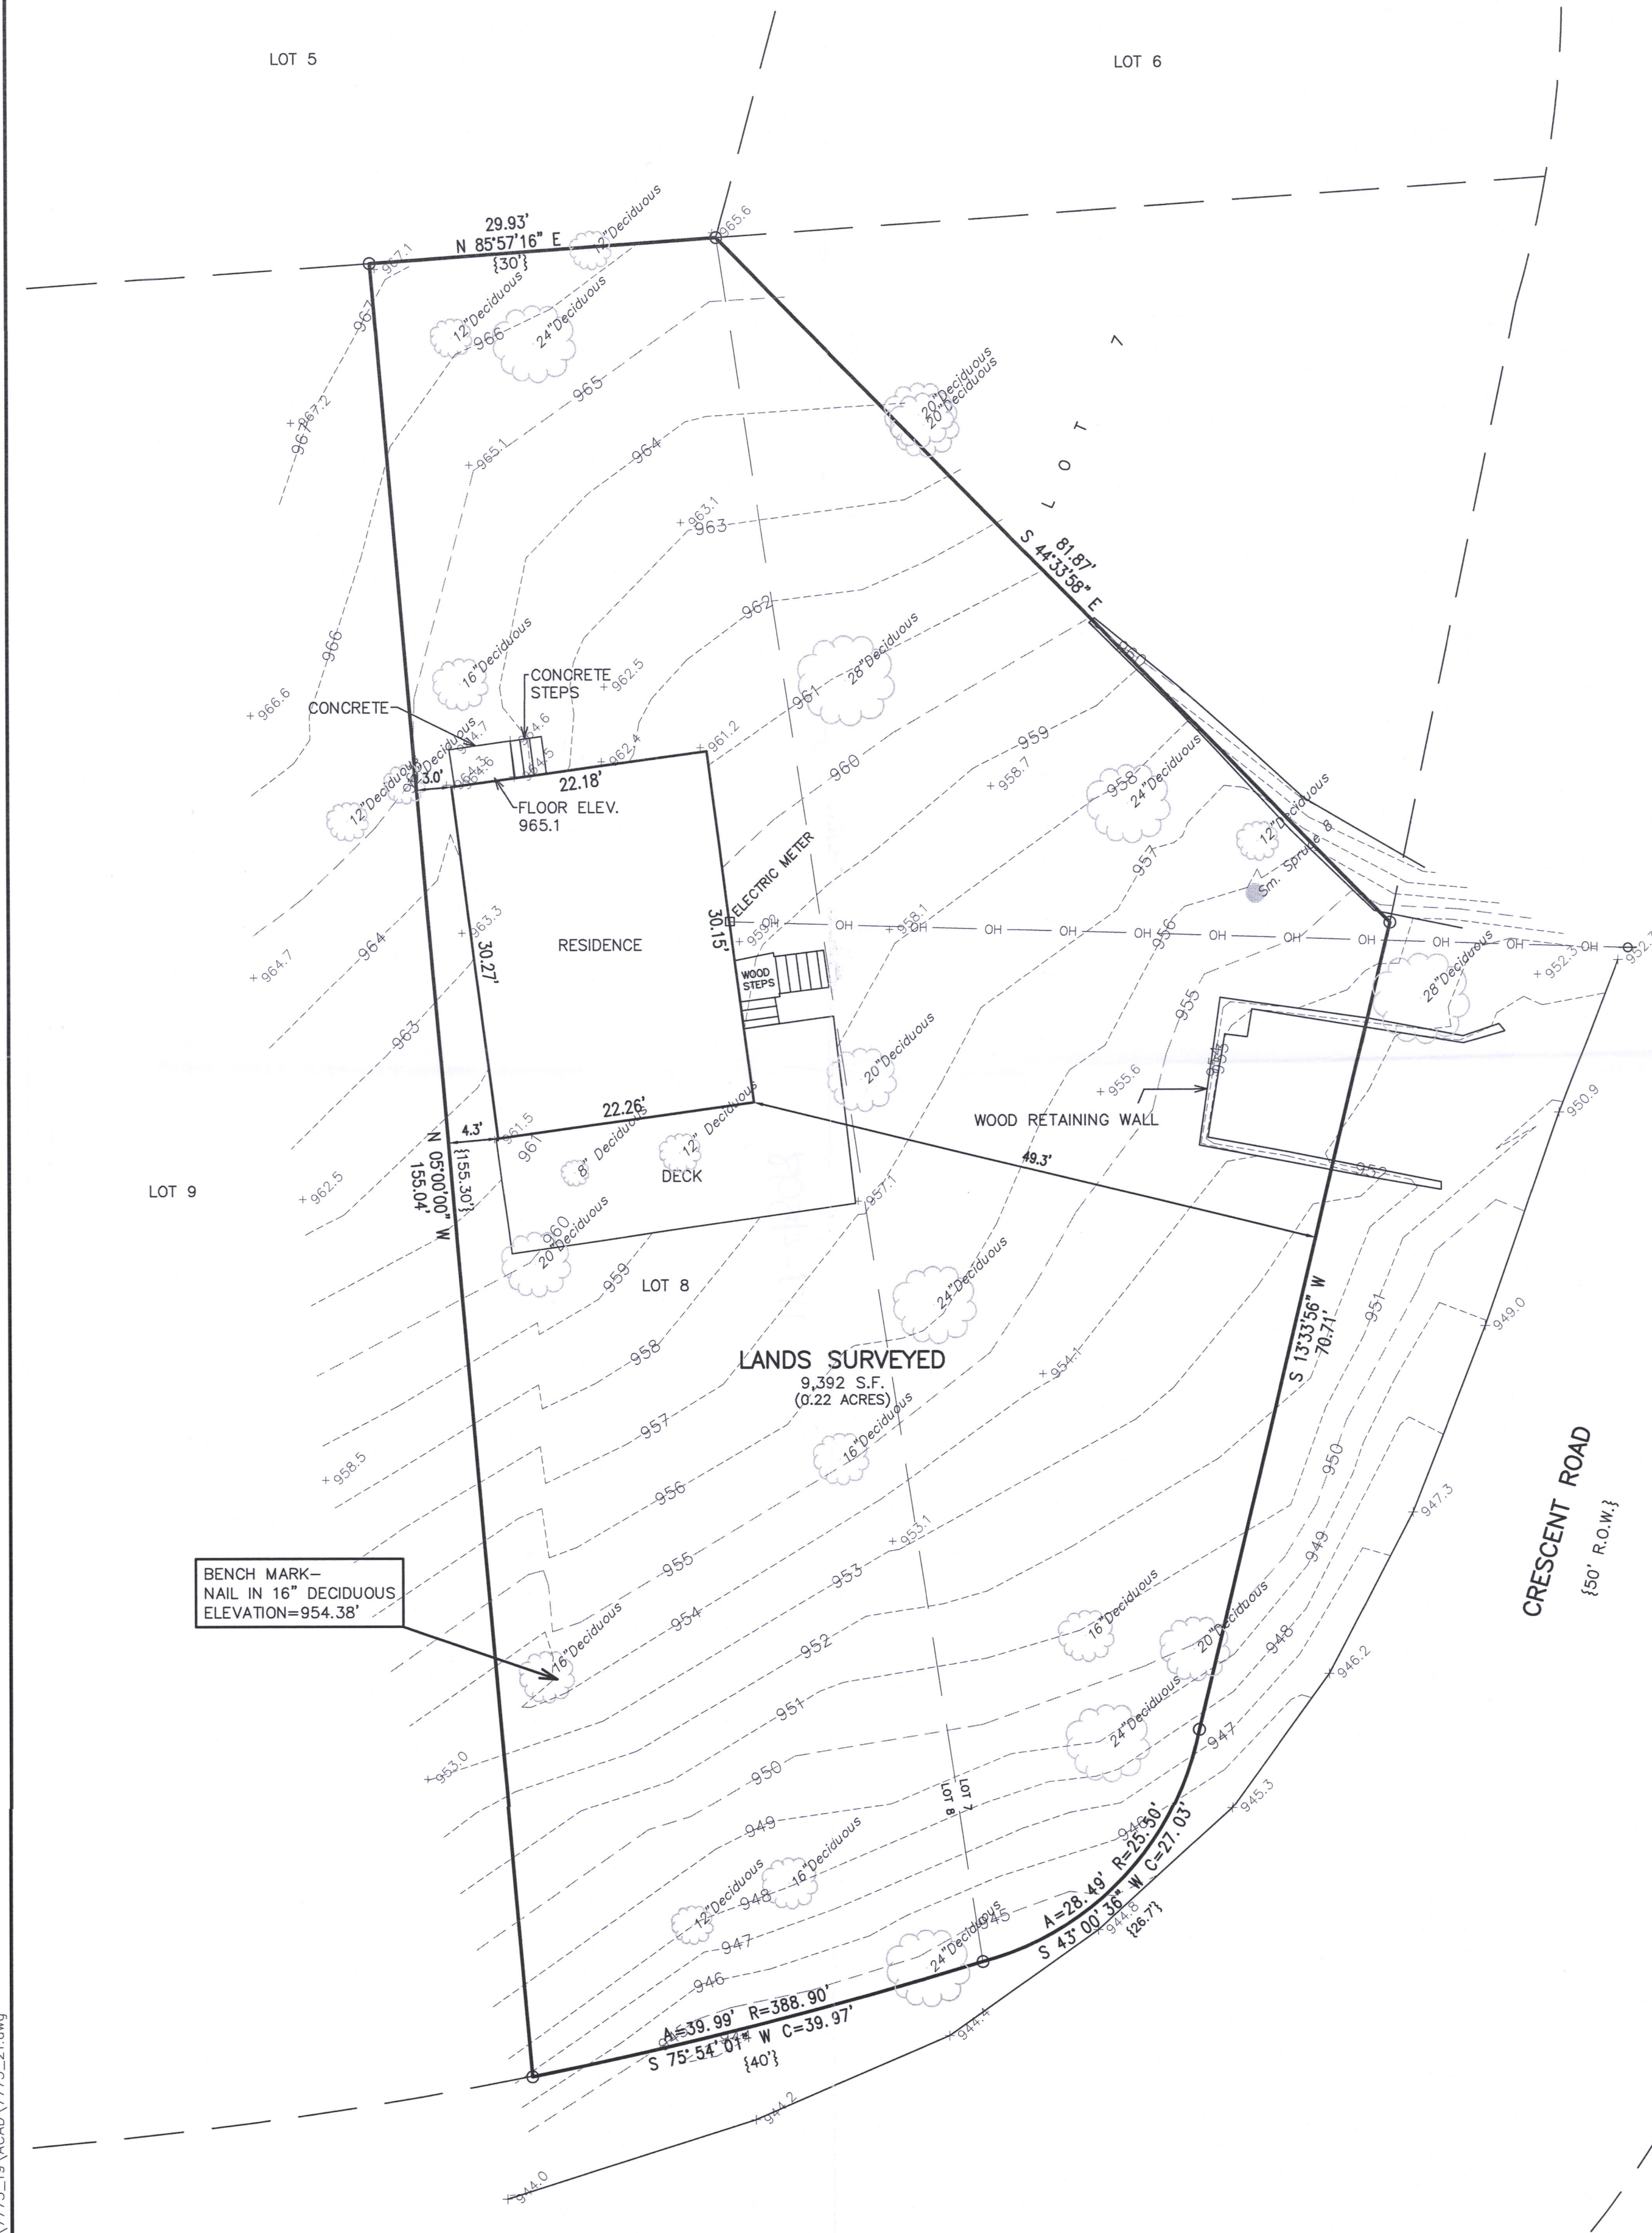

Lot 7 except that part thereof bounded and described as follows: Starting at the Northeast corner of said lot; thence South along the road 65 feet; thence Northwest to the Northwest corner of said lot and thence East to the place of beginning;

Lot 8 in Block "F" in Cisco Beach, in Section 5, Township 1 North, Range 17, East of the 4th Principal Meridian, according to the plat thereof recorded October 9, 1916 in Volume 8 of Plats at Page 103, in Walworth County, Wisconsin.


LEGEND
O = FOUND IRON PIPE STAKE
{XXX} = RECORDED AS
⊕ = UTILITY POLE

NOTE: COPIES OF THIS MAP TO WHICH THE FOLLOWING CERTIFICATE WILL APPLY SHOW THE SURVEYOR'S ORIGINAL SEAL AND SIGNATURE IN RED INK. COPIES BY ANY OTHER MEANS MAY HAVE ALTERATIONS WHICH DO NOT REPRESENT THE SURVEYOR'S WORK PRODUCT.

I HEREBY CERTIFY THAT THE ABOVE DESCRIBED PROPERTY HAS BEEN SURVEYED UNDER MY DIRECTION AND THAT THE ABOVE MAP IS A TRUE REPRESENTATION THEREOF AND SHOWS THE SIZE AND LOCATION OF THE PROPERTY AND ITS EXTERIOR BOUNDARIES. THIS SURVEY IS MADE FOR THE USE OF THE PRESENT OWNERS OF THE PROPERTY, AND ALSO THOSE WHO PURCHASE, MORTGAGE, OR GUARANTEE THE TITLE THERETO WITHIN ONE YEAR FROM THE DATE HEREOF.

DATED: 12/7/2021

CHRISTOPHER A. HODGES P.L.S. 2760

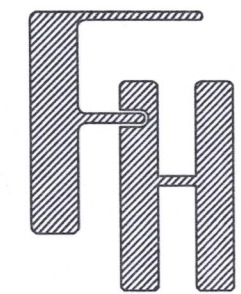

TOPOGRAPHIC SURVEY
W4240 CRESCENT DRIVE
LAKE GENEVA, WISCONSIN

WORK ORDERED BY -
LINDA SPERACINO
422 S. SCOVILLE #2
OAK PARK, IL 60302

FARRIS, HANSEN & ASSOCIATES, INC.
ENGINEERING - ARCHITECTURE - SURVEYING
7 RIDGWAY COURT P.O. BOX 437
ELKHORN, WISCONSIN 53121
OFFICE: (262) 723-2098 FAX: (262) 723-5866

REVISIONS

PROJECT NO.
7775.21
DATE
12/07/21
SHEET NO.
1 OF 1

X:\PROJECTS\7775\7775_19\ACAD\7775_21.dwg

ICI-111

117-5598