


X:\Projects\10493\ACAD\10493.dwg

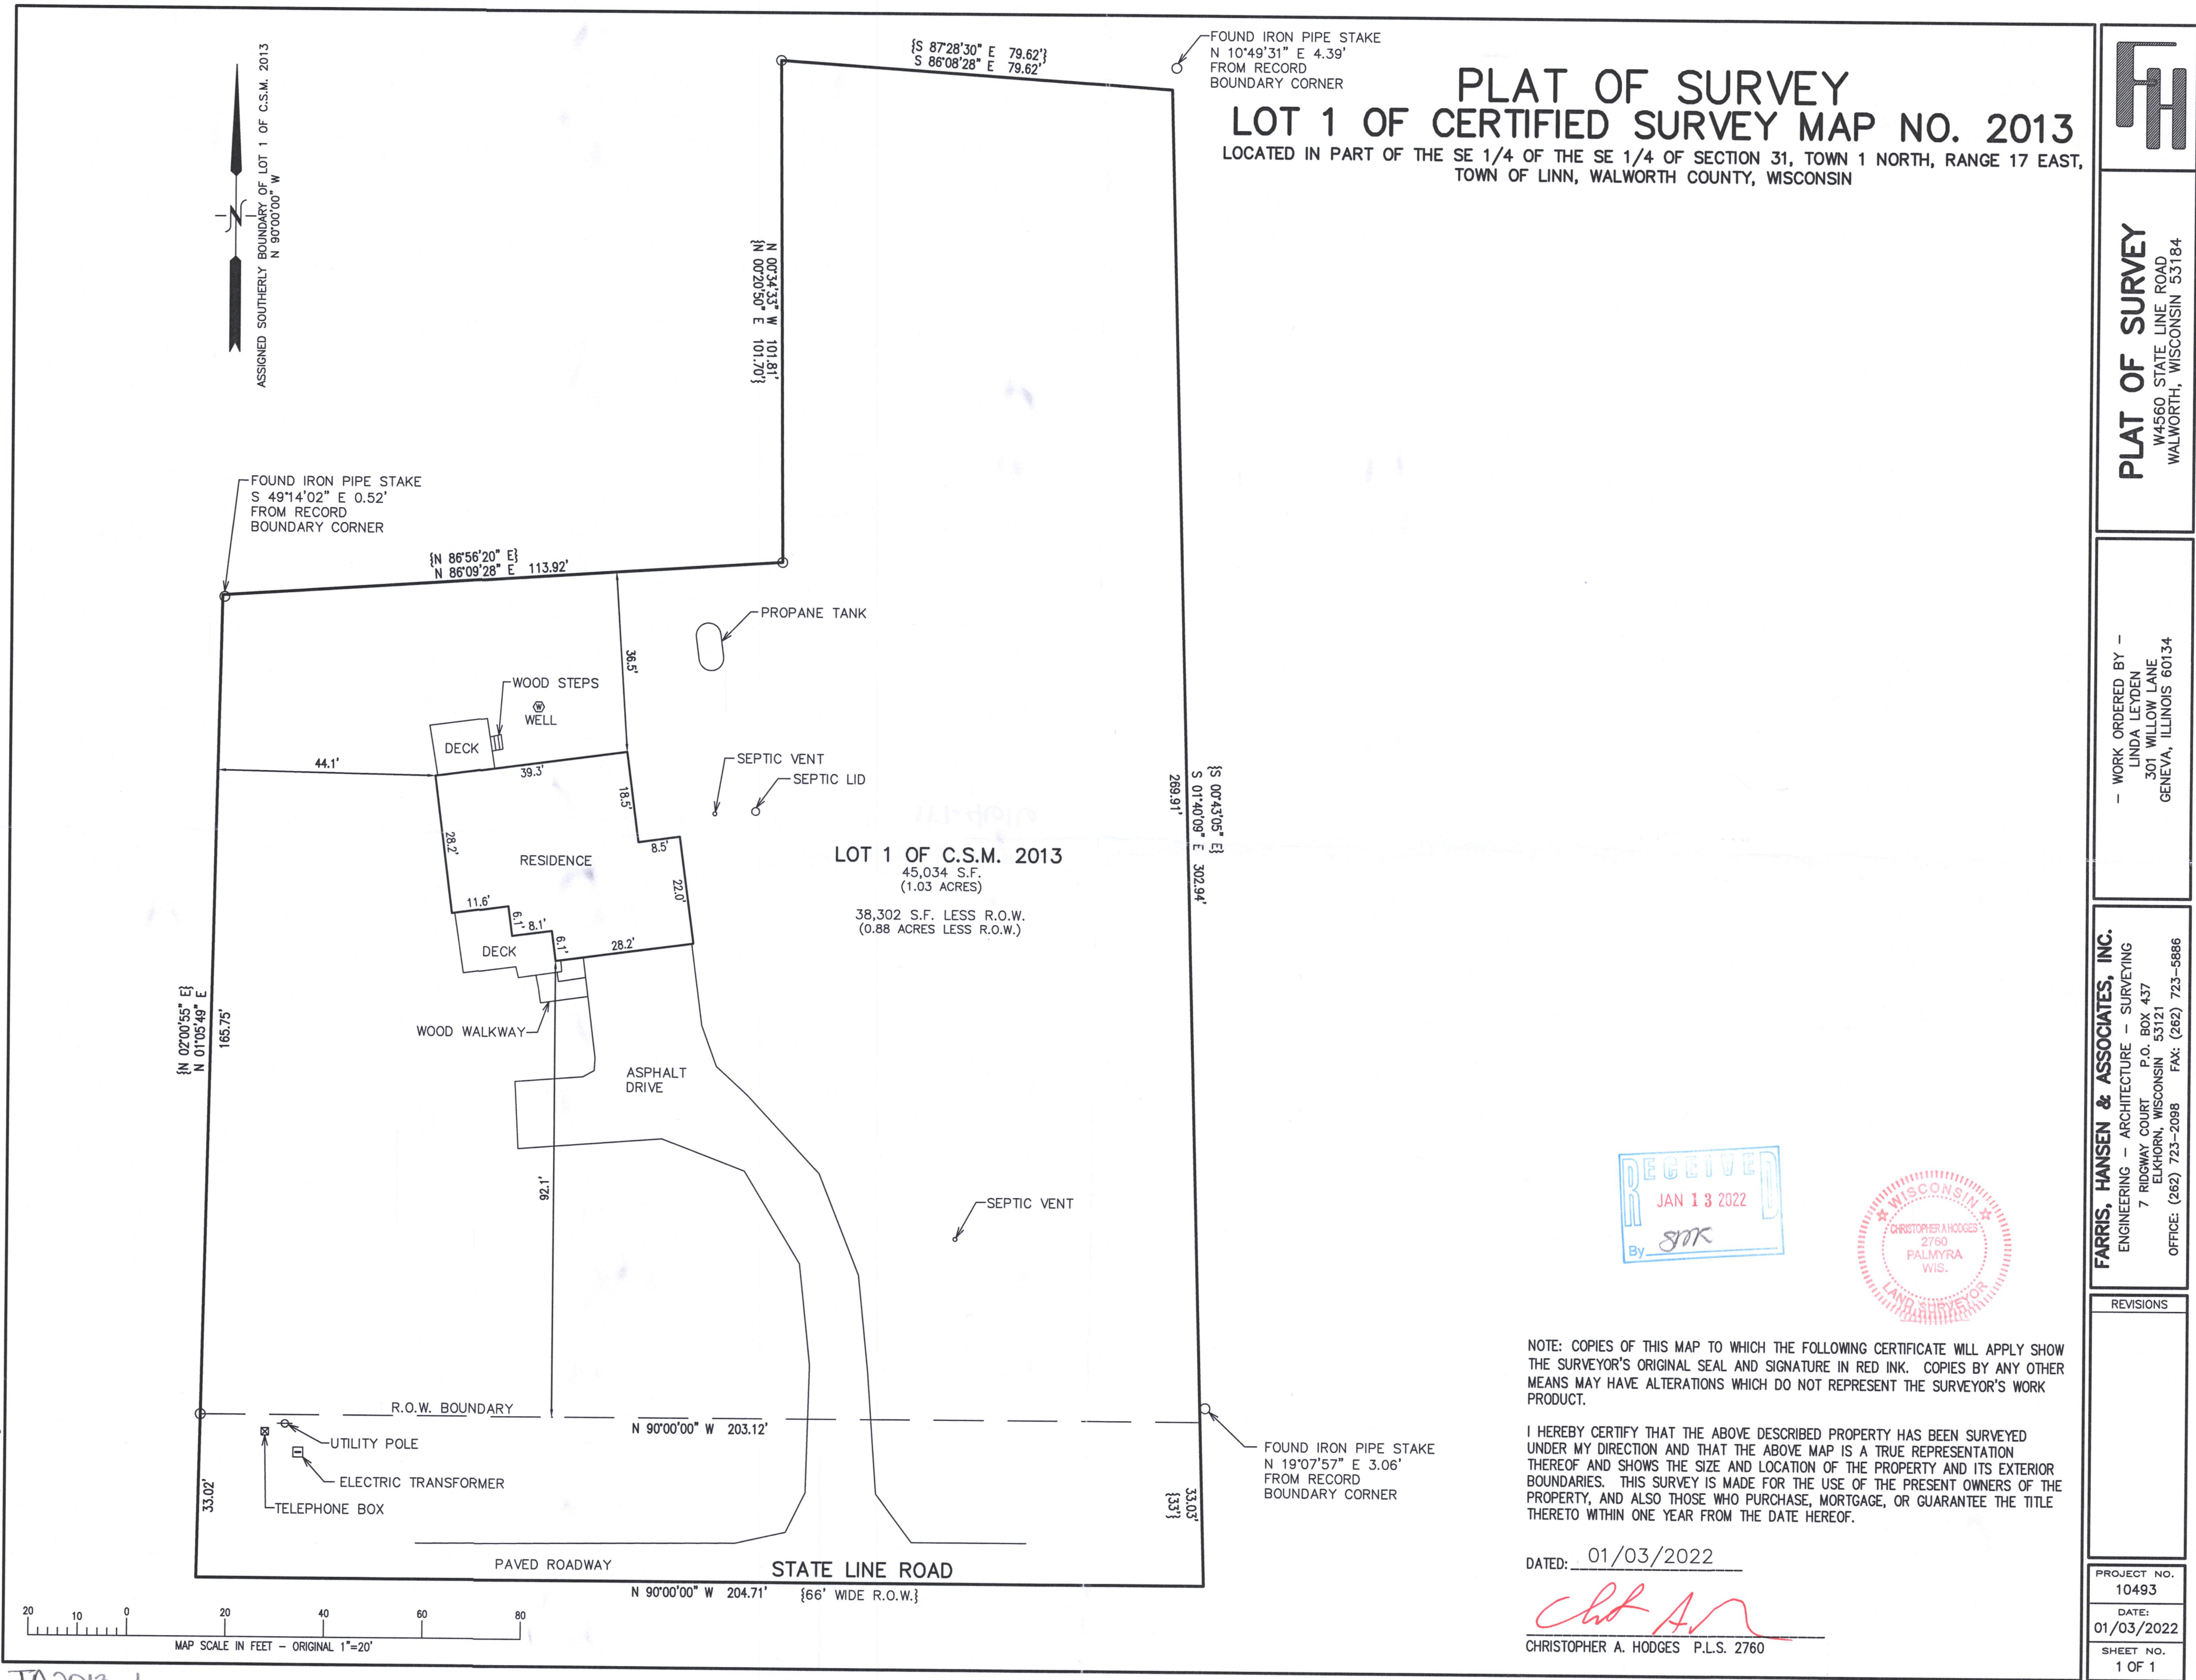

TA2013-1