


PROPERTY SURVEY MAP

Lot 1, Block 10, Maple Hills "A" Subdivision, located in part of the Southwest 1/4 and the Southeast 1/4 of Section 18, Township 1 North, Range 17 East, Town of Linn, Walworth County, Wisconsin.

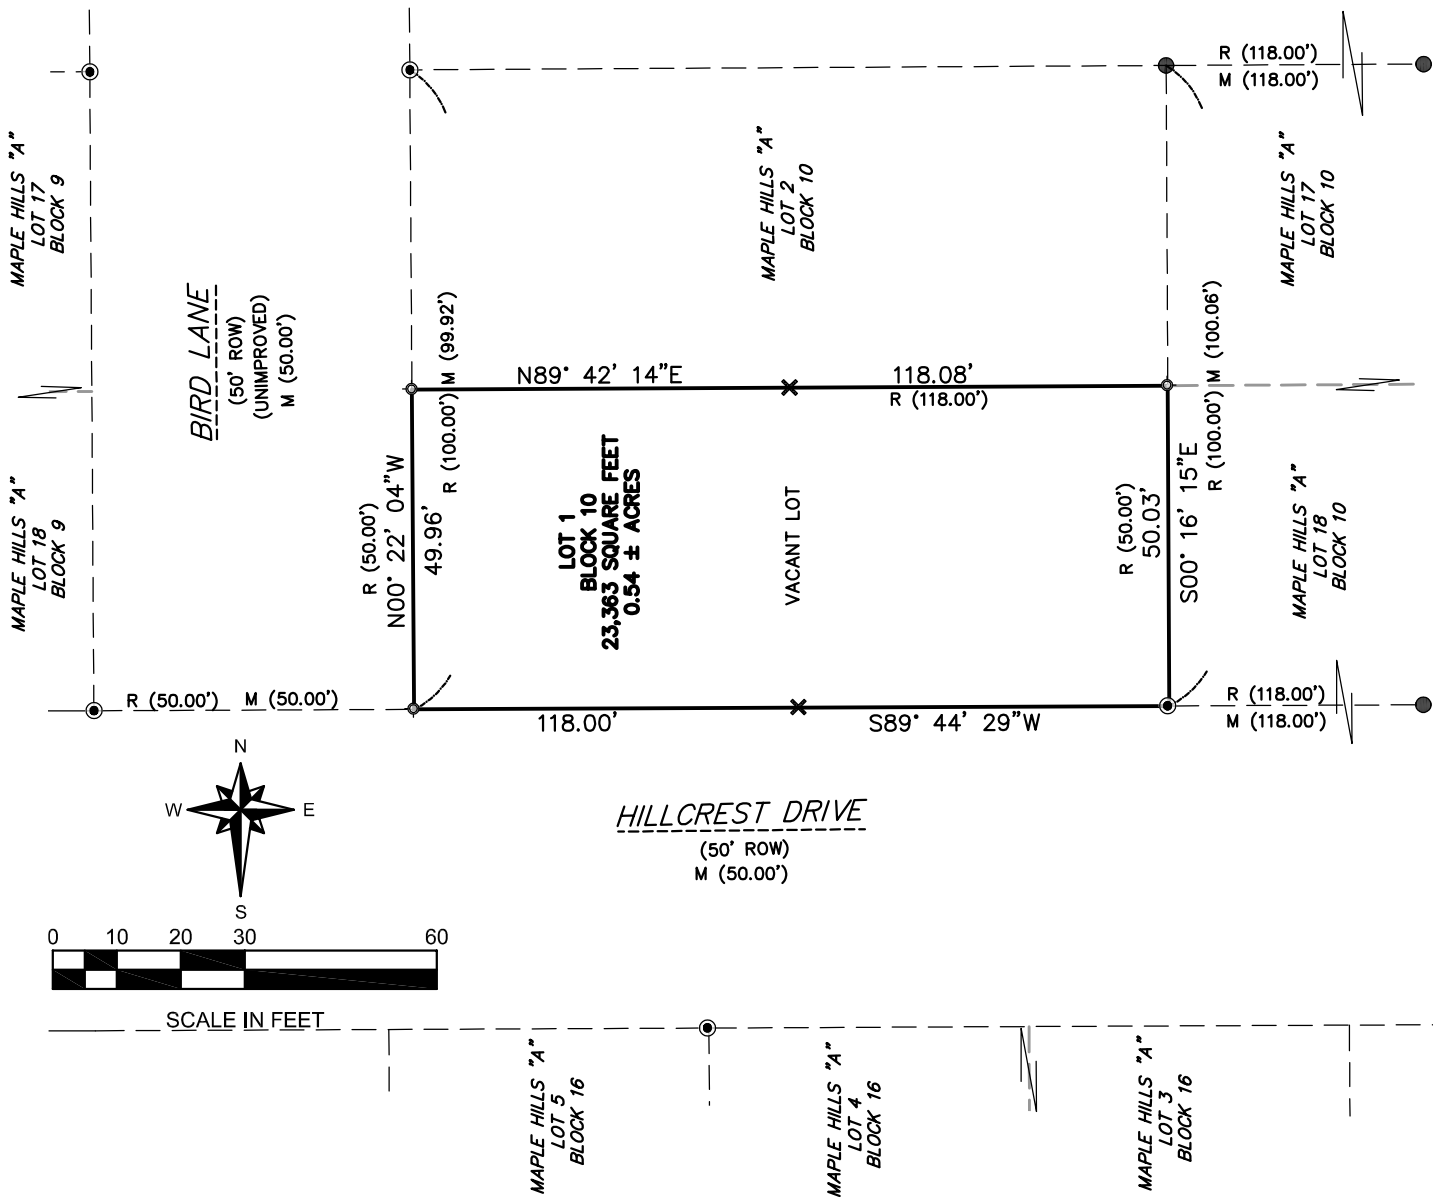

SURVEY LEGEND


- FOUND 1" IRON PIPE
- ⊙ FOUND 3/4" IRON REBAR
- ⊕ 1 1/2" IRON PIPE SET 18" LONG AND 1.13 LBS / PER FOOT
- ✕ LATH STAKED ON PROPERTY LINE
- R() RECORDED AS
- M() MEASURED AS

SURVEYED FOR:

Geneva Lake Land Conservancy
P.O. Box 588
Fontana, WI 53125

PREPARED BY:

Ruekert & Mielke, Inc.
W233 N2080 Ridgeview Pkwy.
Waukesha, WI 53188

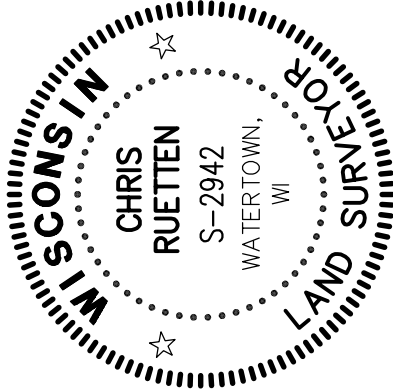

BEARINGS ARE REFERENCED TO THE NORTH LINE OF HILLCREST DRIVE, WHICH WAS MEASURED AS S89°44'29"W.

I, Chris Ruetten, Professional Land Surveyor S-2942, hereby certify that at the direction of the above named Client have prepared this Property Survey of the lands described above, that I have complied with the requirements of pertinent State Statutes, the Wisconsin Administrative Code A-E 7 and that no provisions thereof have been waived, and that as of this date shown hereon this map is correct to the best of my knowledge and belief.

Chris Ruetten

Chris Ruetten, P.L.S. 2942
Dated this 1st day of February, 2022

 **Ruekert • Mielke** 2022
www.ruekertmielke.com