

HAROLD H. KOLB

REGISTERED PROFESSIONAL LAND SURVEYOR
LAKE GENEVA, WISCONSIN

PLAN OF SURVEY OF

Lot 12, Lake Geneva Beach Subdivision,
Section 11, T 1 N, R 17 E, Walworth
County, Wisconsin.

OWNER: Eugene Regenauer
148 Foulton Ave.
Waukegan, Ill. 60085


ACCURACY: Distances $\pm 0.05'$
Angles $\pm 05''$
Error of closure
less than 1/3000



Scale 1" = 30'

LEGEND

- φ — IRON PIPE FOUND
- — IRON PIPE PLACED
- — CONCRETE MONUMENT
- x — SPIKE

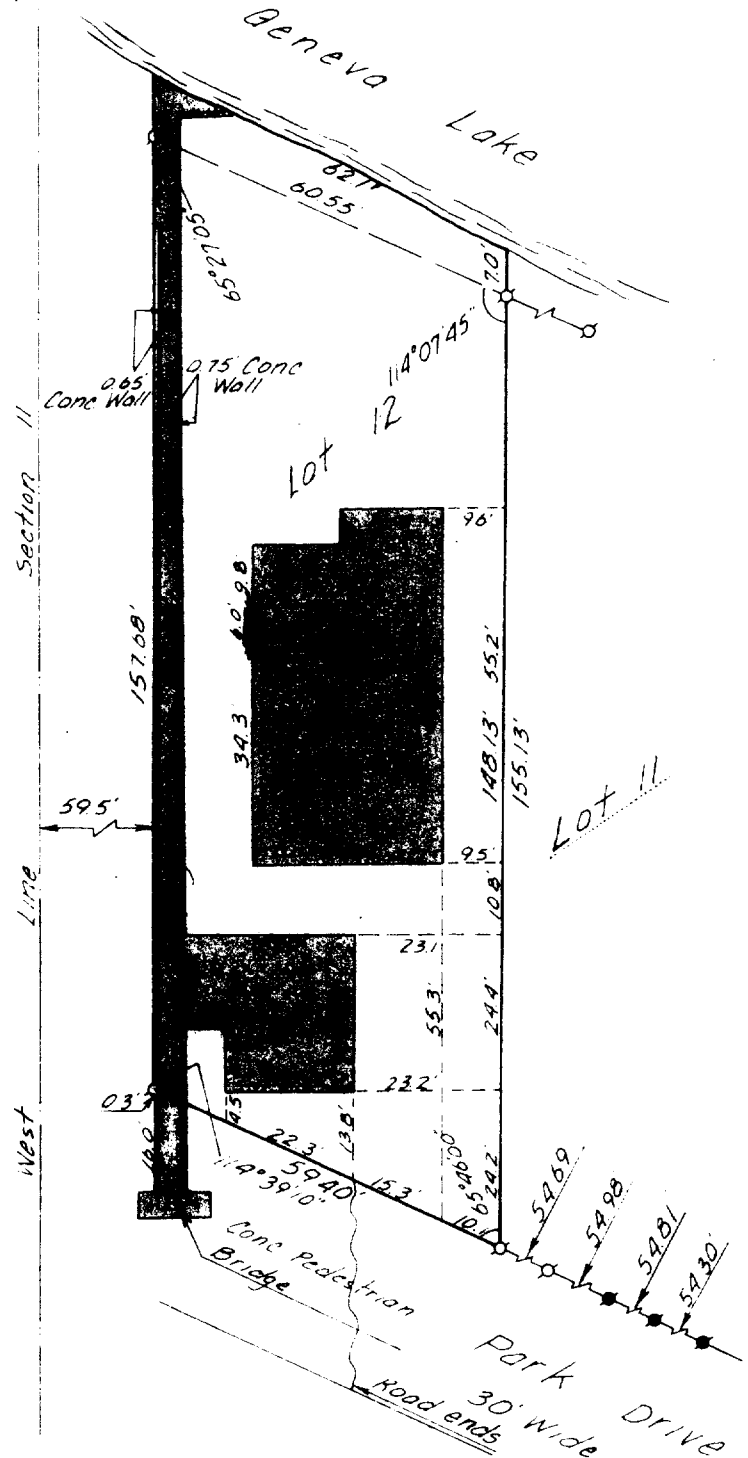

I, HAROLD H. KOLB, DO HEREBY CERTIFY THAT I HAVE
SURVEYED THE PROPERTY HEREON DESCRIBED ACCORDING
TO THE OFFICIAL RECORDS, AND THAT THE PLAT HEREON
IS A CORRECT REPRESENTATION OF THE LOT LINES, and
the principle lines of the buildings thereon.

Harold H. Kolb

HAROLD H. KOLB
WISCONSIN REGISTERED LAND SURVEYOR, S-187

DATE Dec. 19, 1974

REVISED: Dec. 20, 1974