

HAROLD H. KOLB

REGISTERED PROFESSIONAL LAND SURVEYOR
LAKE GENEVA, WISCONSIN

PLAT OF SURVEY OF

Lots 23, 24 and 25, Block 4, Lakeview
Park Subdivision, T1N, R17E, Walworth
County, Wisconsin.

OWNER: Syver Estate

ACCURACY: Distances $\pm 0.01'$
Angles $\pm 05''$
Error of closure less than
1/3000





SCALE - 1" = 50'

LEGEND

- ⊕ - IRON PIPE FOUND
- - Iron rod found;
set iron pipe
- x - SPIKE
- ⚡ - Iron Pin Found
- () - As Platted

ILVP-19B

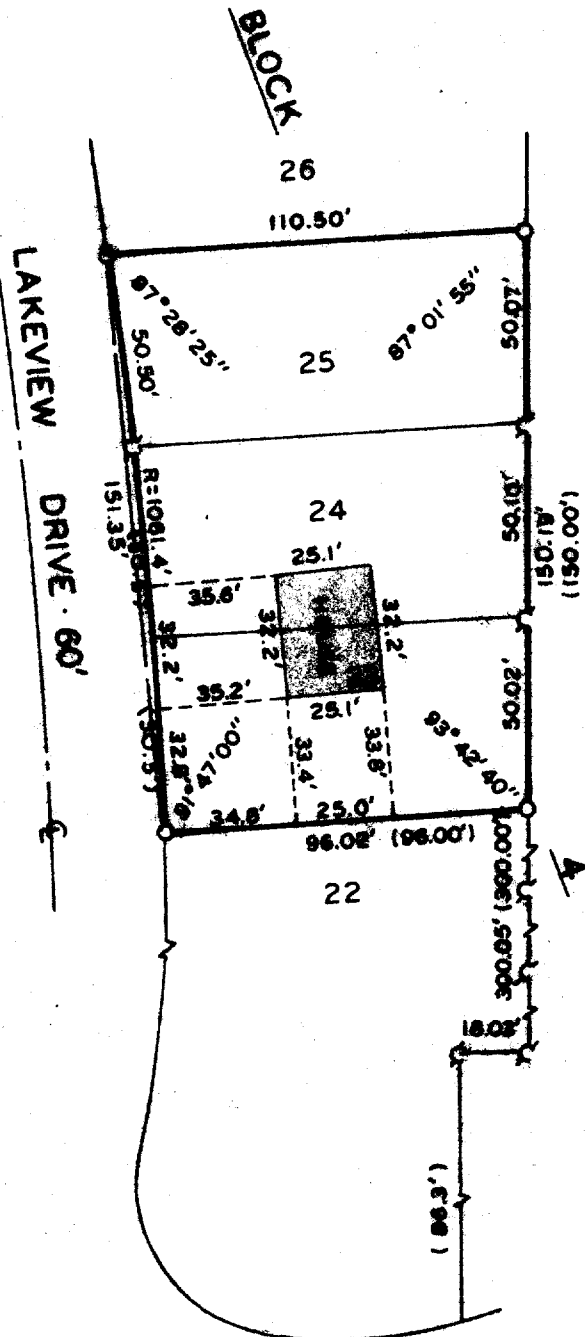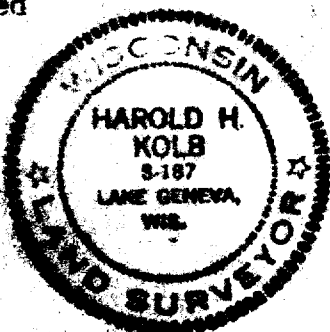

I, HAROLD H. KOLB, DO HEREBY CERTIFY THAT I HAVE
SURVEYED THE PROPERTY HEREON DESCRIBED ACCORDING
TO THE OFFICIAL RECORDS, AND THAT THE PLAT HEREON
IS A CORRECT REPRESENTATION OF THE LOT LINES.

Harold H. Kolb

HAROLD H. KOLB
WISCONSIN REGISTERED LAND SURVEYOR, S-187
DATE Nov. 22, 1974

117-466