
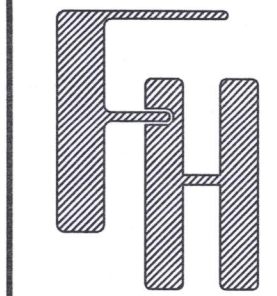


PLAT OF SURVEY - ASBUILT
LOT 3 AND AN UNDIVIDED 1/3 INTEREST IN OUTLOT 1 OF CERTIFIED SURVEY MAP NO. 781

LOCATED IN THE NORTHEAST 1/4 OF THE SOUTHEAST 1/4 OF SECTION 11, TOWN 1 NORTH, RANGE 3 EAST
TOWN OF LINN, WALWORTH COUNTY, WISCONSIN

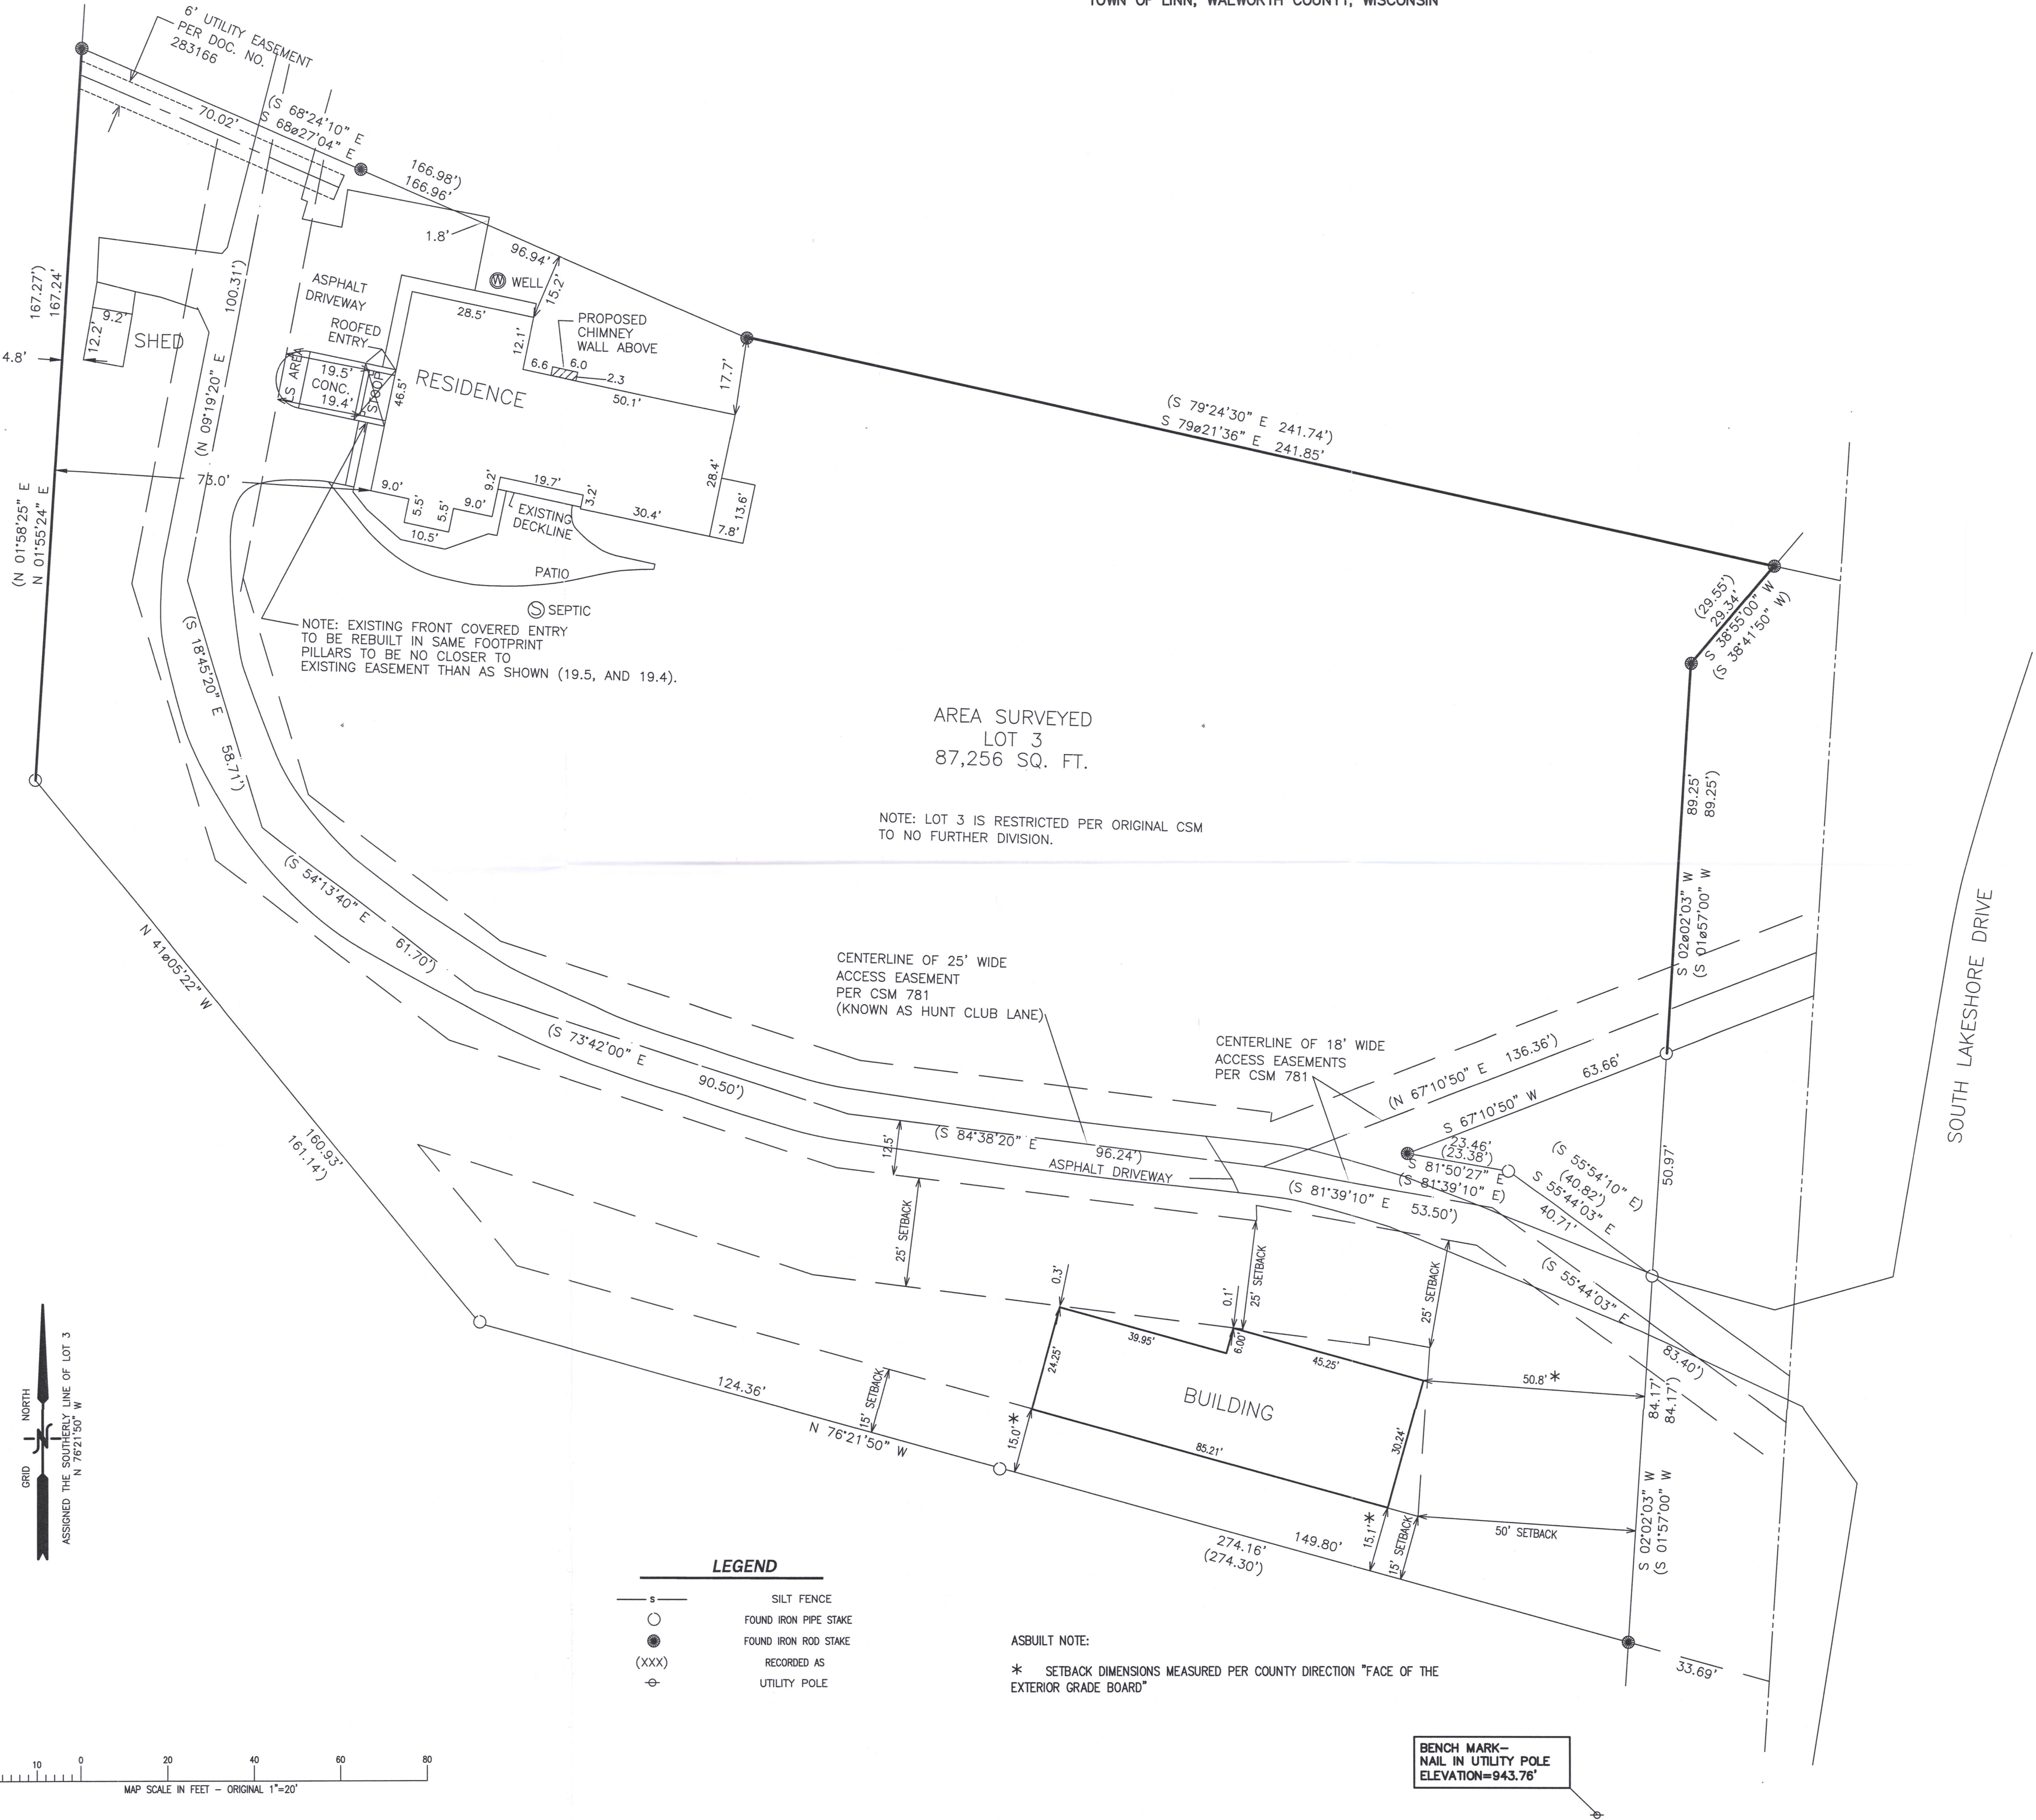

N1880 HUNT CLUB LANE
PLAT OF SURVEY - ASBUILT
N1880 HUNT CLUB LANE
TOWN OF LINN, WISCONSIN

WORK ORDERED BY -
KEITH KOVACH
N1880 HUNT CLUB LANE
LAKE GENEVA, WI 53147

FARRIS, HANSEN & ASSOCIATES, INC.
ENGINEERING - ARCHITECTURE - SURVEYING
7 RIDGWAY COURT P.O. BOX 437
ELKHORN, WISCONSIN 53121
OFFICE: (262) 723-2098 FAX: (262) 723-5886

REVISIONS
1/11/22 Permit Plat

5/27/2022 - DHC AS BUILT

PROJECT NO.
8270.21
DATE
11/30/21
SHEET NO.
1 OF 1