


HAROLD H. KOLB
REGISTERED PROFESSIONAL LAND SURVEYOR
LAKE GENEVA, WISCONSIN

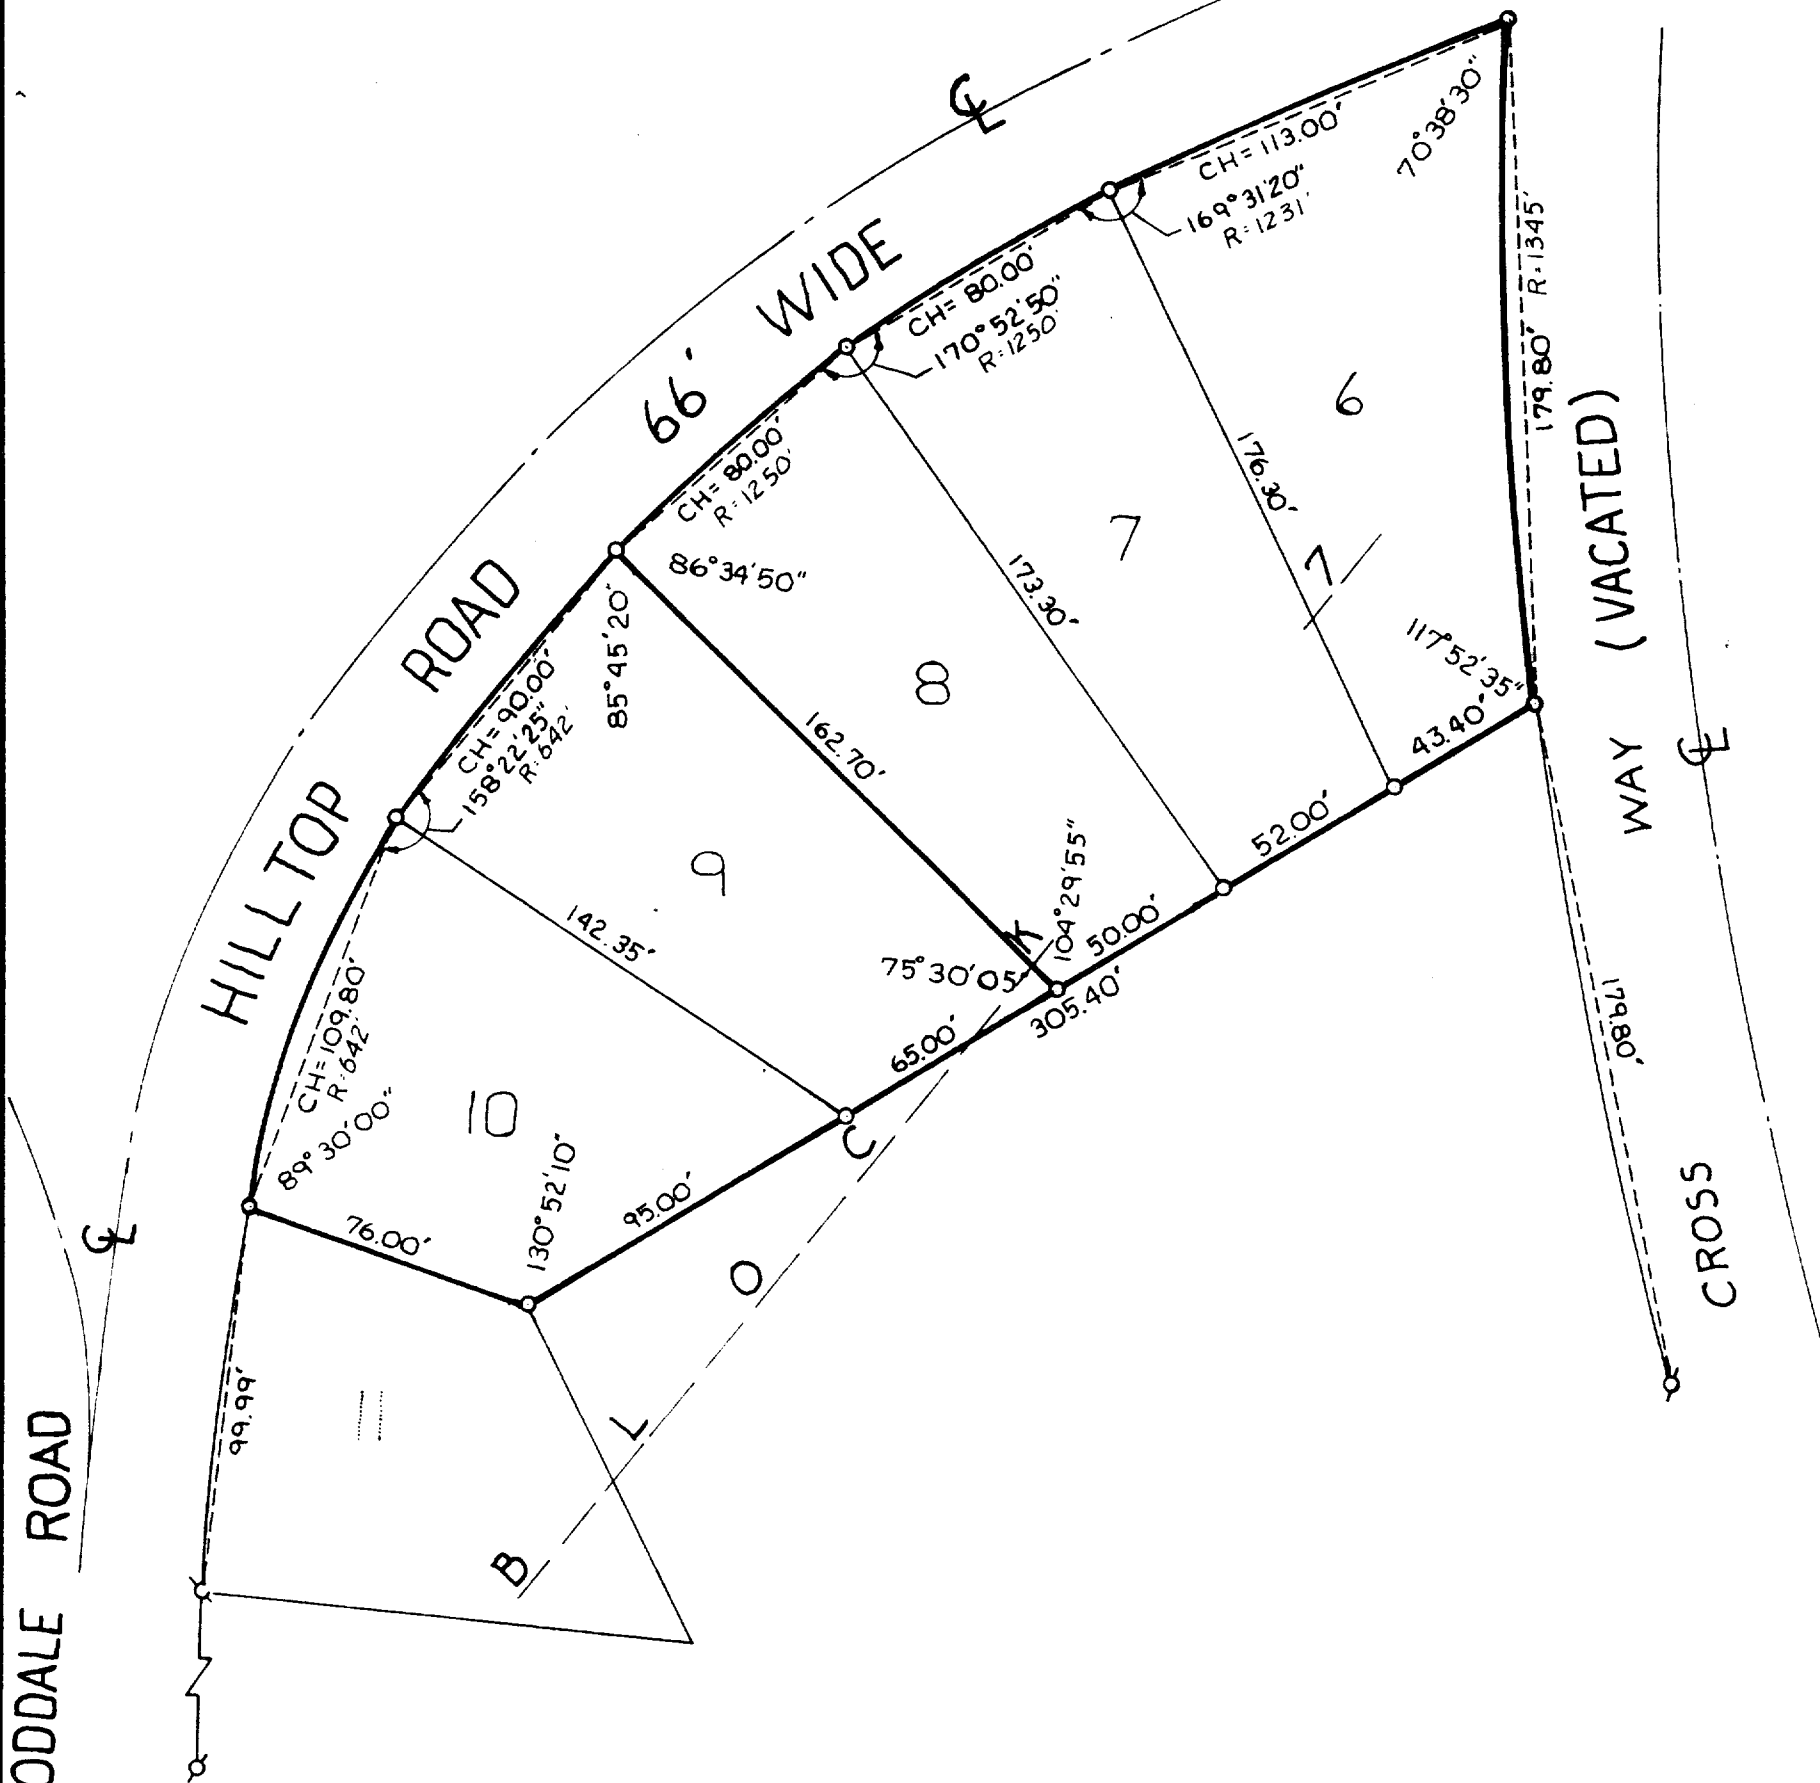

PLAT OF SURVEY OF
Lots 6, 7 and 8, Block 7, and Lots 9 and 10, Block
7, Wooddale Subdivision, T1N, R17E, Walworth County,
Wisconsin.

ACCURACY: Distances $\pm 0.01'$
Angles $\pm 35''$
Error of closure less
than 1/3000


OWNER: Elaine Cyner
P.O. Box 631
Lake Geneva, WI. 53147



SCALE 1"=40'
LEGEND

- φ — IRON PIPE FOUND
- — IRON PIPE PLACED
- — CONCRETE MONUMENT
- x — SPIKE
- ⊕ — FOUND IRON PIN

I W - 56 A

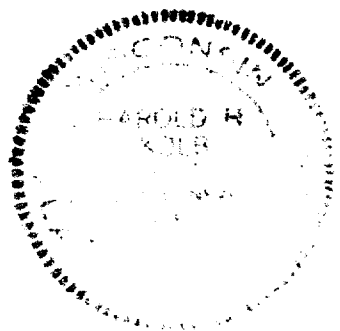

I, HAROLD H. KOLB, DO HEREBY CERTIFY THAT I HAVE
SURVEYED THE PROPERTY HEREON DESCRIBED ACCORDING
TO THE OFFICIAL RECORDS, AND THAT THE PLAT HEREON
IS A CORRECT REPRESENTATION OF THE LOT LINES.

Harold H. Kolb
HAROLD H. KOLB
WISCONSIN REGISTERED LAND SURVEYOR, S-187
DATE Feb. 10, 1975

117-469