


-OF-

SURVEY FOR: MARK VANSTEDUM
SURVEY ADDRESS: N2398 MAIN ROAD, LAKE GENEVA, WI 53147

NOTE: REFER TO A CURRENT TITLE REPORT FOR EASEMENTS, RESTRICTIONS OR COVENANTS WHICH MAY AFFECT THE USE OF THESE PROPERTIES.


NOTE: THIS MAP IS BEING REVISED THIS 9TH DAY OF AUGUST, 2022 TO DEPICT THE EXISTING DWELLING UNDER CONSTRUCTION AND SHOW ITS PROXIMITY TO THE PROPERTY LINES. ALL OTHER PROPERTY DETAILS ARE FROM PREVIOUS SURVEY WORK PERFORMED BY THIS OFFICE AND WERE NOT RE-VERIFIED AS PART OF THIS UPDATED SURVEY.

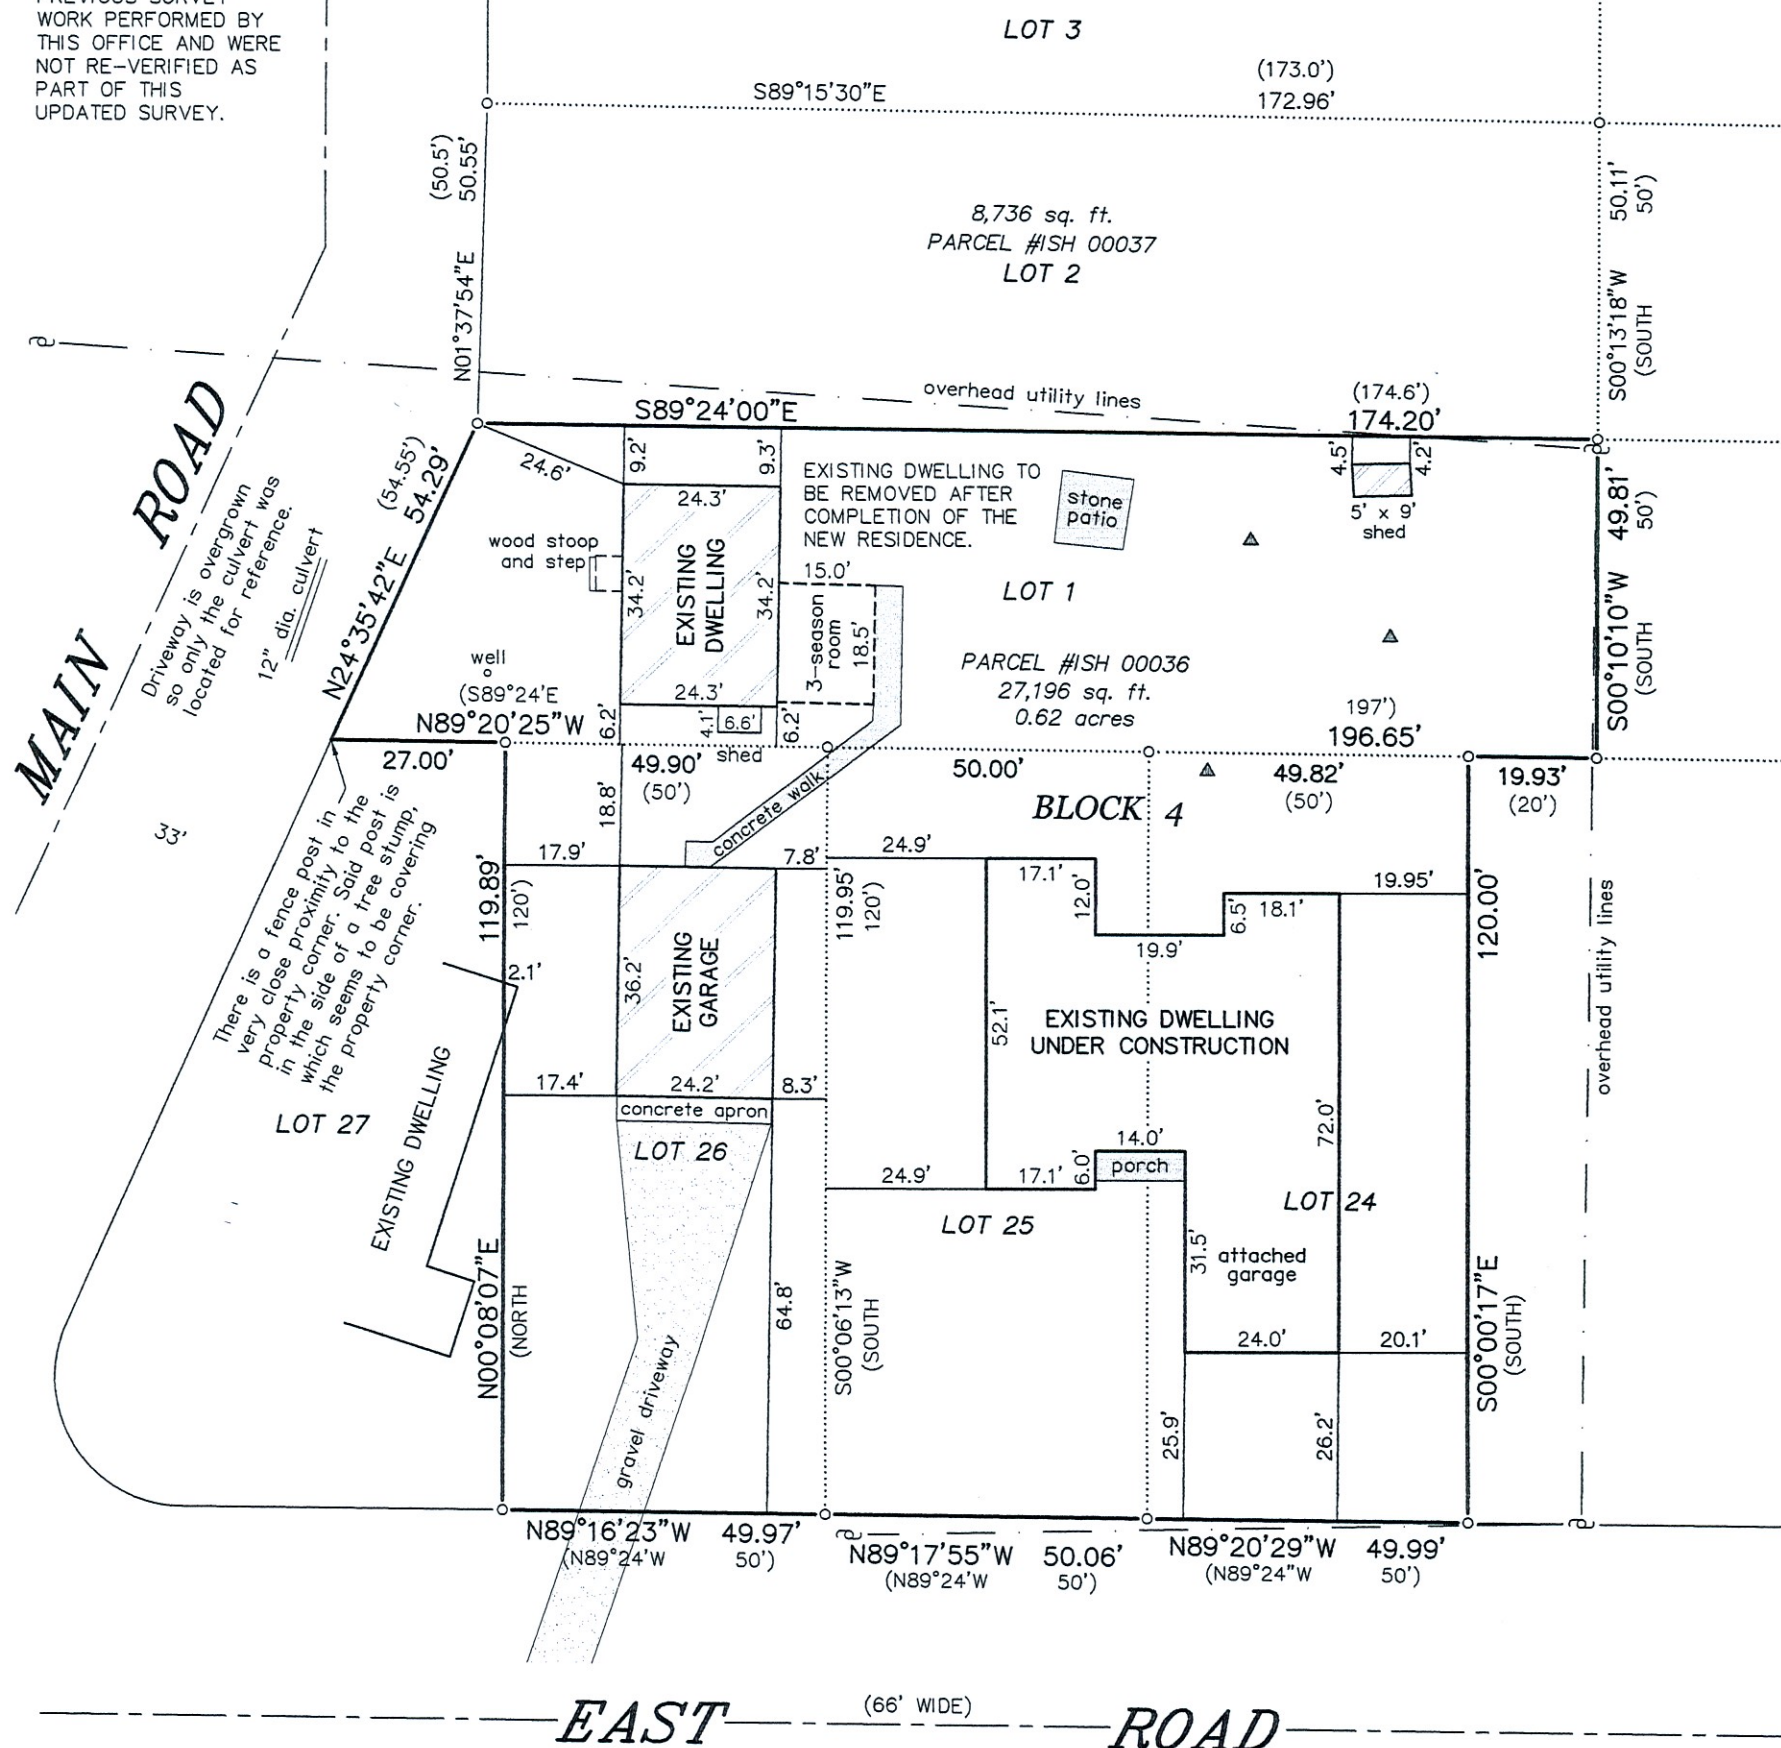

LEGEND

- FOUND IRON PIPE
- SET IRON PIPE
- () RECORDED AS
- ∞ UTILITY POLE
- OVERHEAD UTILITY LINES
- ▲ SOIL BORING

BEARINGS HEREON RELATE TO THE NORTH LINE
OF LOT 1 IN BLOCK 4 OF "SUNSET HILLS".
ASSUMED BEARING OF SOUTH 89°24'00" EAST.

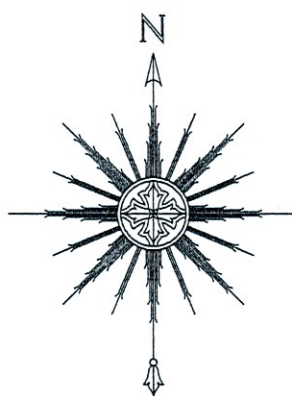

"I HEREBY CERTIFY THAT I HAVE SURVEYED THE ABOVE DESCRIBED PROPERTY AND THAT THE ABOVE MAP IS A CORRECT REPRESENTATION THEREOF AND SHOWS THE SIZE AND LOCATION OF THE PROPERTY, ITS EXTERIOR BOUNDARIES, THE LOCATION OF ALL VISIBLE STRUCTURES AND DIMENSIONS OF ALL PRINCIPAL BUILDINGS THEREON, BOUNDARY FENCES, APPARENT EASEMENTS, ROADWAYS AND ENCROACHMENTS, IF ANY."

"THIS SURVEY IS MADE FOR THE USE OF THE PRESENT OWNERS OF THE PROPERTY, AND THOSE WHO PURCHASE, MORTGAGE, OR GUARANTEE THE TITLE THERETO WITHIN ONE YEAR FROM DATE HEREOF."

SATTER SURVEYING, LLC
LAND SURVEYS, MAPPING AND PLANNING
272 ORIGIN STREET
BURLINGTON, WI 53105
262-661-4239

THIS IS NOT AN ORIGINAL PRINT
UNLESS THIS SEAL IS RED.

Thomas L. Satter

REVISÉ: 8/9/22
REVISÉ: 3/22/22
MARCH 16, 2022
DATE

122102d2

JOB NUMBER

0 15' 30' 60'

SCALE: 1" = 30'