


PLAT OF SURVEY

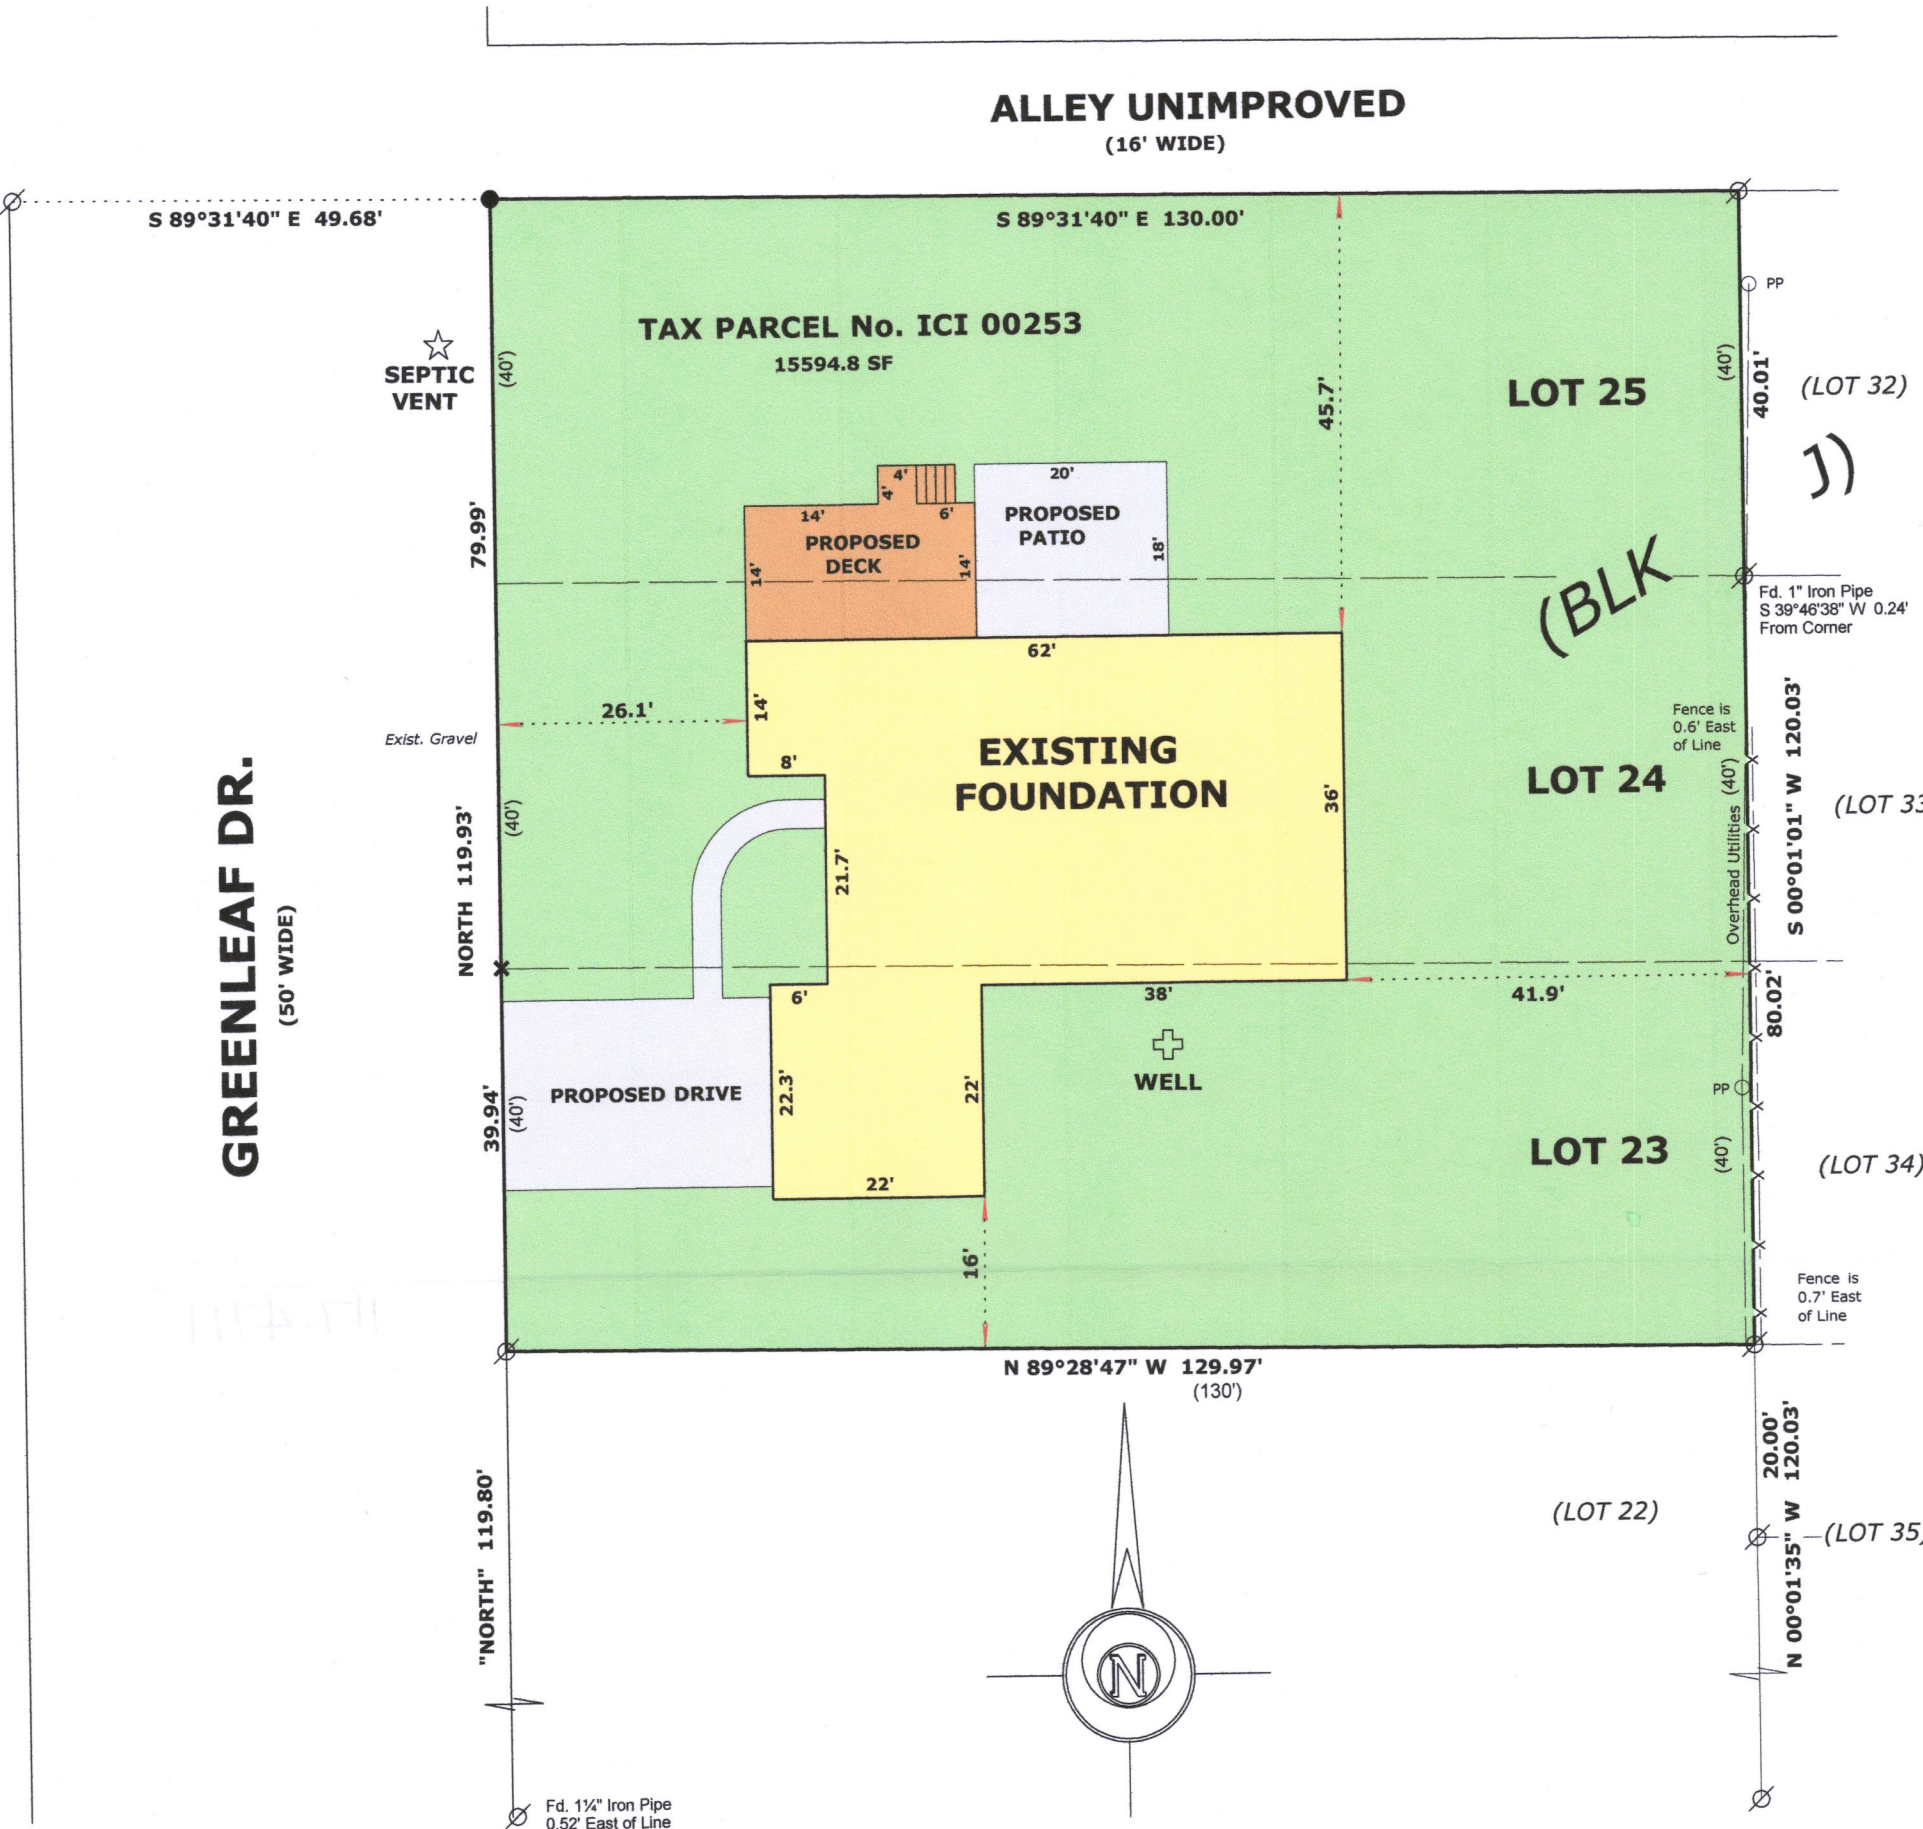

GREENLEAF DR.
(50' WIDE)

ALLEY UNIMPROVED
(16' WIDE)

TAX PARCEL No. ICI 00253
15594.8 SF

LOT 25 (LOT 32)

LOT 24 (LOT 33)

LOT 23 (LOT 34)

(LOT 22) (LOT 35)



- LEGEND**
- X FOUND POSEY PIN
 - Ø FOUND IRON PIPE
 - SET IRON ROD, 18" LONG, WEIGHING 1.5 LBS./LINEAL FT., 3/4" DIA.
 - (xx) RECORDED AS DIMENSION
 - x-x- EXISTING FENCE

SCALE: 1 INCH = 20 FEET

LEGAL DESCRIPTION:

LOCATED IN THE NORTHWEST 1/4 OF THE NORTHEAST 1/4, SECTION 5,
TOWNSHIP 1 NORTH, RANGE 17 EAST, IN THE TOWN OF LINN, WALWORTH
COUNTY, WISCONSIN

LOTS 23, 24 & 25, BLOCK J, CISCO BEACH SUBDIVISION

"I hereby certify that the above described property has been surveyed by me or under my direction and that the above map is a true representation thereof and shows the size and location of the property, its exterior boundaries, the location of all visible structures and dimensions of all principal buildings thereon, boundary fences, apparent easements, roadways and visible encroachments, if any."
"This survey is made for the use of the present owners of the property, and also those who purchase, mortgage, or guarantee the title thereto within one year from date hereof."

Mark L. Miritz
MARK L. MIRITZ
WISCONSIN PROFESSIONAL
LAND SURVEYOR S-2582
DATE: April 7, 2022 JOB NO. 22.302

8/9/2022 REVISED TO SHOW FOUNDATION AS BUILT
4/08/2022 Revised Proposed Residence Location