


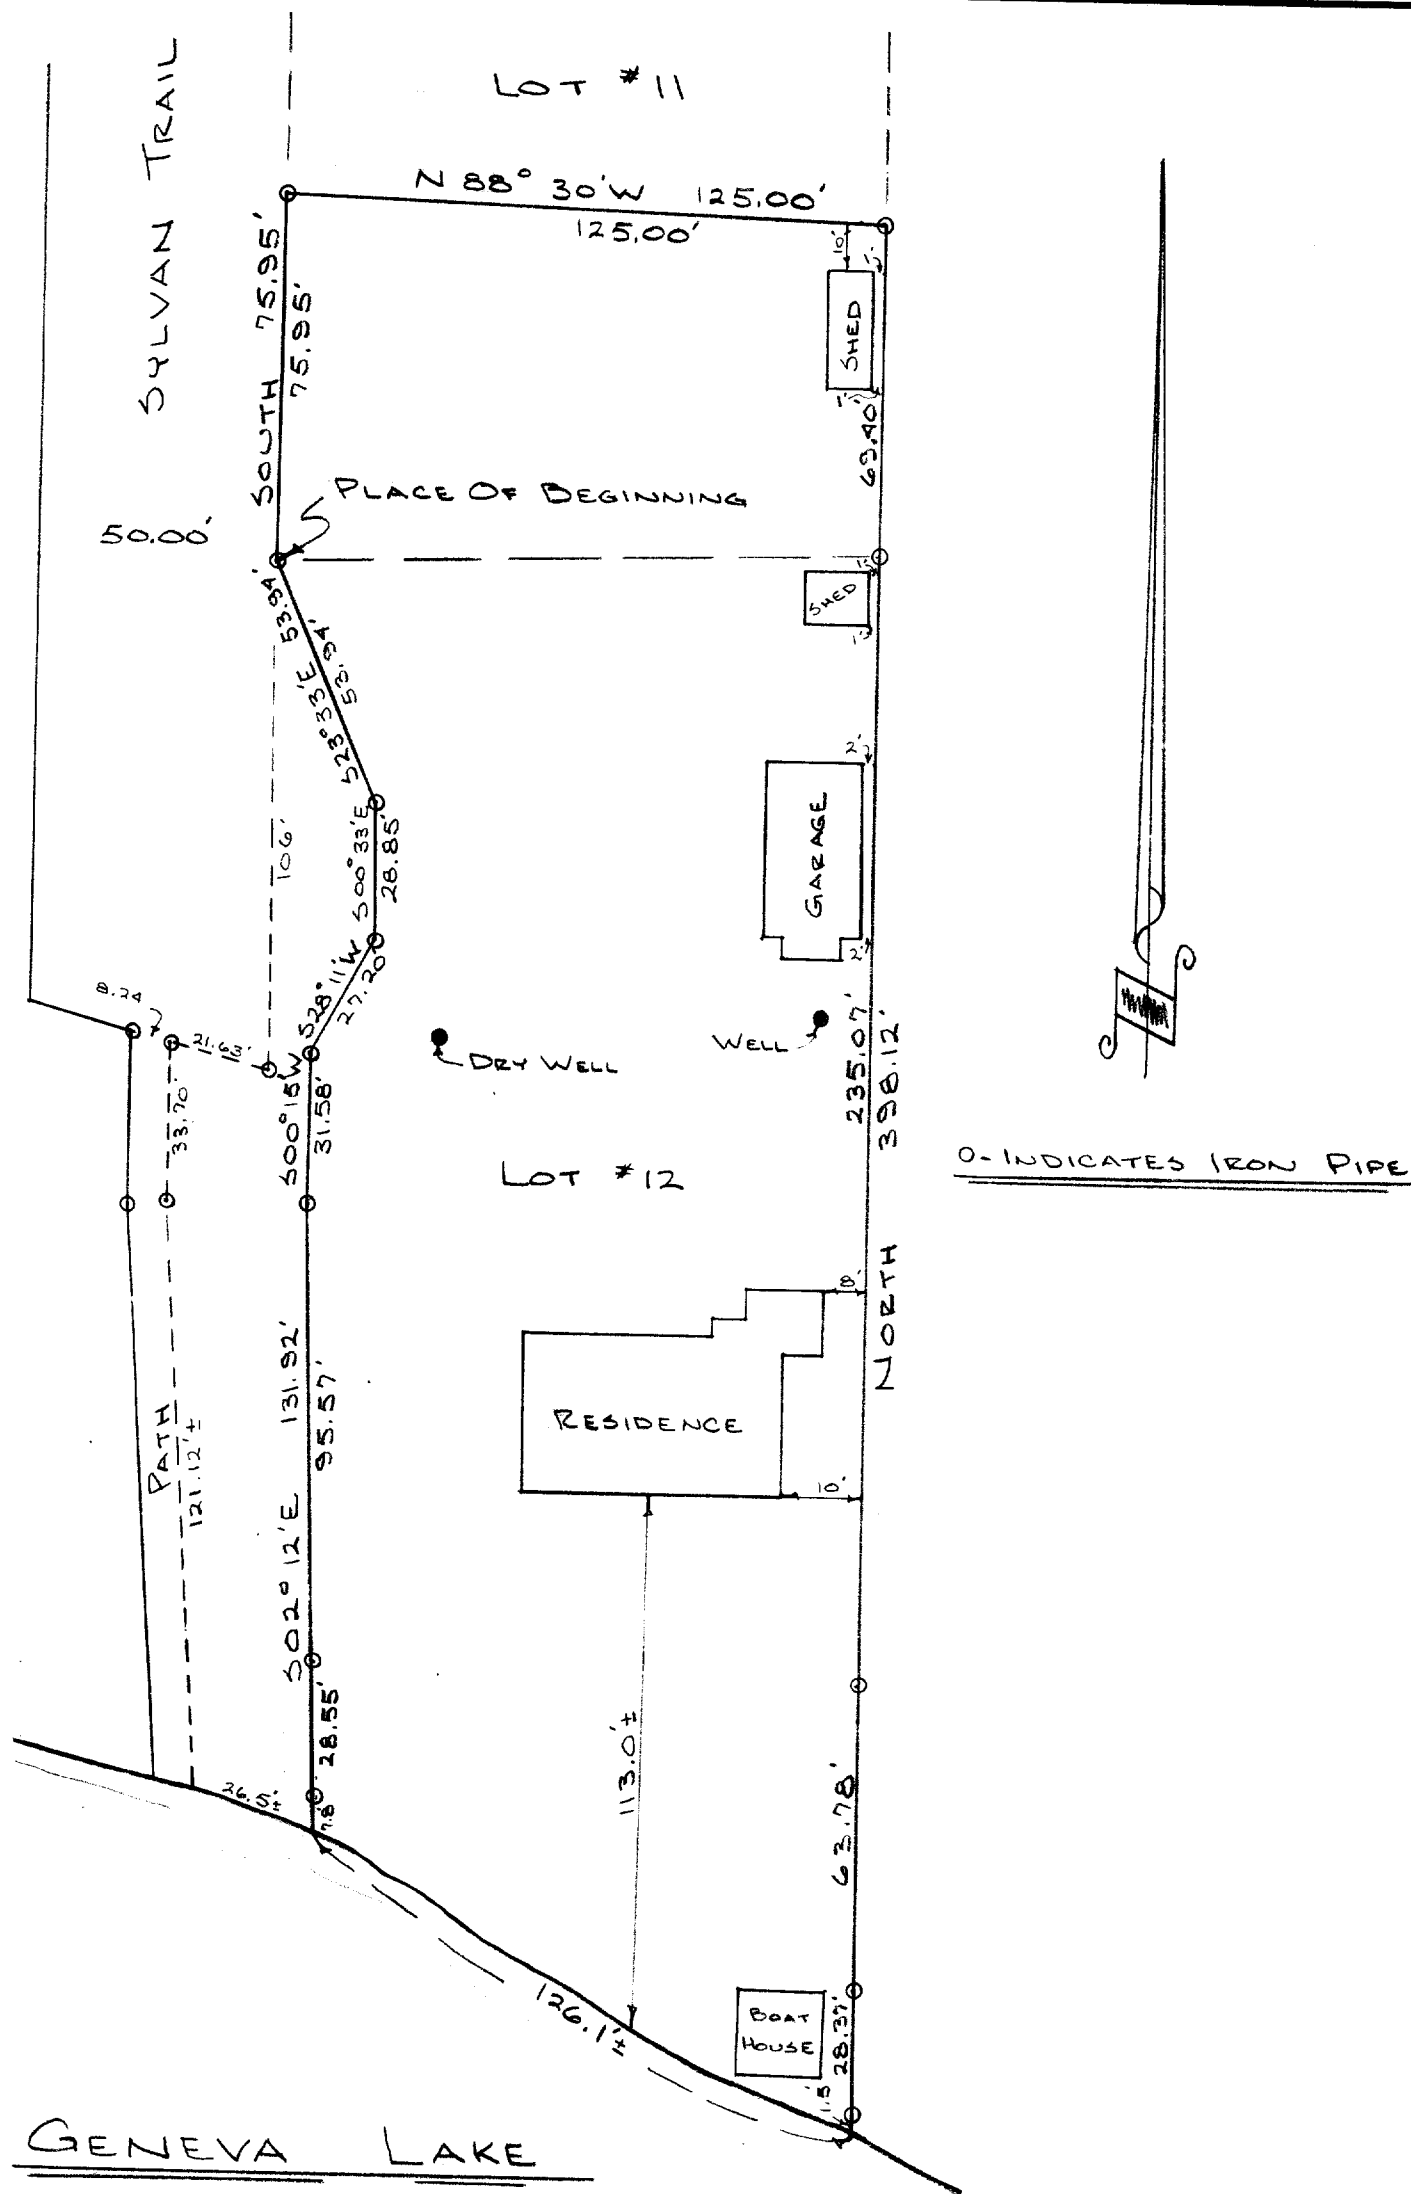


DESCRIPTION: Parts of Lots 11 and 12 of Sylvan Trail Estates, located in Section 5, Town 1 north, Range 17 east of Walworth County, Wisconsin, described as follows, to-wit: Beginning at the northwest corner of said Lot 12, thence South $23^{\circ} 33'$ East 53.94 feet; thence South $0^{\circ} 33'$ East 28.85 feet; thence South $28^{\circ} 11'$ West 27.20 feet; thence South $0^{\circ} 15'$ West 31.58 feet; thence South $2^{\circ} 12'$ East 131.92 feet to the shore of Lake Geneva, thence southeasterly along the shore 126.1 feet more or less to the east line of said Lot 12; thence North along the east line of said Lots 12 and 11, 398.12 feet to an iron pipe; thence North $88^{\circ} 30'$ West 125.00 feet to the place of beginning. Also an easement for purpose of ingress and egress over and across that 50 foot strip lying between Lots 4 and 5 and Outlots 1 and 2 of Sylvan Trail Estates, leading from the Sylvan Trail on and to the public highway.

CERTIFICATE: I, James F. Biagi surveyor do hereby certify that I have surveyed the property hereon portrayed and described.

James F. Biagi RLS 272
Elkhorn, Wisconsin.

Dated: April 15th 1971

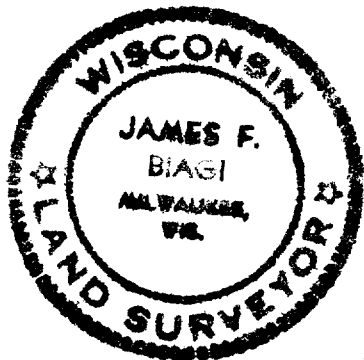

REVISIONS			PLAT OF SURVEY FOR		
NO.	DATE	BY	HOWARD VAUGHN		
1			DRAWN BY AWR	SCALE 1"=40'-0"	MATERIAL
2					
3					
4					
5					
			CHK'D	DATE APRIL 15, 1971	DRAWING NO.
			TRACED	APP'D	

57-4