



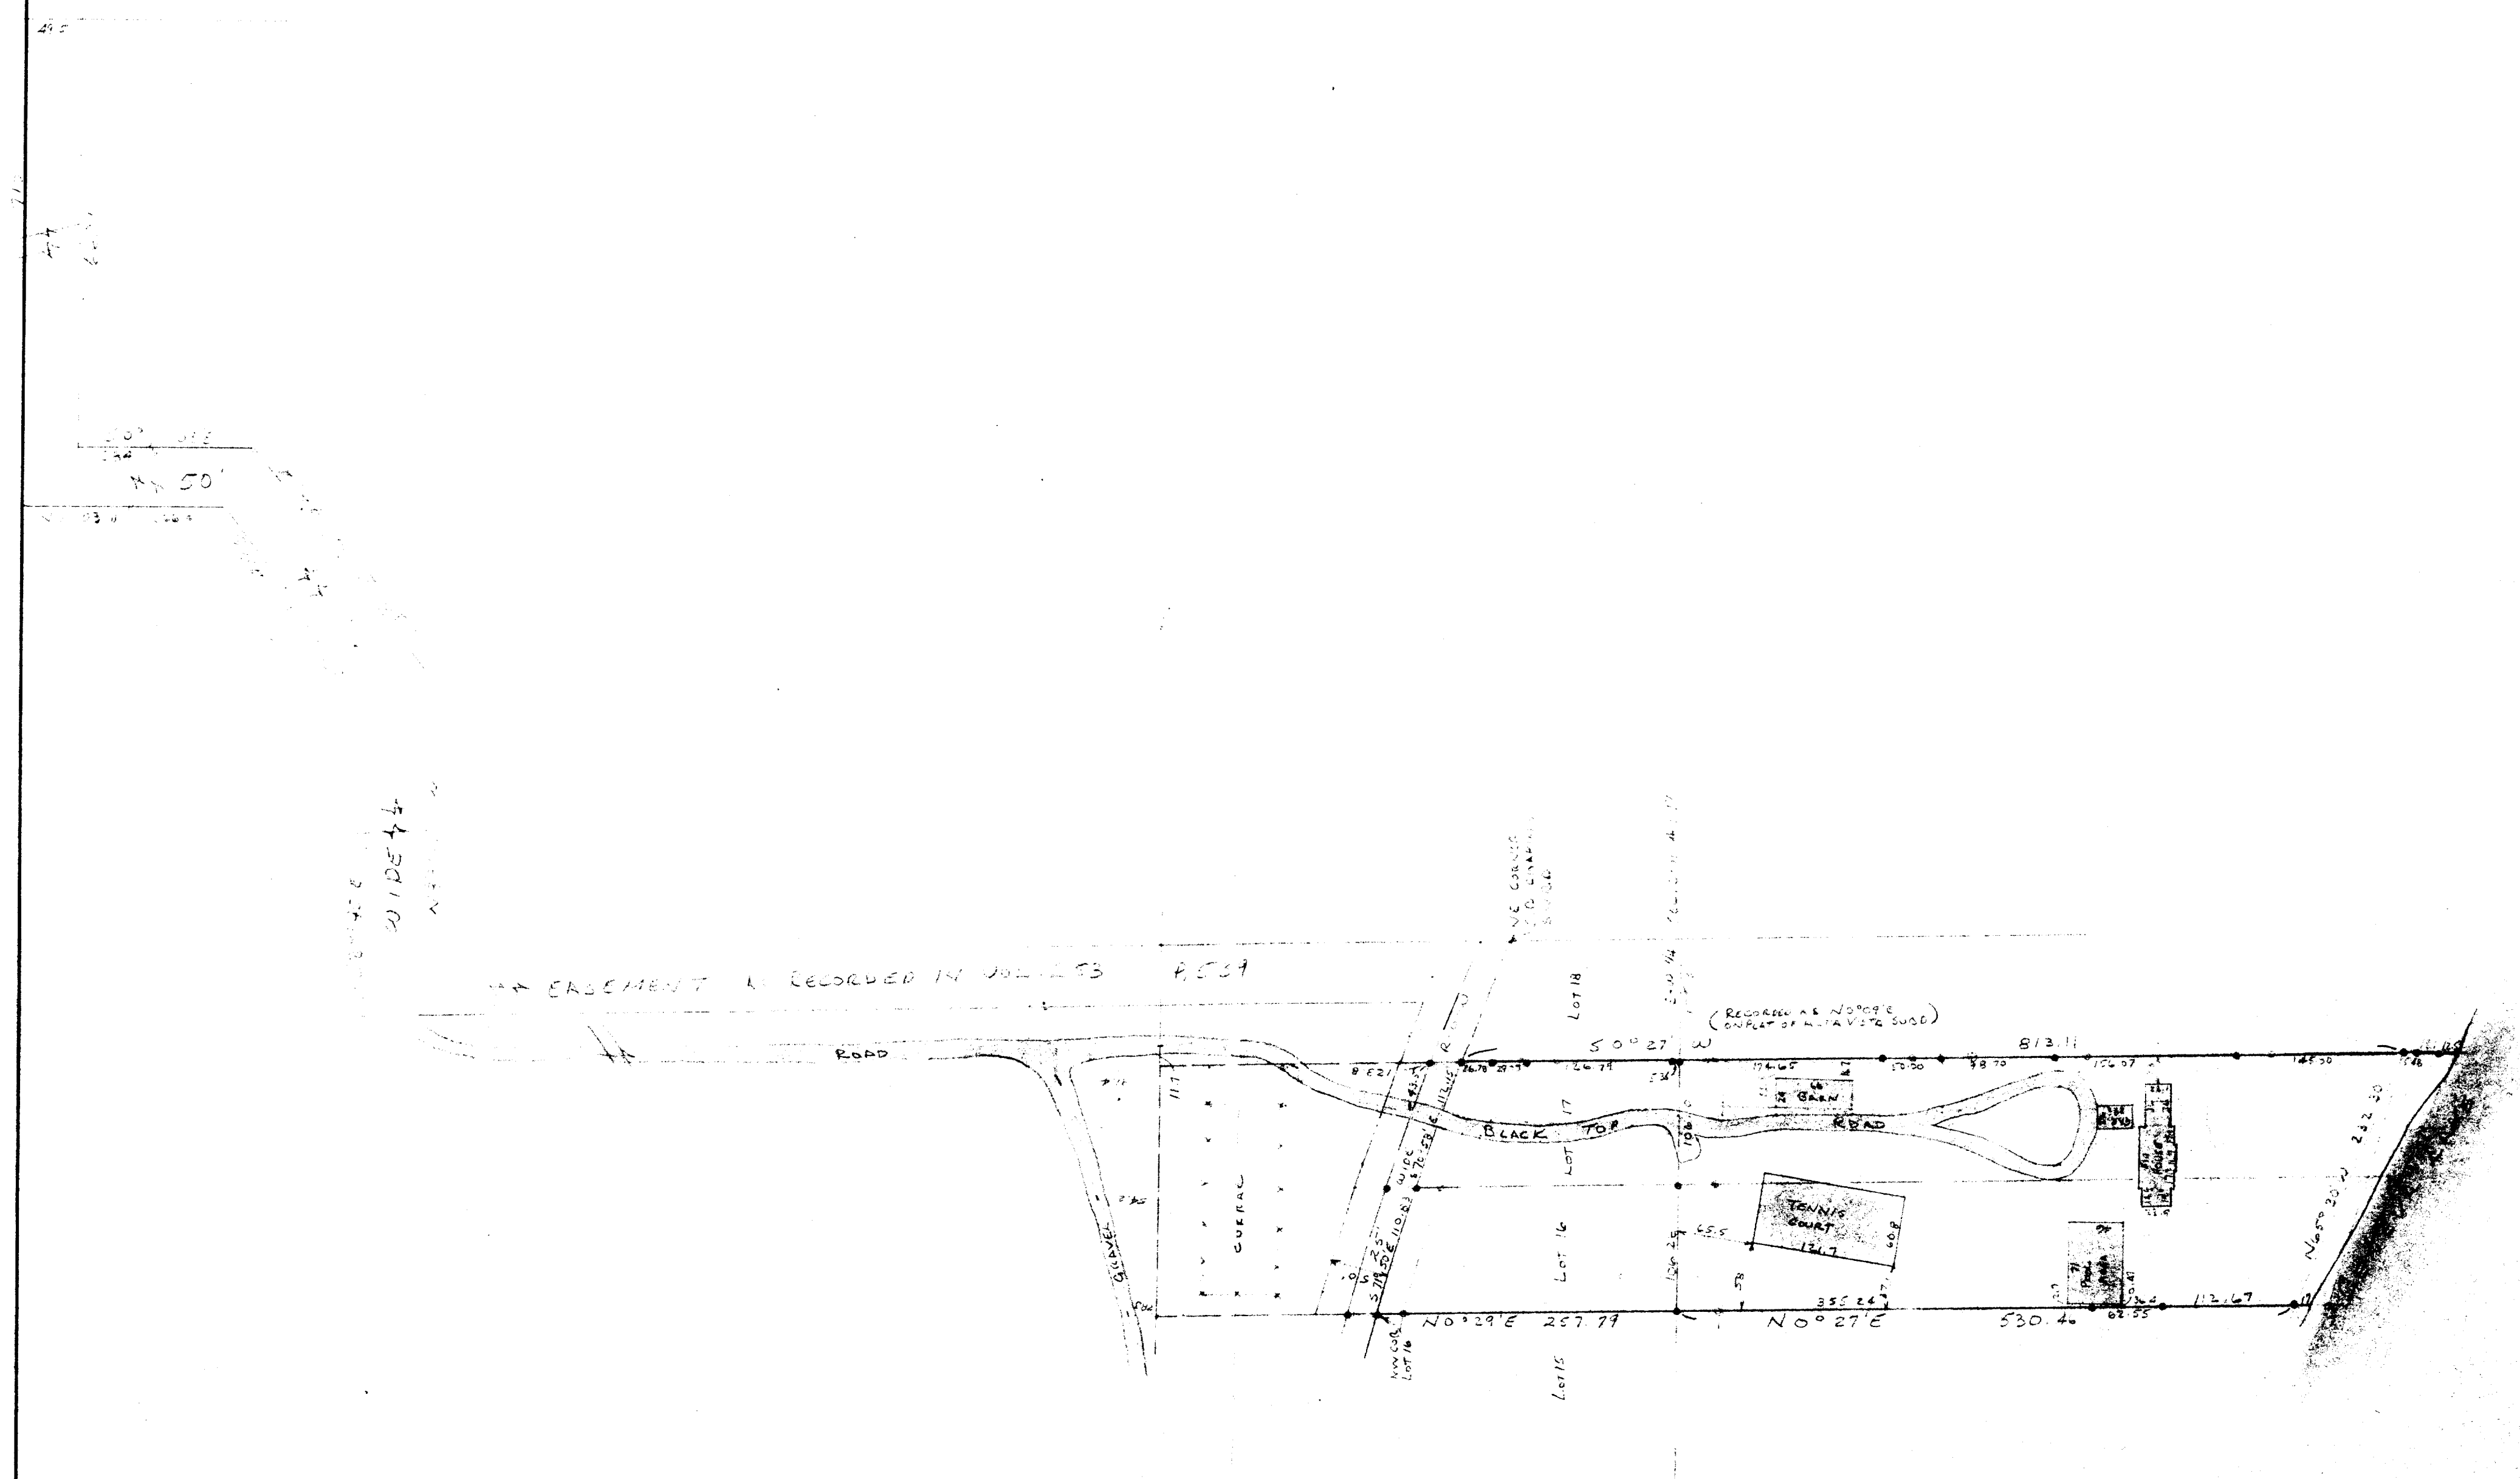

LEGEND

- FOUND IRON PIPE
- ✱ FOUND CONCRETE MONUMENT

ICH-4

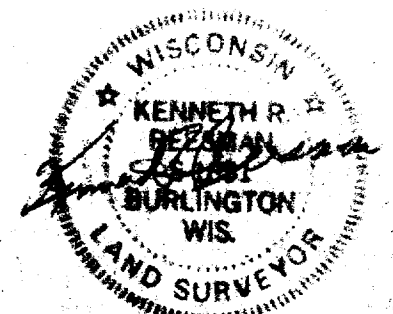

PLAT OF SURVEY & BUILDING LOCATION FOR JAMES KOCH OF LOTS 16 & 17 OF S.B. CHAPIN'S SUBDIVISION LOCATED IN THE SW 1/4 & SE 1/4 OF SEC. 4 T. 17 N. TOWN OF LINN, WALWORTH COUNTY, WISCONSIN		
DATE 8-22-77	ROBERS & BOYD, INC. CONSULTING ENGINEERS 116 E. CHESTNUT ST. BURLINGTON, WIS. (414) 763-2652	JOB NO. 77173
SCALE 1"=100'		CHECKED
DRAWN All		SHEET 1 of 1
REVISED		