


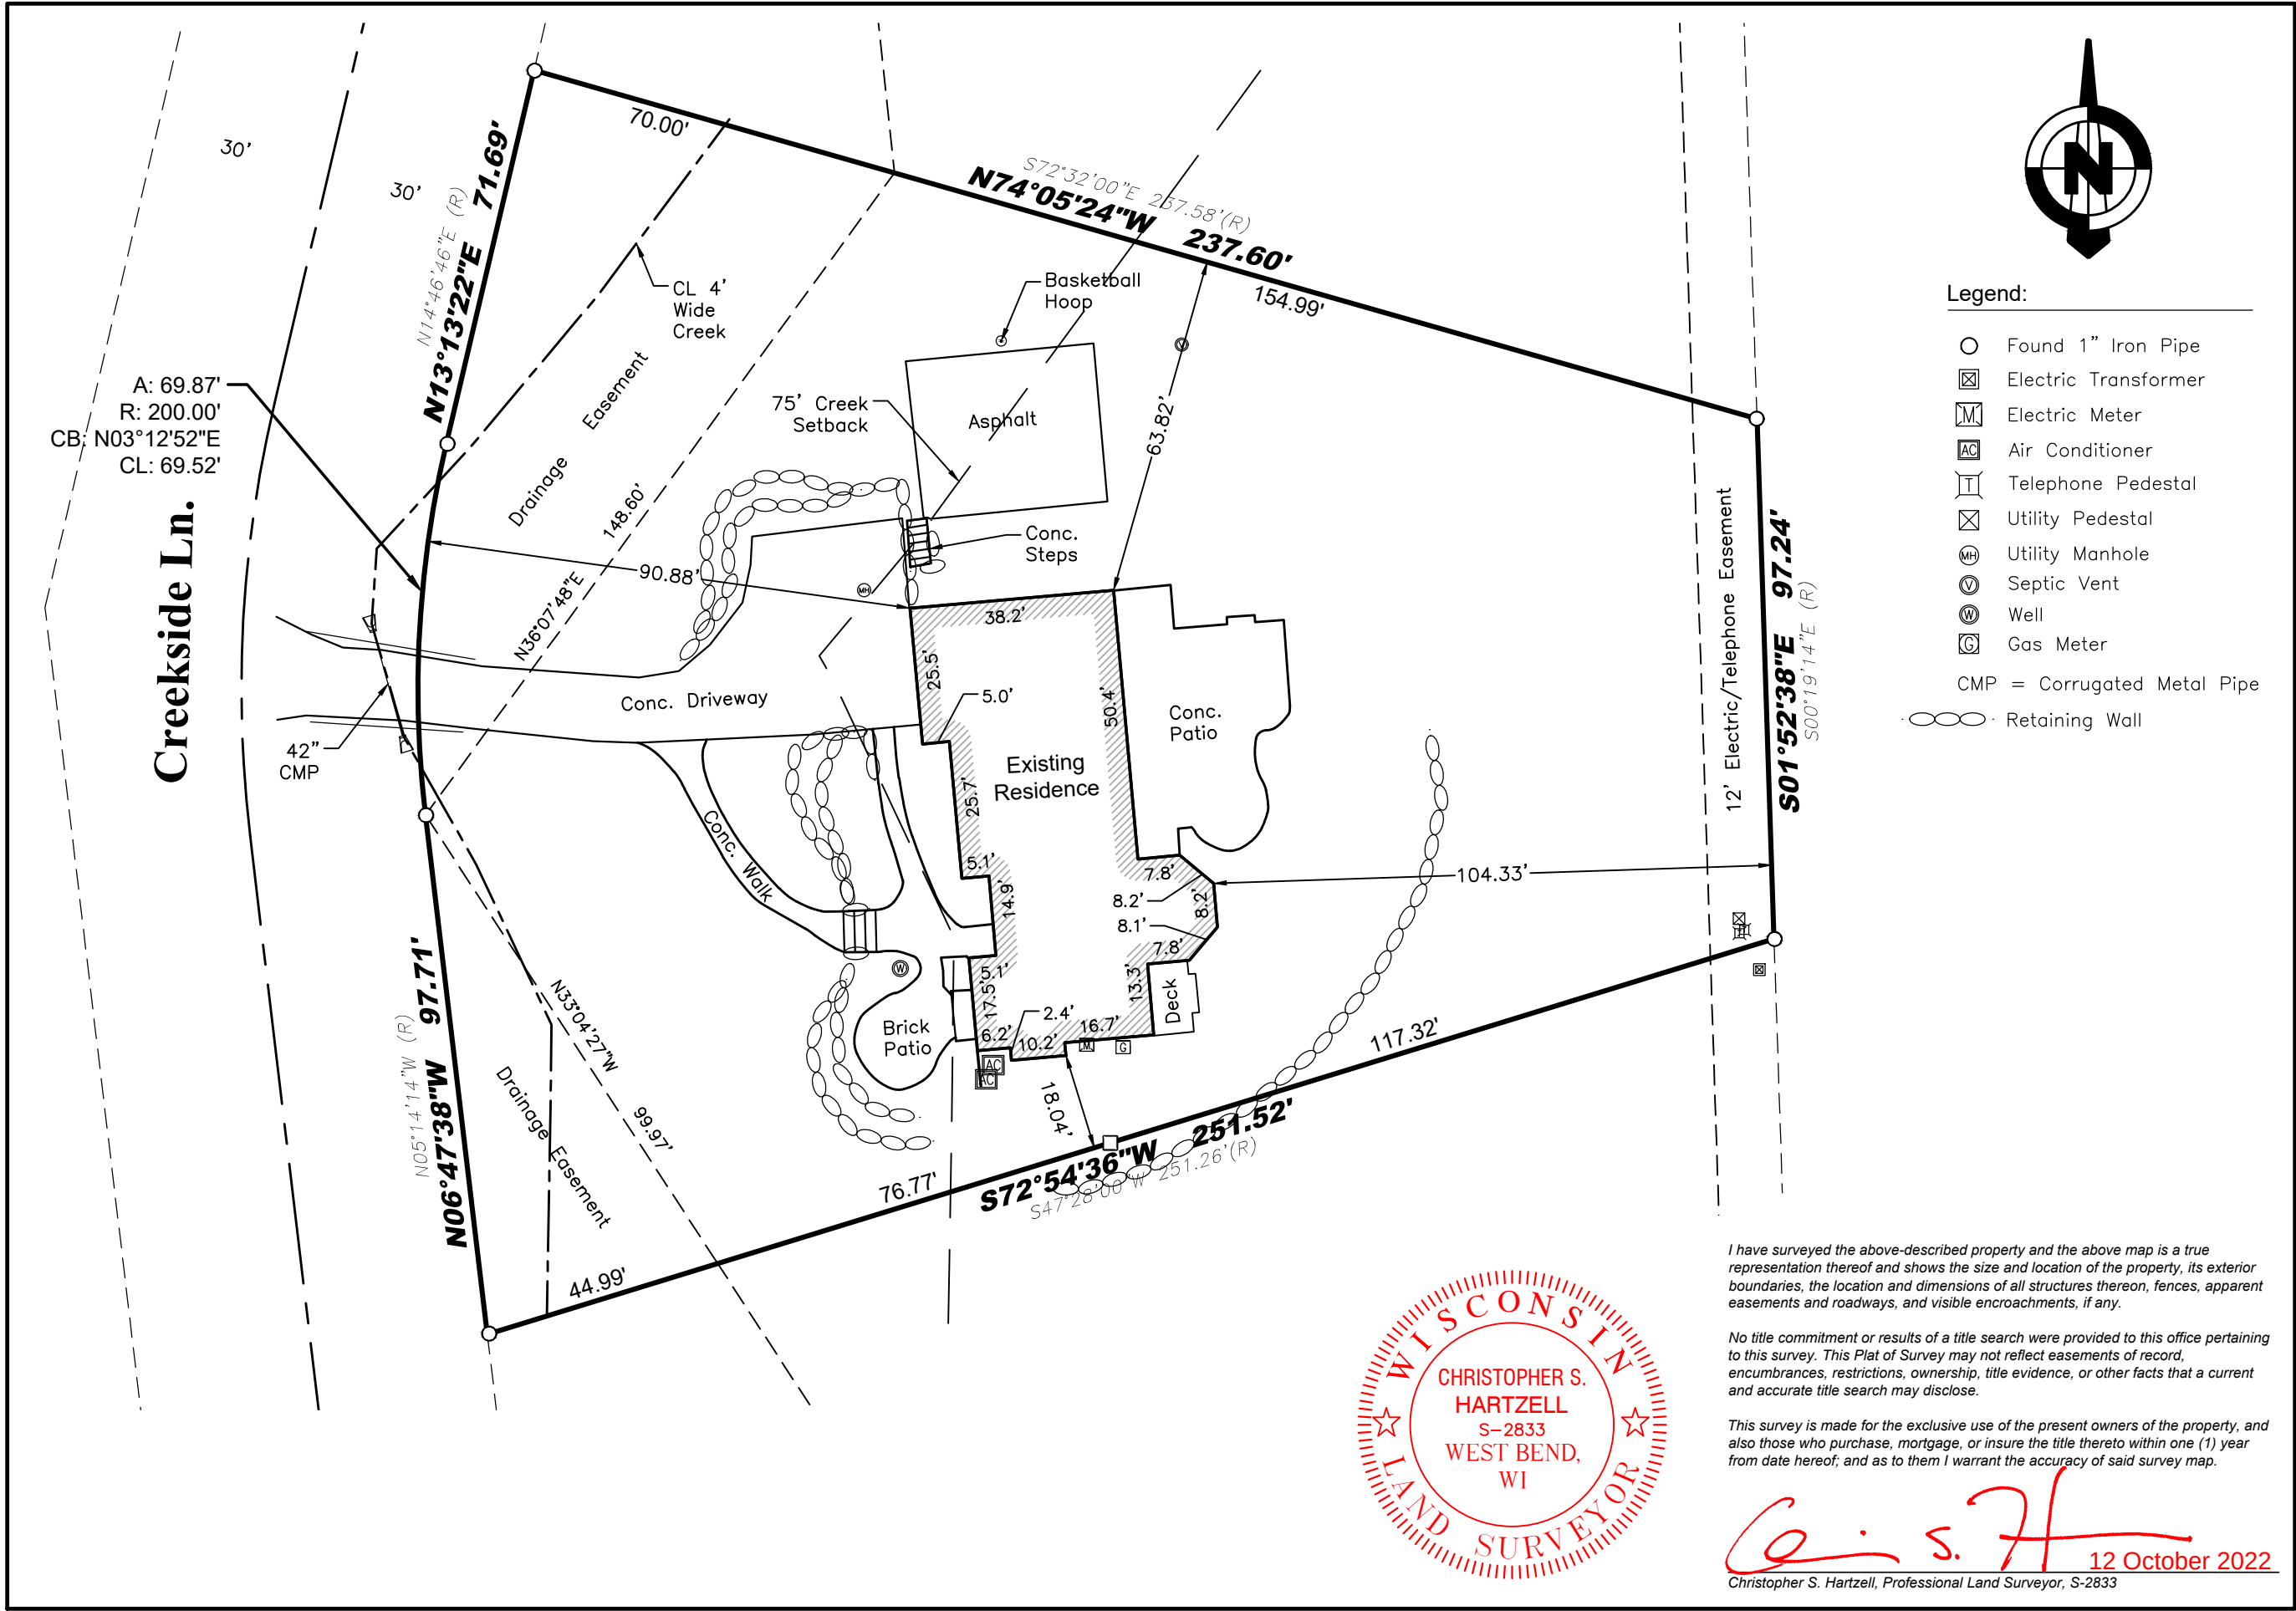

Tax ID: IAE00004

Legal Description: Lot 4 Academy Estates, being a part of the Northeast fractional 1/4 and part of the Southeast 1/4 of Section 18, Township 1 North, Range 17 East, Town of Linn, Walworth County, Wisconsin

Plat of Survey for Steve Schwefel

1558 N. Creekside Lane, Lake Geneva, WI

0 30'

SCALE

Project No. 22.5080

Drawn By: TJM

Field Work: LG

LYNCH & ASSOCIATES  
ENGINEERING CONSULTANTS, LLC

5482 S. WESTRIDGE DRIVE  
NEW BERLIN, WI 53151

440 MILWAUKEE AVENUE  
BURLINGTON, WI 53105

(262) 402-5040