




Vanderstappen  
Land Surveying, Inc.  
www.vandersinc.com  
1316 N. Madison St.  
Woodstock, Illinois 60098  
ph. 815-337-8310 fax 815-337-8314  
"Always faithful to the property line"


# BOUNDARY AND TOPOGRAPHIC SURVEY

Lot 21 in the Subdivision known as Lake Geneva Beach which is a portion of Lot 4 in Section 11, Township 1 North, Range 17 East of the Third Principal Meridian, Walworth County, State of Wisconsin.

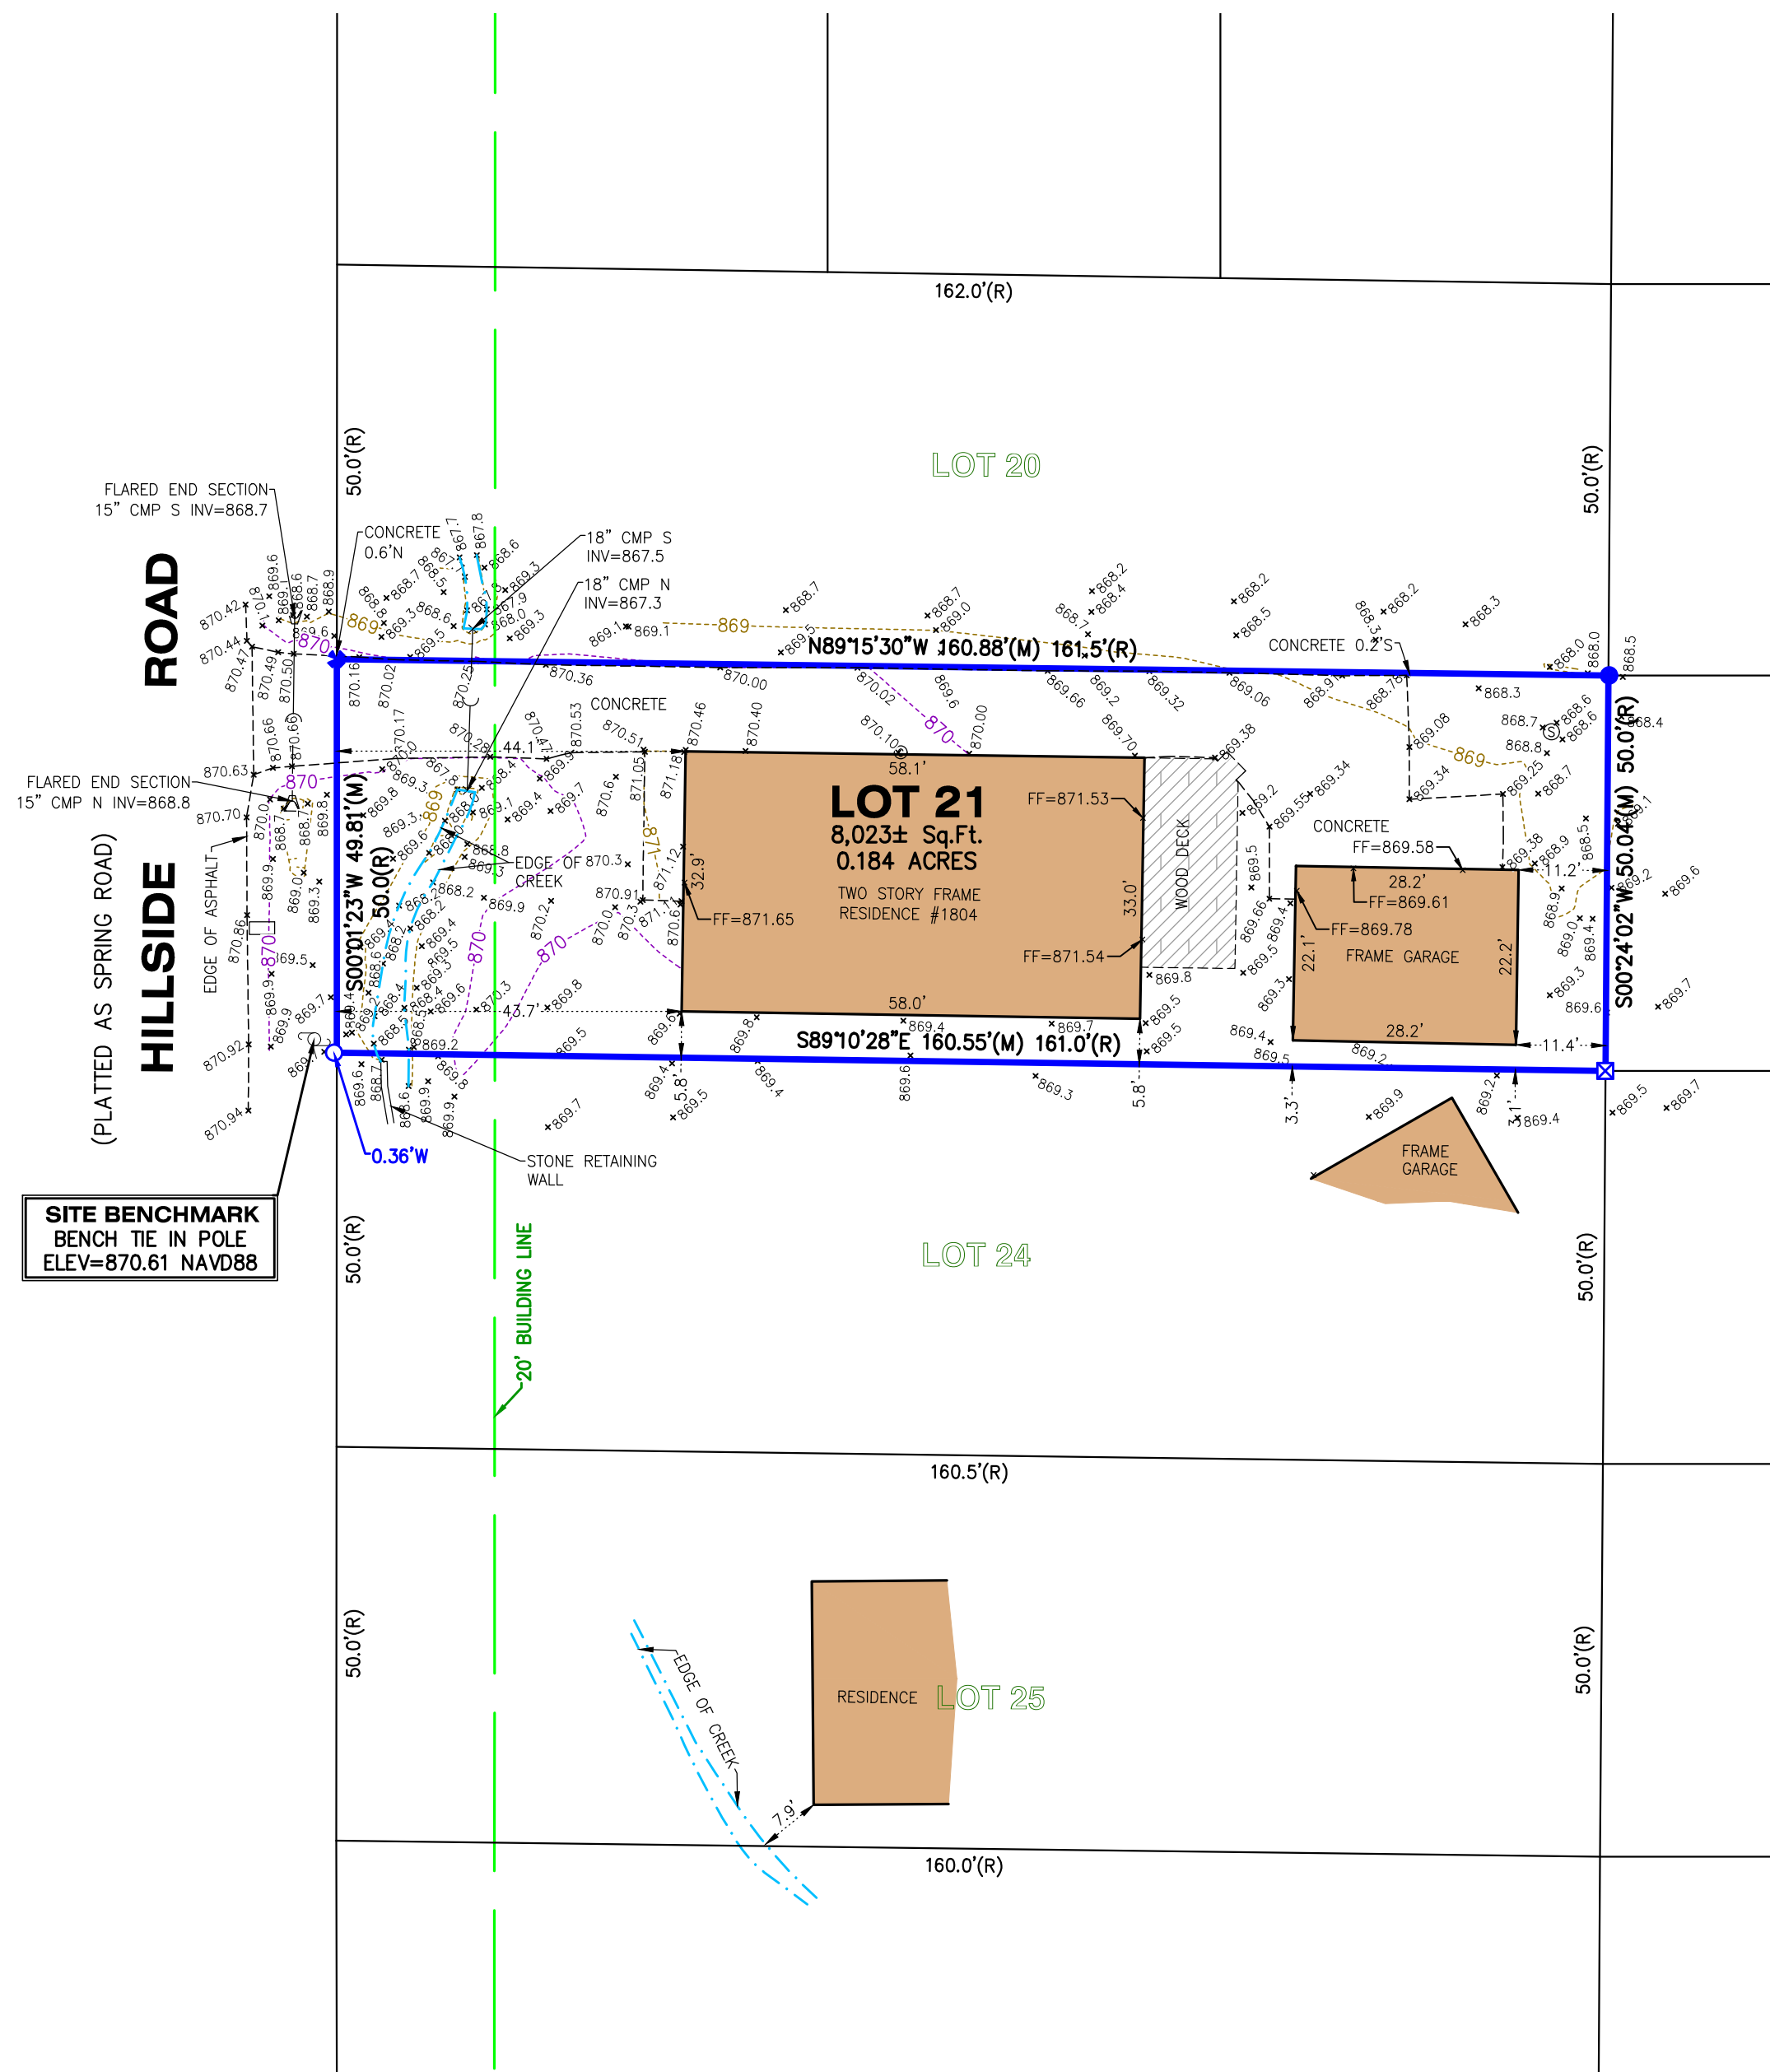

| LEGEND |                    |
|--------|--------------------|
| ⊙      | CLEAN OUT          |
| ▷      | FLARED END SECTION |
| •      | FOUND CROSS        |
| ✱      | FOUND IRON BAR     |
| ○      | FOUND IRON PIPE    |
| ⊠      | FOUND MONUMENT     |
| □      | MAIL BOX           |
| ⊙      | SEPTIC LID         |
| ⊙      | UTILITY POLE       |
| (D)    | DEED               |
| (R)    | RECORD             |
| (M)    | MEASURE            |

PROJECT BENCHMARK  
SOUTHWEST SECTION  
CORNER SEC 11-01-17  
ELEV=911.54 NAVD88

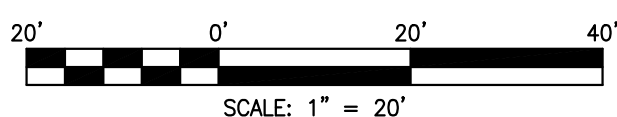

NOTE: Only those Building Line Restrictions or Easements shown on a Recorded Subdivision Plat are shown hereon unless the description ordered to be surveyed contains a proper description of the required building lines or easements.

- \* No distance should be assumed by scaling.
- \* No underground improvements have been located unless shown and noted.
- \* No representation as to ownership, use, or possession should be hereon implied.
- \* This Survey and Plat of Survey are void without original embossed or colored seal and signature affixed.

Compare your description and site markings with this plat and AT ONCE report any discrepancies which you may find.



STATE OF ILLINOIS )  
COUNTY OF McHENRY ) S.S.

In my professional opinion, and based on my observations, I hereby certify that the above described property has been surveyed under my direction and that the above map is a true representation thereof and shows the size and location of all visible structures, and dimensions of all principle buildings thereon, boundary fences, apparent easements, roadways, and visible encroachments, if any. This survey is made for the use of the present owners of the property, and also those who purchase, mortgage, or guarantee the title thereto within one year from the date hereof.

Dated at Woodstock, McHenry County, Illinois 08/26 A.D., 20 22.

Vanderstappen Land Surveying, Inc.  
Design Firm No. 184-002792

By: *Arthur P. Gritmacker*  
Wisconsin Registered Land Surveyor No. S3021

CLIENT: MATT KRAMBECK  
DRAWN BY: SES CHECKED BY: APG  
SCALE: 1"=20' SEC. 11 T. 01 R. 17 E.  
BASIS OF BEARING: ASSUMED  
P.I.N.: JLGB00016  
JOB NO.: 211223-A I.D. TPO  
FIELDWORK COMP.: 08/25/22 BK. PG.  
ALL DISTANCES SHOWN IN FEET AND DECIMAL REF:  
PARTS THEREOF CORRECTED TO 68° F.