



PLAT OF SURVEY

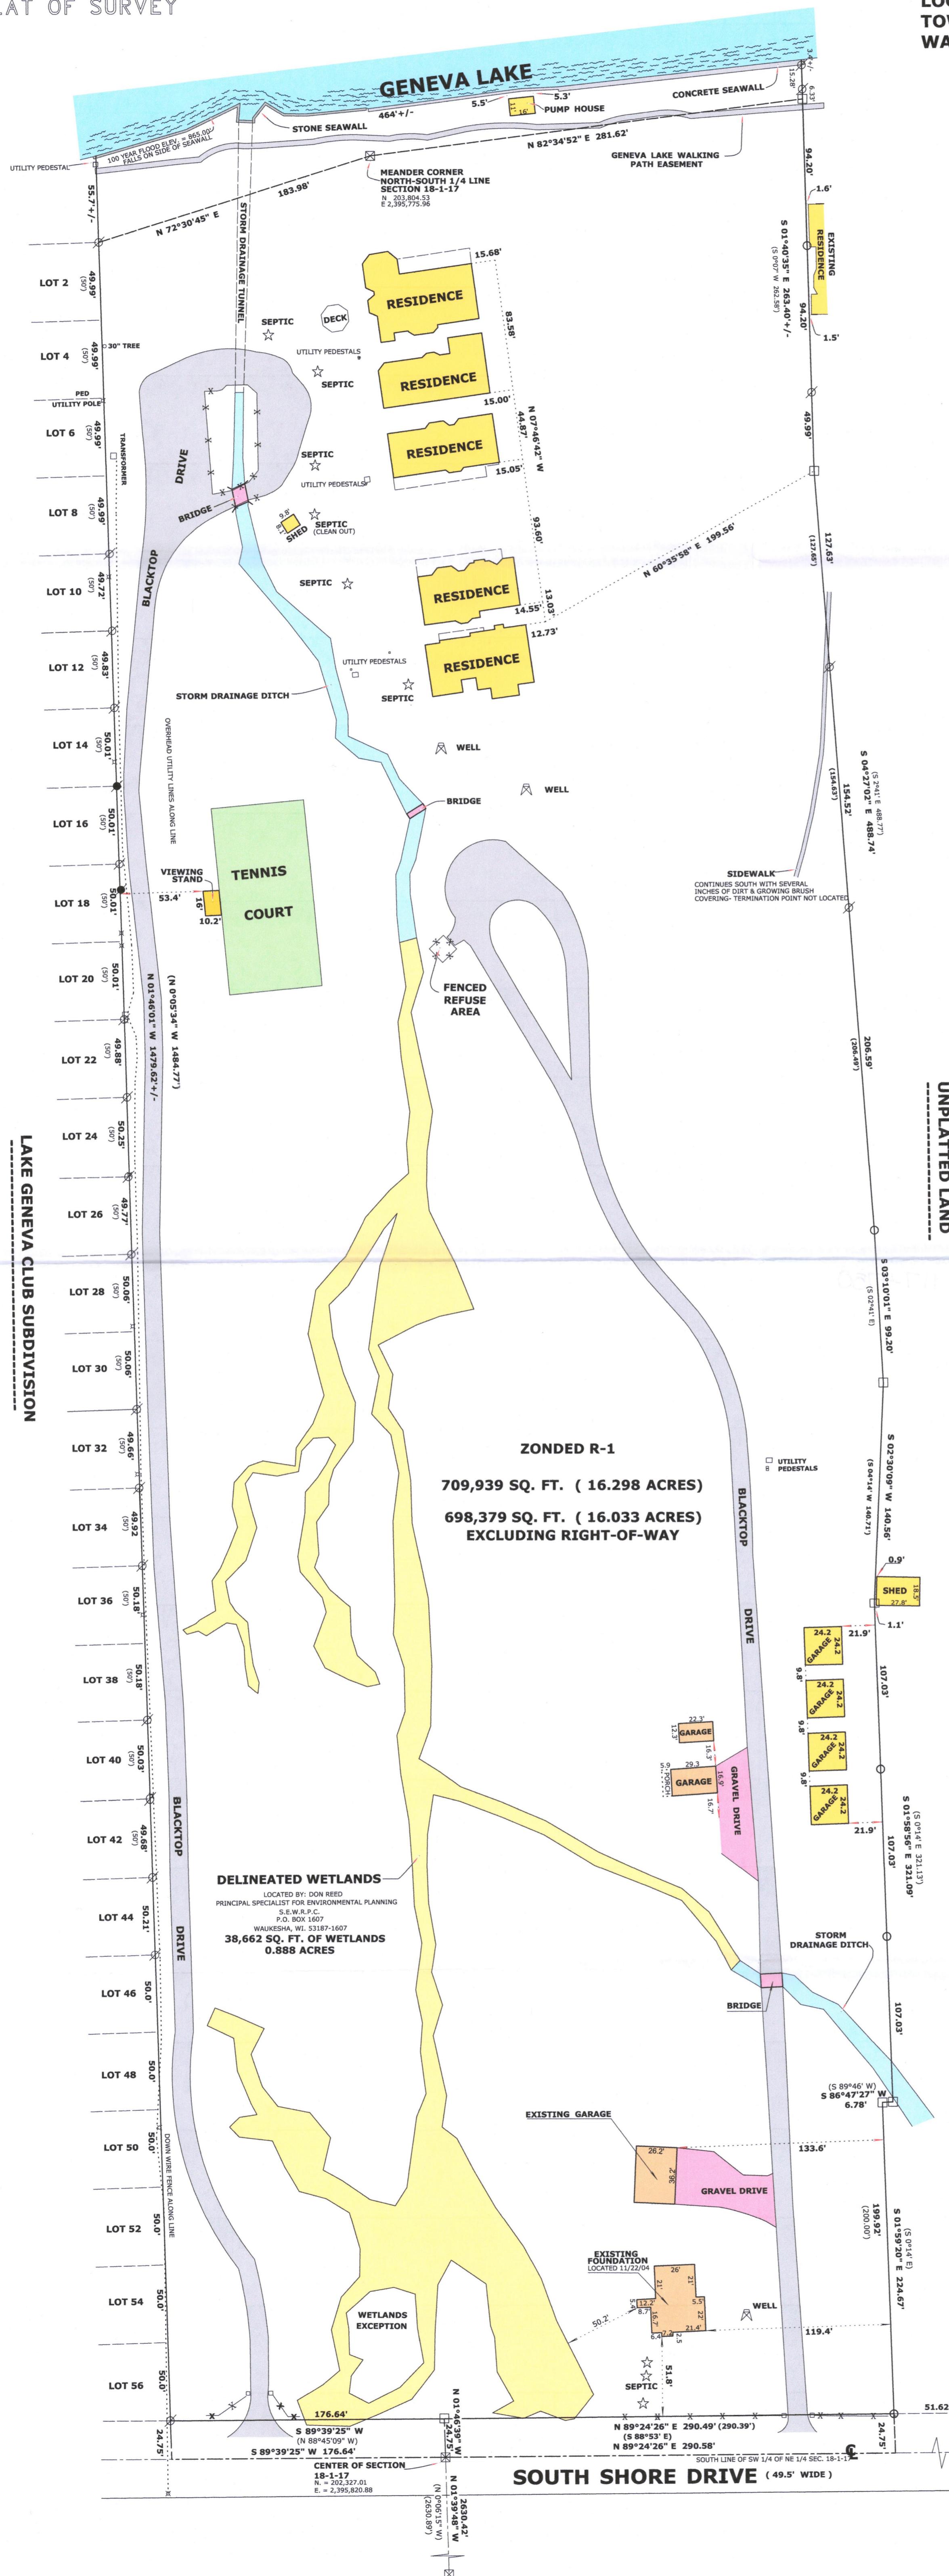


**CHICAGO CLUB OF LAKE GENEVA CONDOMINIUMS,
LOCATED IN PART OF THE NORTH 1/2 OF SECTION 18,
TOWN 1 NORTH, RANGE 17 EAST, LINN TOWNSHIP,
WALWORTH COUNTY, WISCONSIN.**

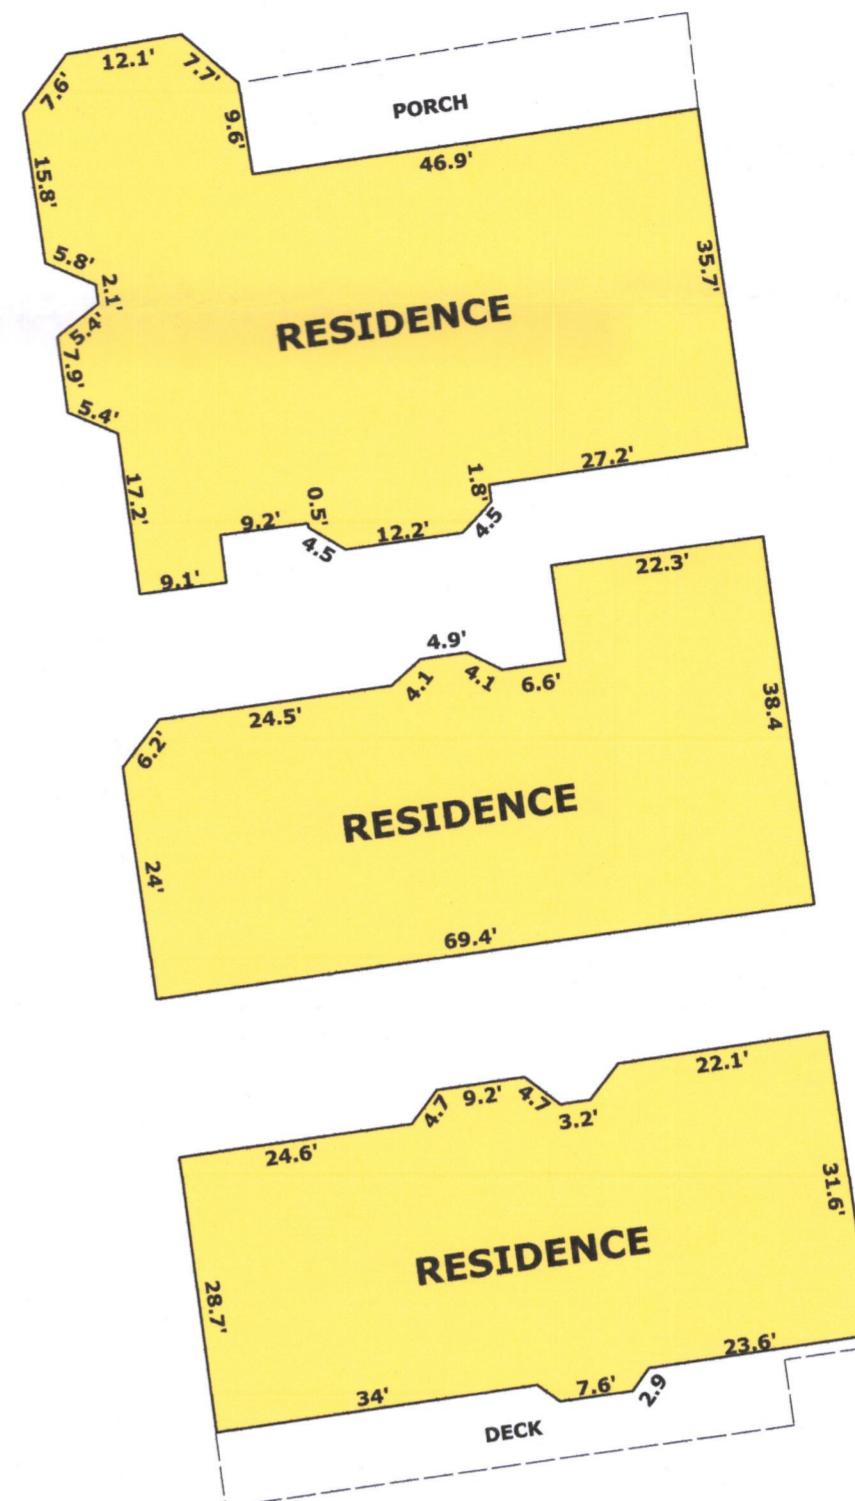

RESIDENCES DETAIL

SCALE: 1 INCH = 20 FEET

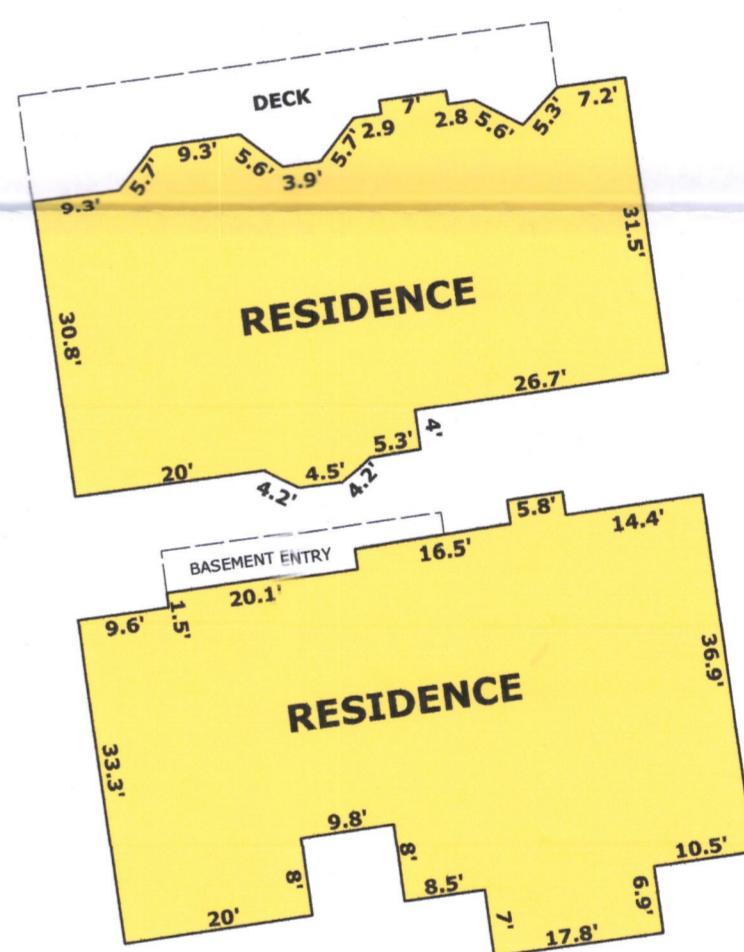

SURVEYOR'S NOTES

SURVEYOR'S NOTES

1.) SEE PREVIOUS PLAT OF SURVEY FOR LEGAL DESCRIPTION FOR THE DELINEATED WETLANDS BY MARK L. MIRITZ DATED OCT. 24, 2004.

2.) PREVIOUS SURVEY (NOTE 1) FOR THE WETLANDS INVENTORY WAS IN STATE PLANE COORDINATES WITH A TIE TO THE EAST 1/4 CORNER. OF SECTION 18-1-17, THIS PLAT USED A 1/16 CORNER (NOT RECOGNIZED BY THE COUNTY) FOR THE CENTERLINE OF SOUTH SHORE DRIVE AND WAS VERIFIED BY FOUND MONUMENTS. THE BEARING OF THE SOUTH LINE OF THE NE 1/4 OF SEC. 18-1-17 IS N 89°30'42" E WITH THE 1/16

Horizontal Datum is based on the Wisconsin State Plane Coordinate System Grid, South Zone, all bearings are referred to Grid North.

LEGEND

 **FOUND IRON PIPE**
 **FOUND IRON ROD**
 **FOUND COUNTY MONUMENT**
 **FOUND CONCRETE MONUMENT**
 **CHISEL CUT IN CONCRETE**
 **SET IRON PIPE, 24" LONG, WEIGHING
1.13 LBS./LINEAL FT., 1 1/4" DIA.**
 **RECORDED AS DIMENSION**
 **BURIED ELECTRIC LINE
MARKED BY OTHERS**

UTILITY POLE WITH OVERHEAD LINES

SCALE: 1" = 50 FEET

Mark L. Miritz
MARK L. MIRITZ
WISCONSIN PROFESSIONAL
LAND SURVEYOR S-2582

**REVISED DEC. 9, 2022 TO SHOW UTILITIES ON WEST LINE
REVISED MAY 31, 2005 TO SHOW GARAGES AS BUILT
REVISED JAN. 7, 2005 TO SHOW PROPOSED GARAGES**

117-4750