


PLAT OF SURVEY AND TOPOGRAPHIC MAPPING LOT 3 OF ROBINSON'S SUBDIVISION

LOCATED IN PART OF THE SW 1/4 OF THE SW 1/4 OF SECTION 11, TOWN 1 NORTH, RANGE 17 EAST,
WALWORTH COUNTY, WISCONSIN

LEGEND

- O = FOUND IRON PIPE STAKE
- = SET IRON REBAR STAKE
- ⊕ = UTILITY POLE LOCATED
- {XXX} = RECORDED AS

ASSIGNED THE SOUTHERLY BOUNDARY OF LOT 3
N 90°00'00" W

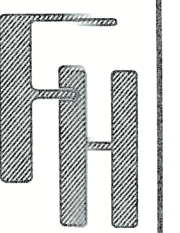


TOPOGRAPHIC SURVEY
N1704 HILLSIDE ROAD
LAKE GENEVA, WISCONSIN

WORK ORDERED BY -
ROBERT CRADER
N1704 HILLSIDE ROAD
LAKE GENEVA, WI 53147

FARRIS, HANSEN & ASSOCIATES, INC.
ENGINEERING - ARCHITECTURE - SURVEYING
7 RIDGWAY COURT
ELKHORN, WISCONSIN 53121
OFFICE: (262) 723-2098 FAX: (262) 723-5886

REVISIONS

PROJECT NO.
10547
DATE:
10/11/2021
SHEET NO.
1 OF 1

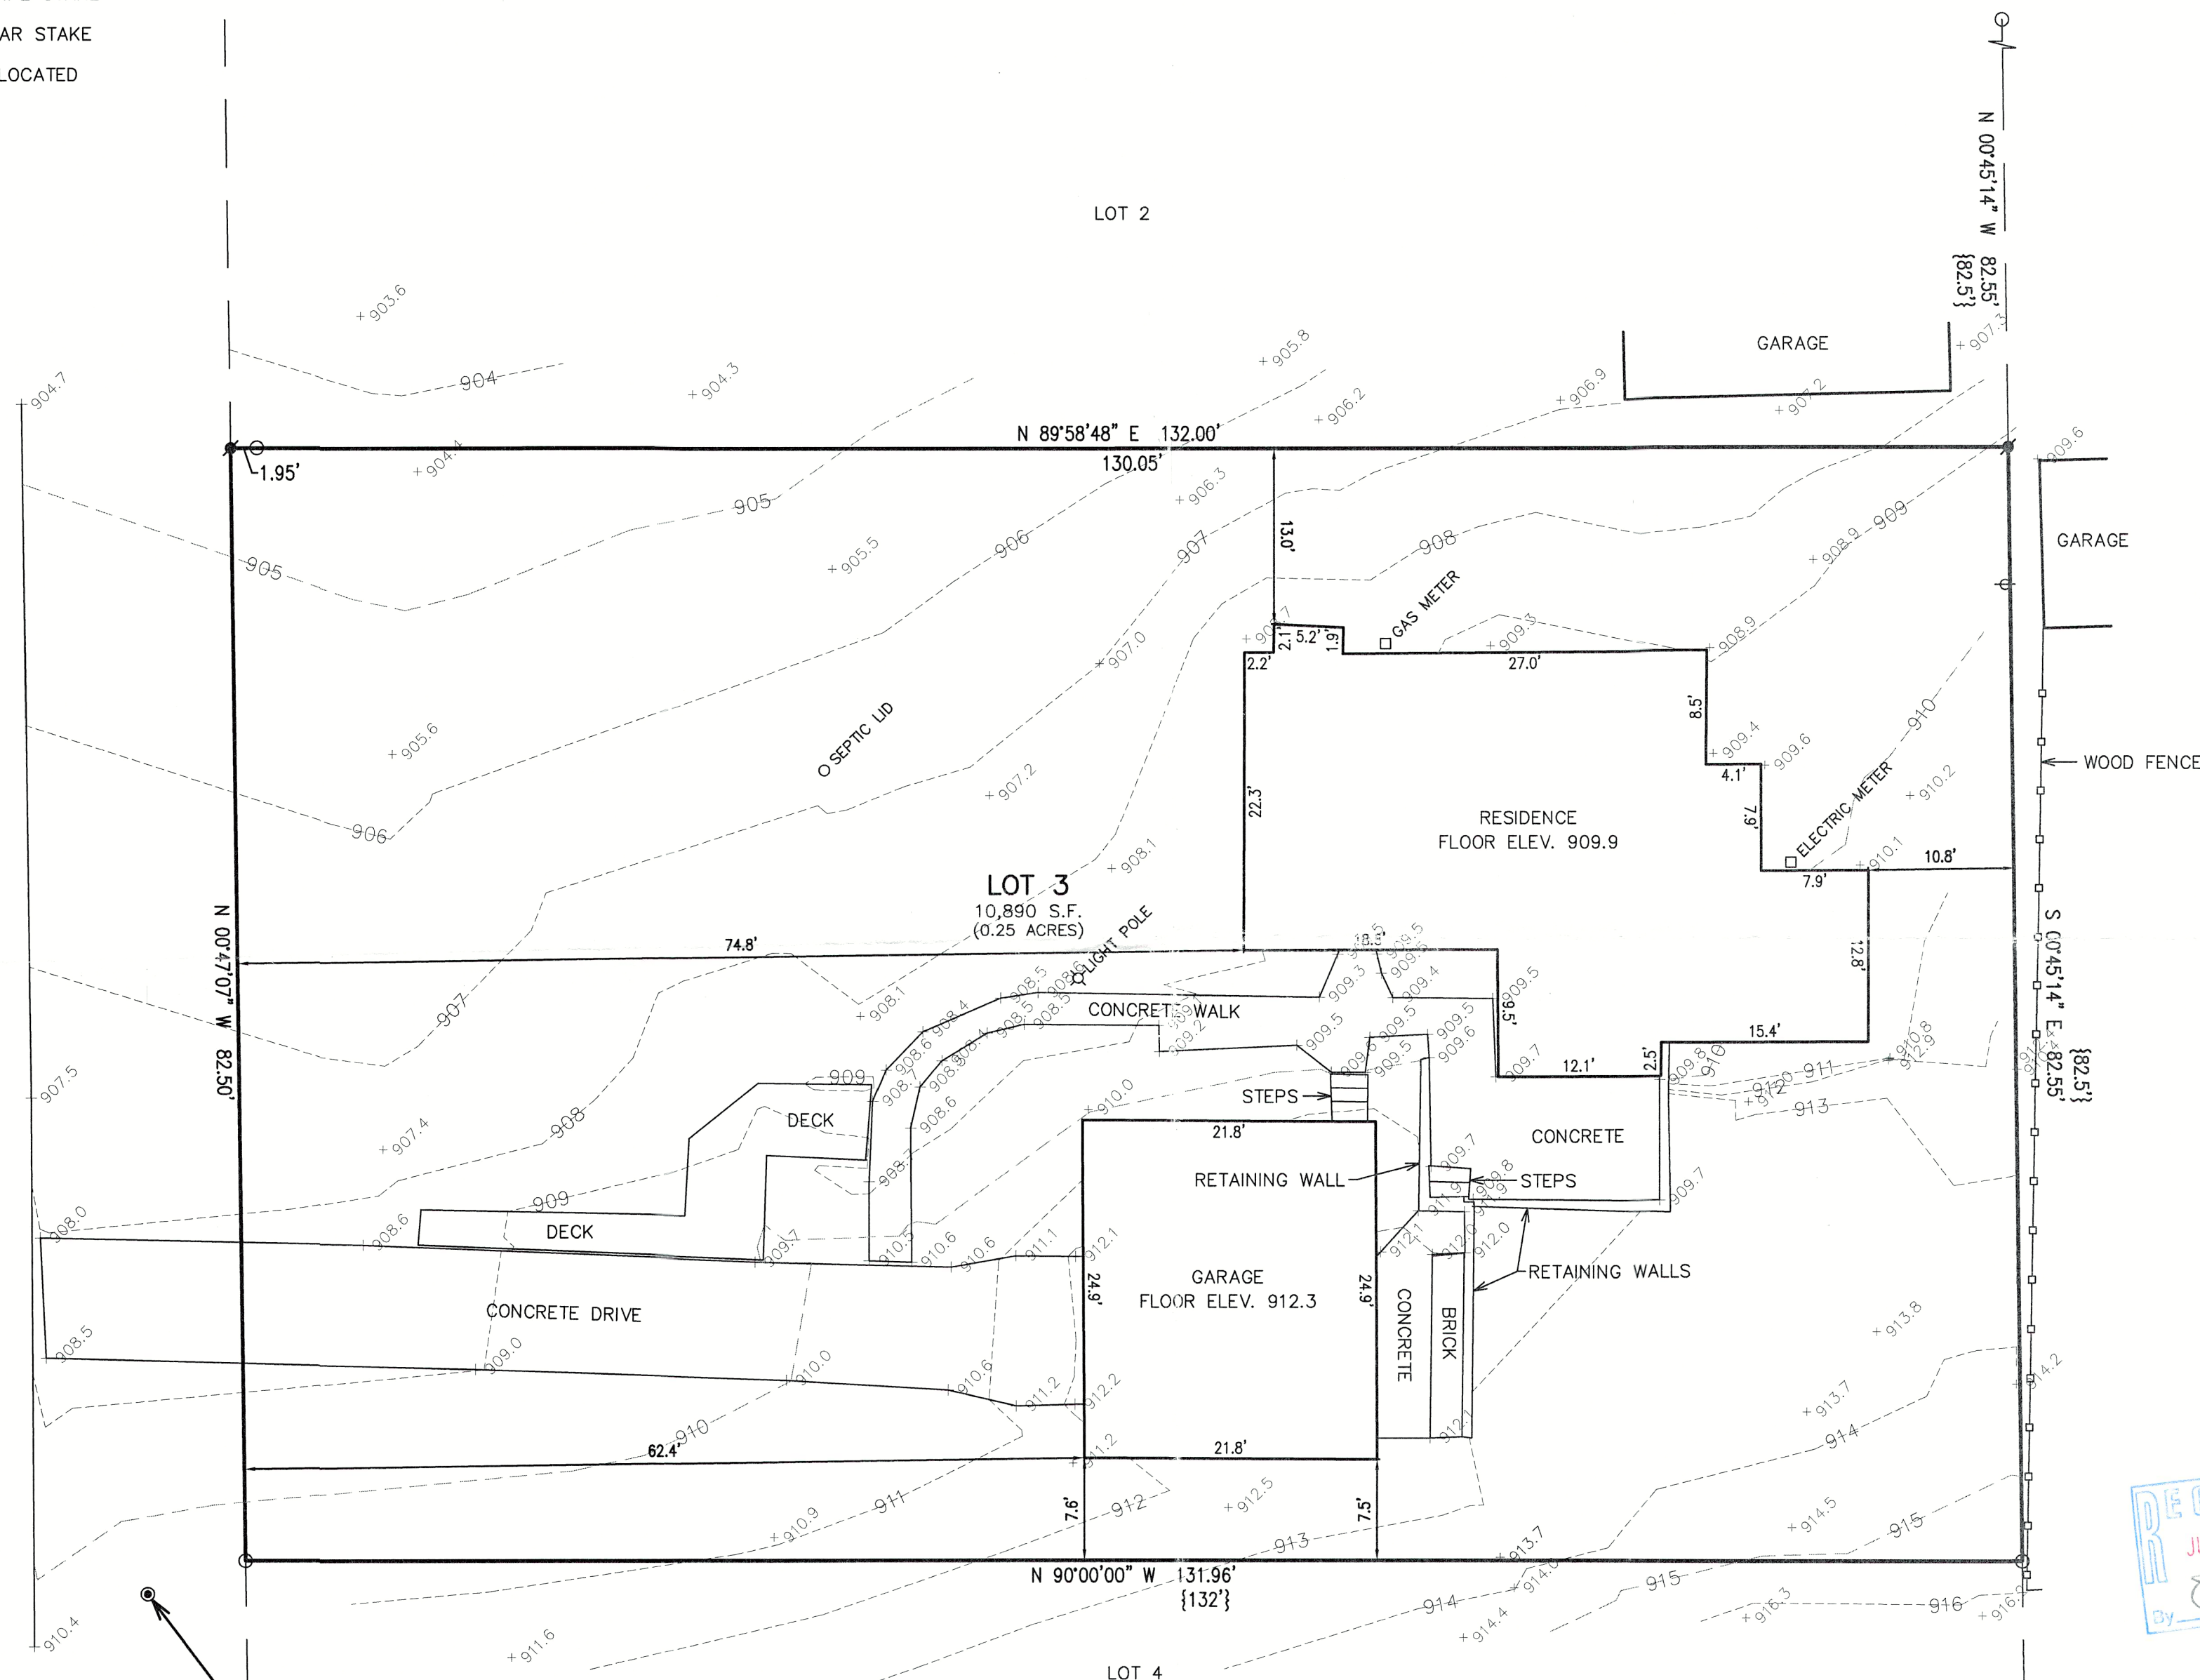

BENCH MARK -
TOP OF CONCRETE MONUMENT
FOUND S 71°09'20" W 7.71'
FROM RECORD CORNER
ELEVATION = 910.63'

NOTE: COPIES OF THIS MAP TO WHICH THE FOLLOWING CERTIFICATE WILL APPLY SHOW THE SURVEYOR'S ORIGINAL SEAL AND SIGNATURE IN RED INK. COPIES BY ANY OTHER MEANS MAY HAVE ALTERATIONS WHICH DO NOT REPRESENT THE SURVEYOR'S WORK PRODUCT.

I HEREBY CERTIFY THAT THE ABOVE DESCRIBED PROPERTY HAS BEEN SURVEYED UNDER MY DIRECTION AND THAT THE ABOVE MAP IS A TRUE REPRESENTATION THEREOF AND SHOWS THE SIZE AND LOCATION OF THE PROPERTY AND ITS EXTERIOR BOUNDARIES. THIS SURVEY IS MADE FOR THE USE OF THE PRESENT OWNERS OF THE PROPERTY, AND ALSO THOSE WHO PURCHASE, MORTGAGE, OR GUARANTEE THE TITLE THERETO WITHIN ONE YEAR FROM THE DATE HEREOF.

DATED: 10/11/2021

Christopher A. Hodges
CHRISTOPHER A. HODGES P.L.S. 2760



X:\PROJECTS\10547\ACAD\10547.dwg

IRB1-3

177-4777