


HAROLD H. KOLB

REGISTERED PROFESSIONAL LAND SURVEYOR
LAKE GENEVA, WISCONSIN

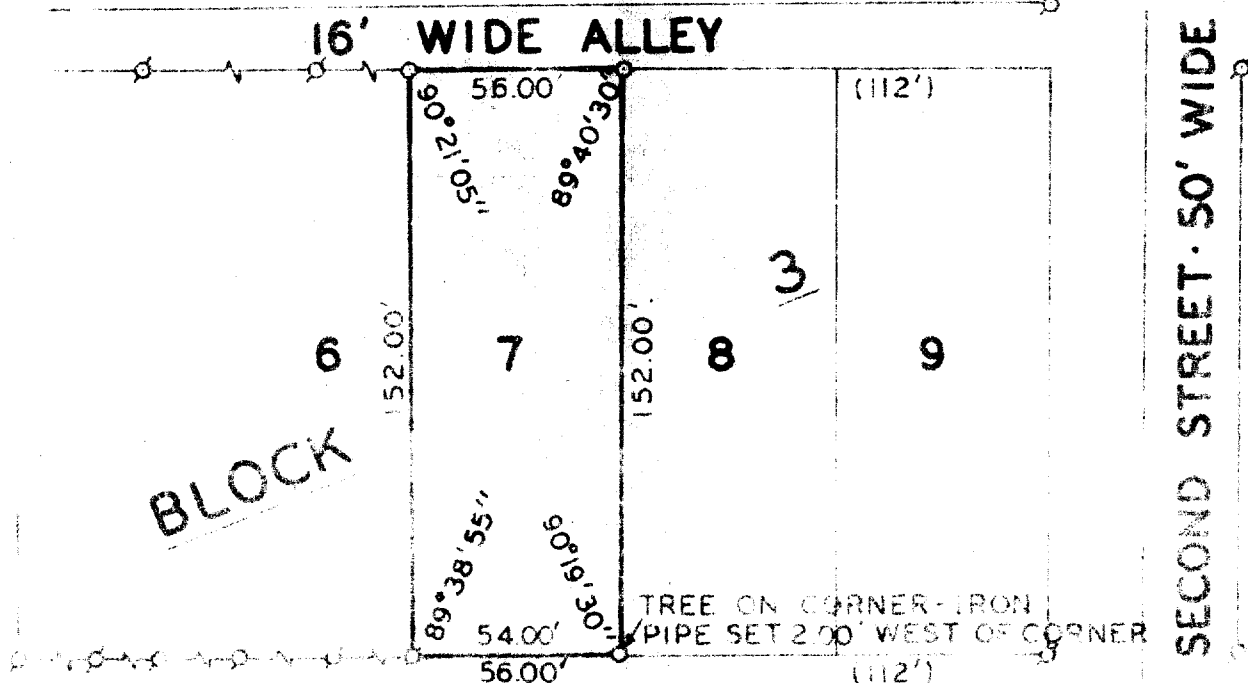

PLAT OF SURVEY OF

LOT 7, BLOCK 3, LAWRENCE'S ADDITION
TO GLENVIEW, SECTION 14, T4N, R17E,
WATKINS COUNTY, WISCONSIN.

OWNER: CARL E. LINDSTAD

ACCURACY: DISTANCE $\pm 0.01'$
ANGLES $\pm 05''$

PERCENT OF CLOSURE LESS THAN 1.00%

NOTE: AN IRON PIPE FOUND TO BE WITHIN 1.00' OF THE
FROM PLATTED DISTANCE.

SCALE 1"=50'

LEGEND

- IRON PIPE FOUND
- IRON PIPE PLACED
- CONCRETE MONUMENT
- PIPE PLACED

I, HAROLD H. KOLB, DO HEREBY CERTIFY THAT I HAVE
SURVEYED THE PROPERTY HEREIN DESCRIBED ACCORDING
TO THE OFFICIAL RECORDS, AND THAT THE PLAT HEREON
IS A CORRECT REPRESENTATION OF THE SAME.

HAROLD H. KOLB

WISCONSIN REGISTERED LAND SURVEYOR 6-107

DATE July 26, 1975