


PLAT OF SURVEY

Survey No. 23.5128

LOCATION: W3823 Parker Drive Lake Geneva, WI 53147
PREPARED FOR: Tim Tippit
PROPERTY DESCRIPTION: Surveyed As
The West half of Lot 57 and Lots 58, 59, and 60 all in Block Numbered Four (4)
of Lake View Park, Lake Geneva, Walworth County, Wisconsin
CURRENT OWNER: Braden A Nichols
TAX ID: ILVP 00026D

November 30, 2023

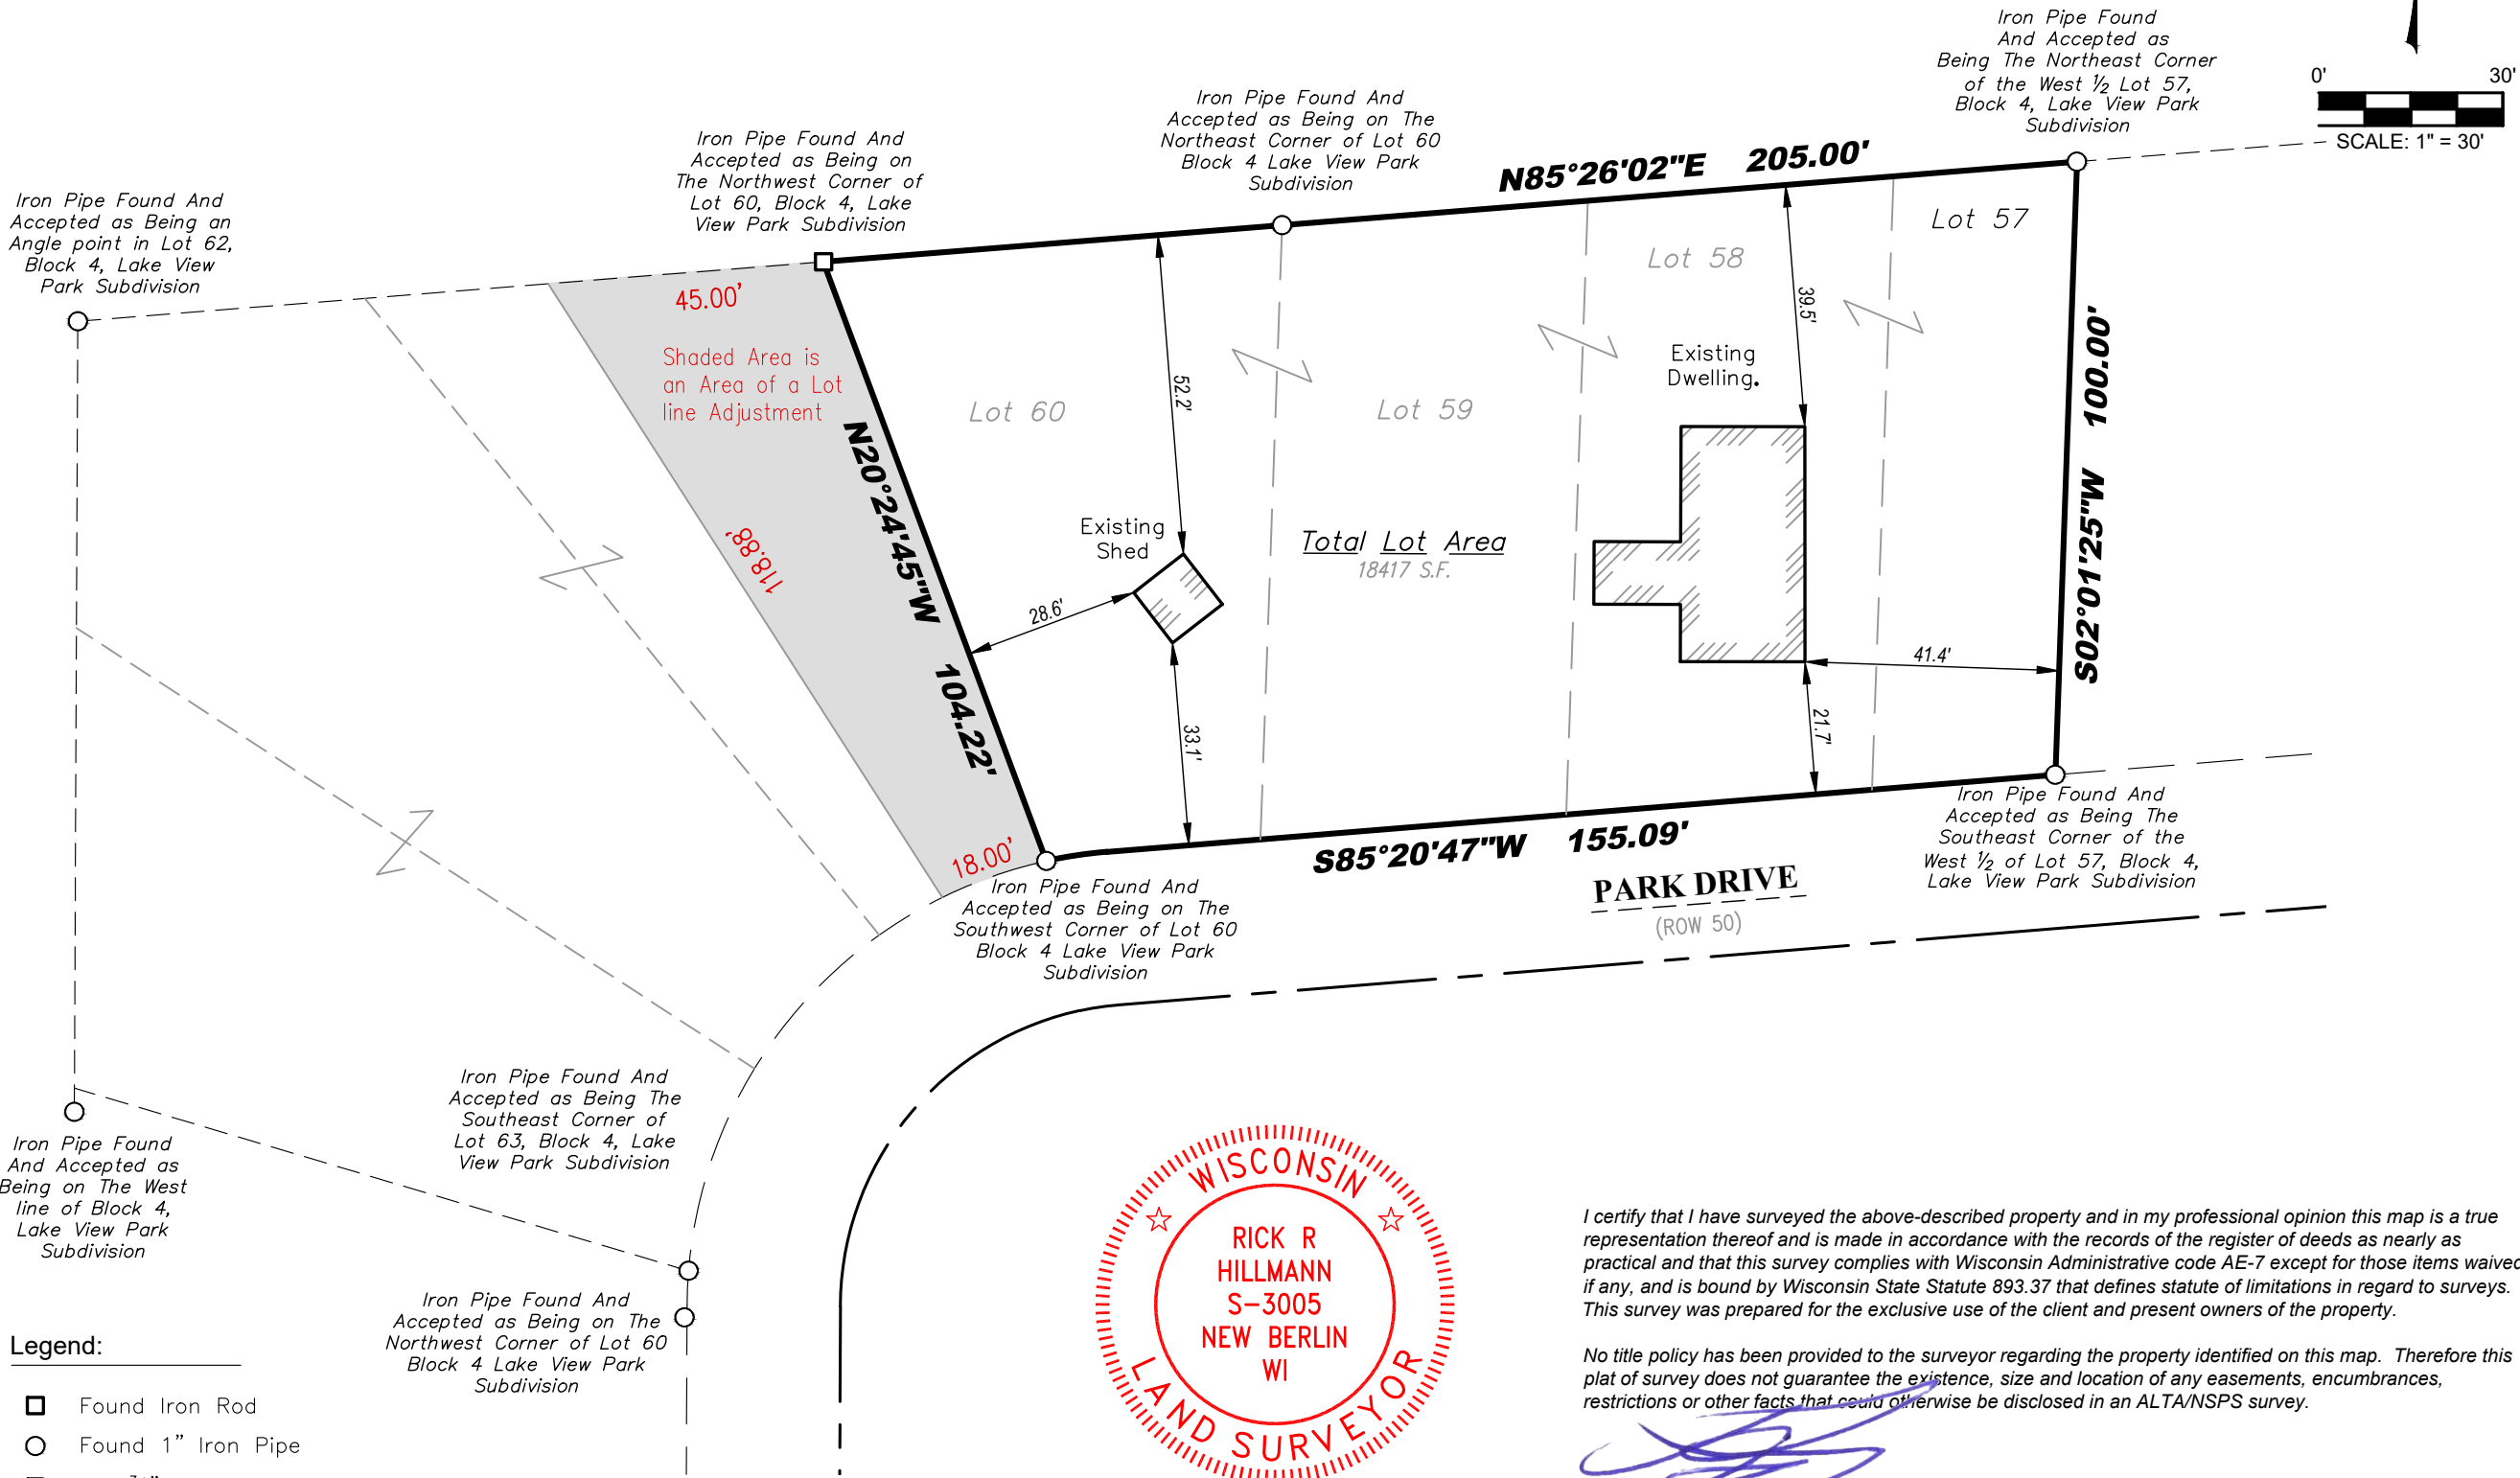

P:\Shared\1 - Projects\2023\23.5128 - Tim Tippit - W3823 Parker Drive - Lake Geneva CAD\Design\23.5128.S.dwg



LYNCH & ASSOCIATES
ENGINEERING CONSULTANTS, LLC

5482 S. WESTRIDGE DRIVE
NEW BERLIN, WI 53151

440 MILWAUKEE AVENUE
BURLINGTON, WI 53105

(262) 402-5040