


**REGISTERED PROFESSIONAL LAND SURVEYOR
LAKE GENEVA, WISCONSIN**

LOT 9, BLOCK 2, TRINKE
ESTATES, LOCATED IN THE
SOUTHEAST 1/4 OF SECTION
10, T 1 N, R 17 E,
WALWORTH COUNTY, WIS-
CONSIN.

ACCURACY: DISTANCE $\pm 0.01'$
 ANGLES $\pm 05''$
 ERROR OF CLOSURE
 LESS THAN $1/3000$



φ — IRON PIPE FOUND
 O — IRON PIPE PLACED
 ● — CONCRETE MONUMENT
 x — SPIKE
 () — PLATTED AS

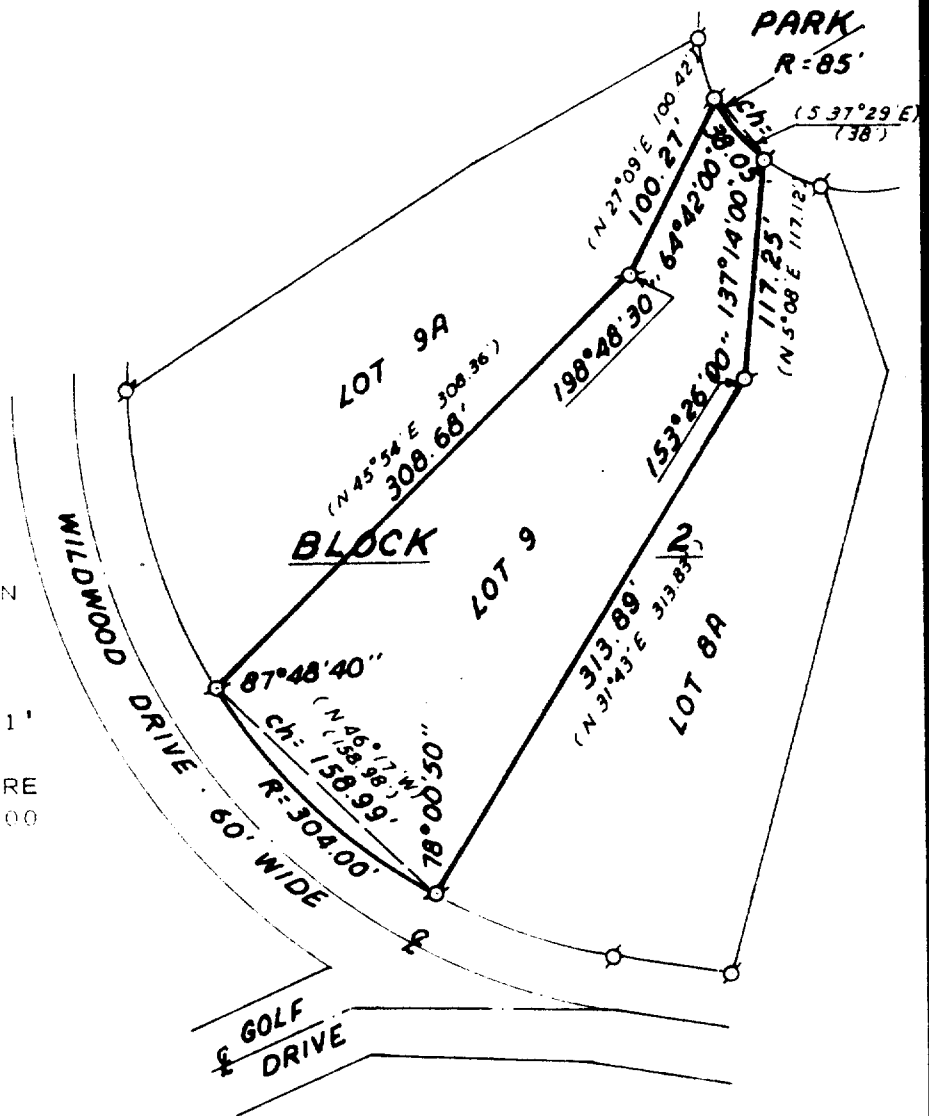

I, HAROLD H. KOLB, DO HEREBY CERTIFY THAT I HAVE SURVEYED THE PROPERTY HEREON DESCRIBED ACCORDING TO THE OFFICIAL RECORDS, AND THAT THE PLAT HEREON IS A CORRECT REPRESENTATION OF THE LOT LINES.

Harold H. Kolb
HAROLD H. KOLB
WISCONSIN REGISTERED LAND SURVEYOR, S-187
DATE OCT 22 1975

ITE-23

BRUNING 4Q-1Q5 1M.6-71

117-493