


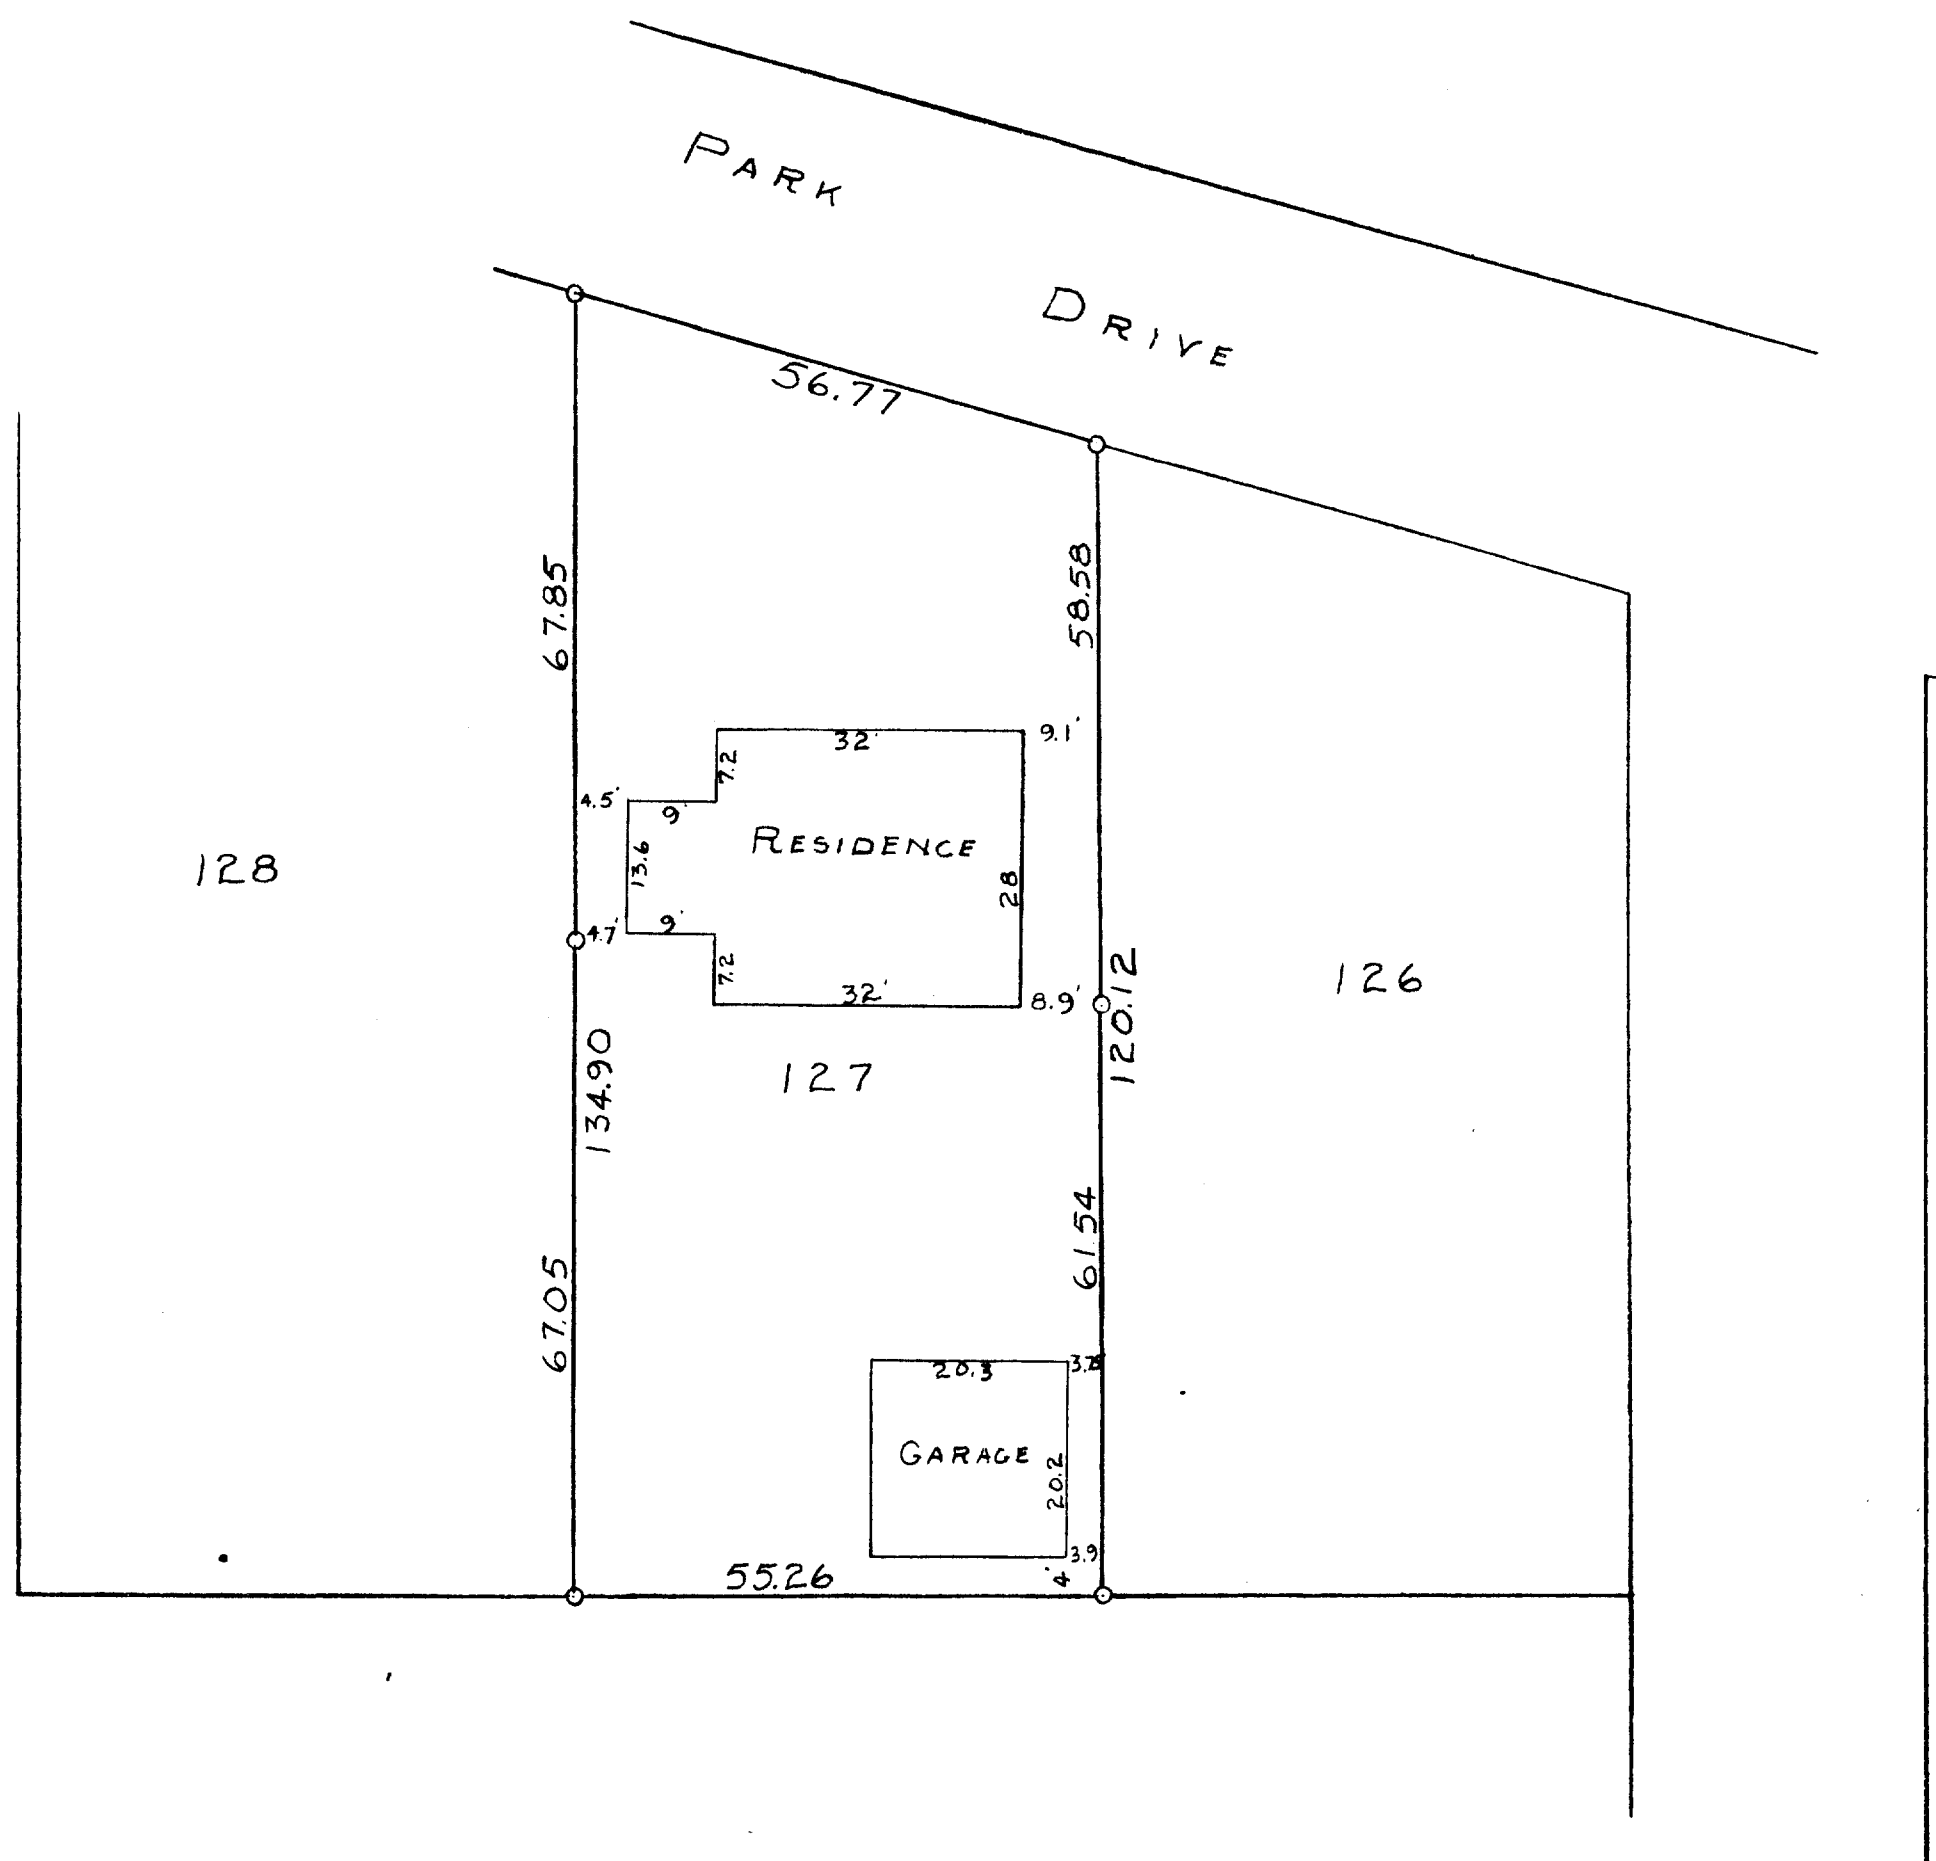

STATE OF WISCONSIN)
COUNTY OF WALWORTH)

I, GEORGE T. DUNHAM, DO HEREBY CERTIFY THAT I HAVE SURVEYED THE
PROPERTY DESCRIBED AS FOLLOWS:

LOT 127 OF LAKE GENEVA BEACH LOCATED IN, SECTION 11, T1N R17E
OF WALWORTH COUNTY, WISCONSIN
AND THAT THE PLAT SHOWN ABOVE IS A CORRECT REPRESENTATION OF THE
PROPERTY LINES.

SEPTEMBER 22, 1955

George T. Dunham
GEORGE T. DUNHAM, SURVEYOR
DELAVER, WISCONSIN