


PREPARED FOR:
 BEAA SHEEHAN
 KEEFE REAL ESTATE, INC.
 751 GENEVA PARKWAY
 LAKE GENEVA, WI. 53147

LYNCH & ASSOCIATES
 ENGINEERING CONSULTANTS, LLC.
 5482 S. WESTRIDGE DR.
 NEW BERLIN, WI 53151
 (262) 248-3697

PLAT OF SURVEY

- OF -

LOT 46, BLOCK 4 LAKE VIEW PARK A SUBDIVISION LOCATED IN SECTION 16,
 T.1.N., R.17.E., TOWN OF LINN, WALWORTH COUNTY, WISCONSIN.

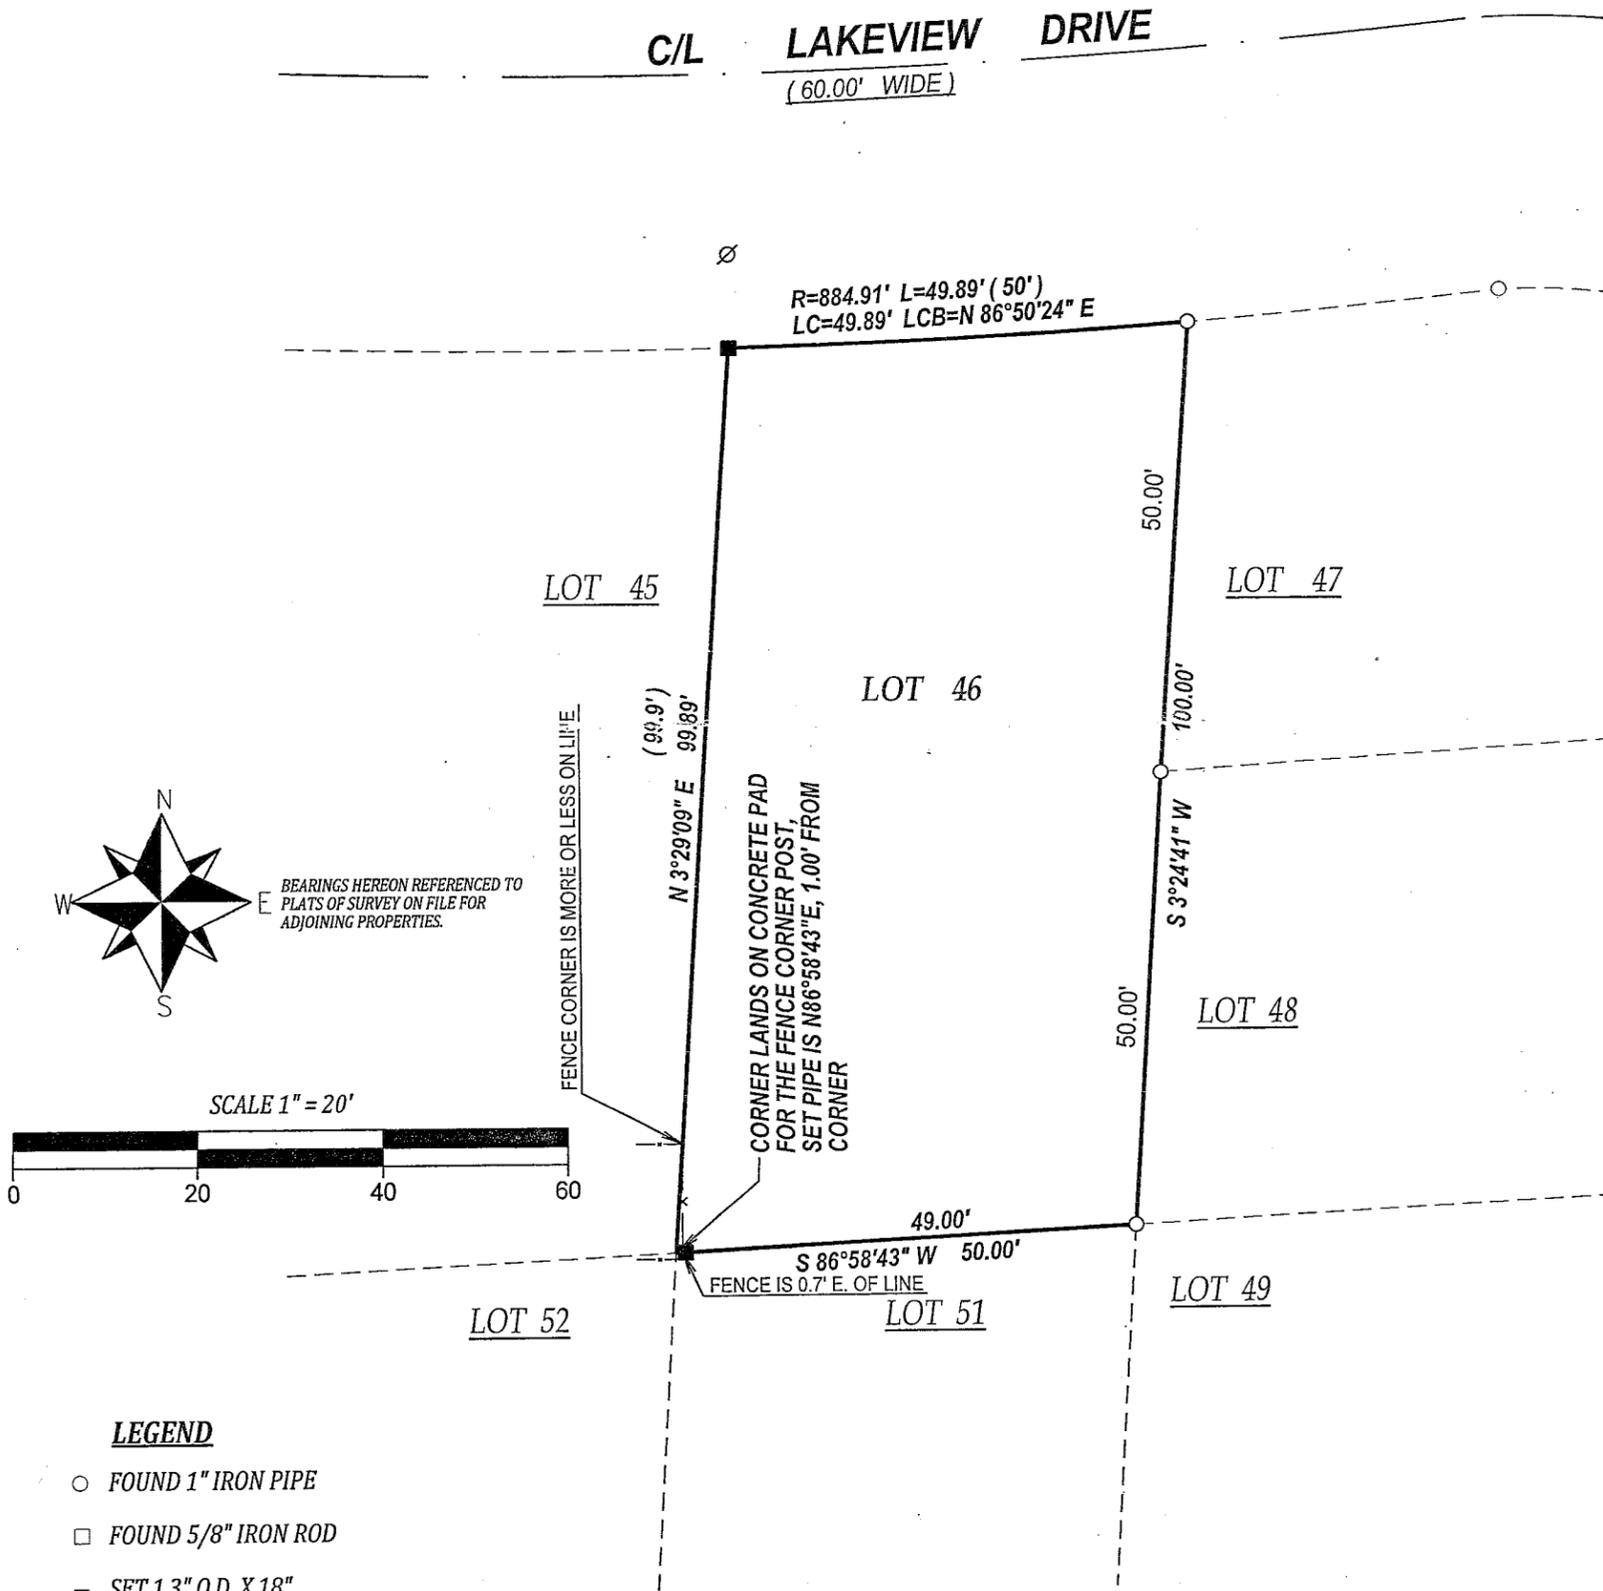

- LEGEND**
- FOUND 1" IRON PIPE
 - FOUND 5/8" IRON ROD
 - SET 1.3" O.D. X 18" IRON PIPE 1.13#/L.F.
 - (XX) RECORDED AS
 - ⊙ TELEPHONE PEDISTAL
 - ⊘ POWER POLE
 - ▲ TRANSFORMER
 - WELL
 - ⊙ SEPTIC VENT
 - ⊕ SEPTIC TANK COVER

NOTE:
 No title commitment or results of a title search were provided to this office pertaining to this survey. This Plat Of Survey may not reflect easements of record, encumbrances, restrictions, ownership, title evidence, or other facts that a current and accurate title search may disclose.

I have surveyed the above-described property and the above map is a true representation thereof and shows the size and location of the property, its exterior boundaries, the location and dimensions of all structures thereon, fences apparent easements and roadways and visible encroachments, if any.

This survey is made for the exclusive use of the present owners of the property, and also those who purchase, mortgage, or insure the title thereto within one (1) year from date hereof; and as to them I warrant the accuracy of said survey map.

WISCONSIN
 KENNETH B. MEHRING
 S-2838
 WATERFORD
 WIS.
 LAND SURVEYOR

DATED THIS 9th DAY OF SEPTEMBER, 2014

[Signature]
 KENNETH B. MEHRING S-2838
 Wisconsin Registered Land Surveyor
 (original if signed in red)

JOB # 14-619
 TAX ID # ILVP-00021C

117-5032