




Vanderstappen
Land Surveying, Inc.
www.vandersinc.com
1316 N. Madison St.
Woodstock, Illinois 60098
ph. 815-337-8310 fax 815-337-8314
"Always faithful to the property line"

PLAT OF SURVEY

Lot 6 in Camp Sybil in Ross D. Sill's Subdivision in Section 18,
Township 1 North, Range 17 East of the Fourth Principal
Meridian, in the Town of Linn, Walworth County, Wisconsin.

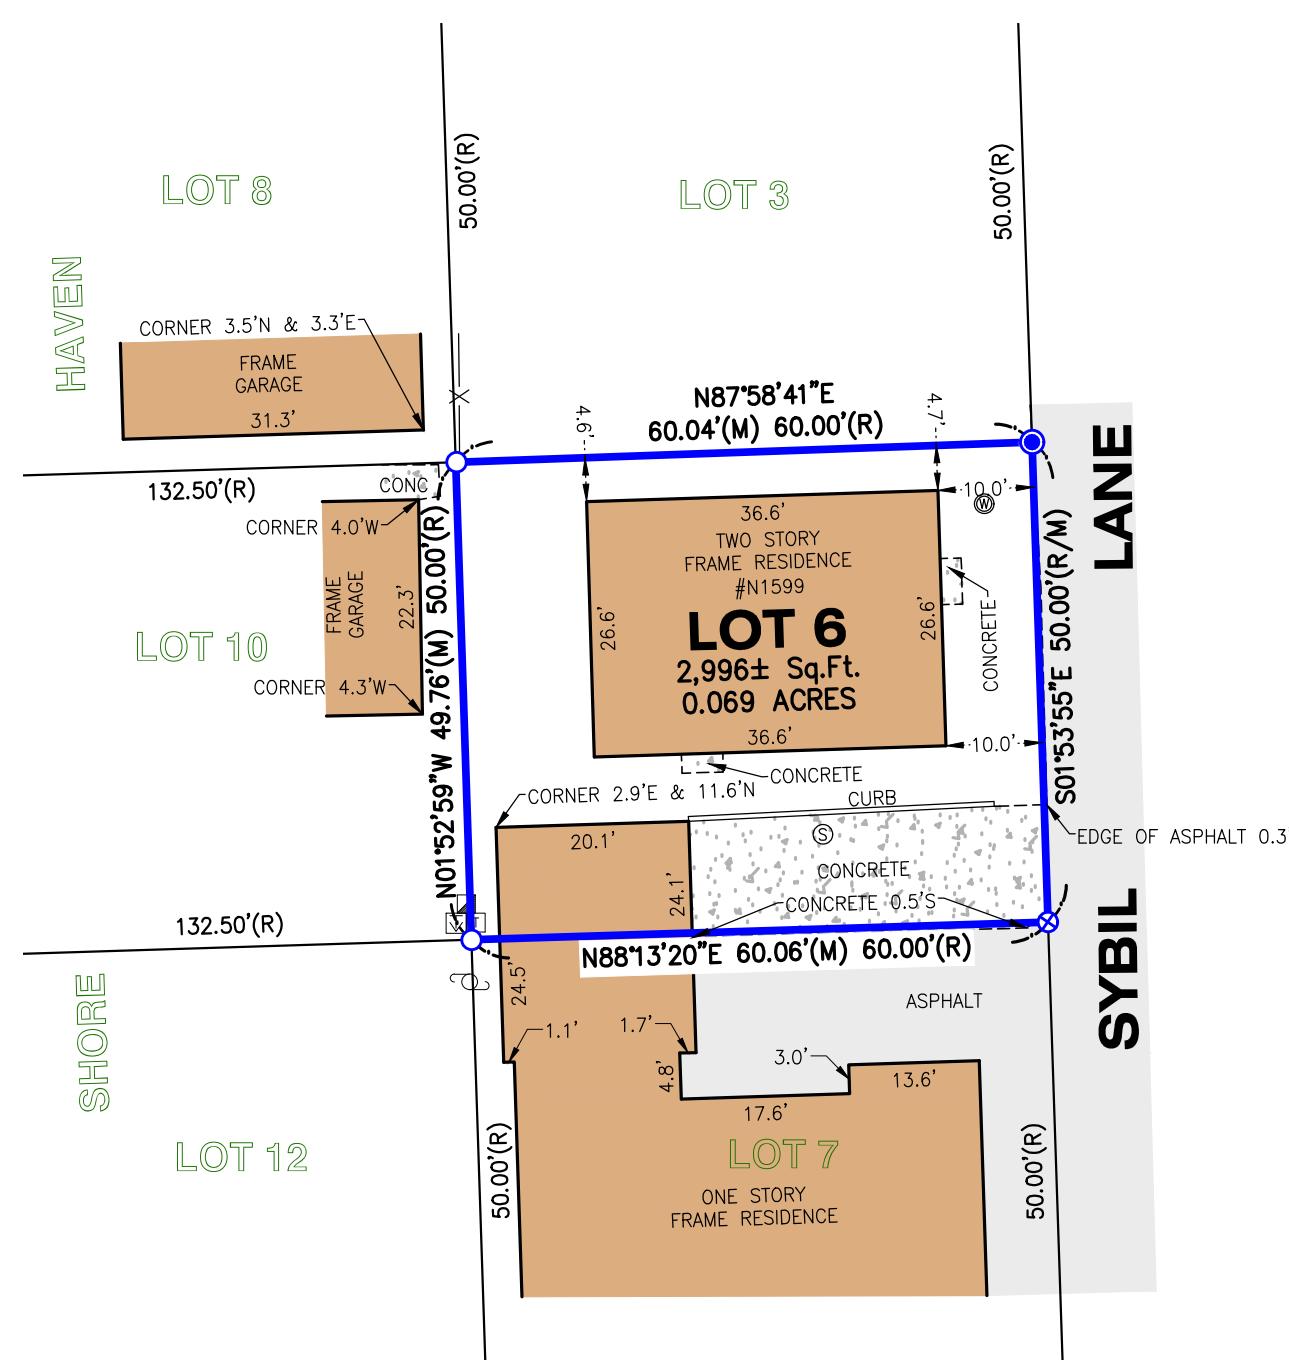

LEGEND

<input checked="" type="checkbox"/>	ELECTRIC TELEPHONE & TV RISERS
●	FOUND IRON BAR
○	FOUND IRON PIPE
⊗	FOUND MAG NAIL
◎	SEPTIC LID
●	SET IRON BAR
□	UTILITY POLE
◎	WELL
(M)	MEASURED
(R)	RECORD

20' 0' 20' 40'
SCALE: 1" = 20'




CLIENT: CARROLL & CARROLL
DRAWN BY: JGK CHECKED BY: TVA
SCALE: 1"=20' SEC. 18 T. 01 R. 17 E.
BASIS OF BEARING: WI S. ZONE NAD83/2011
P.I.N.: ICA 00005
JOB NO.: 250184 I.D. LSS
FIELDWORK COMP.: 3/20/25 BK. PG.
ALL DISTANCES SHOWN IN FEET AND DECIMAL REF:
PARTS THEREOF CORRECTED TO 68° F.

NOTE: Only those Building Line Restrictions or
Easements shown on a Recorded Subdivision Plat are
shown hereon unless the description ordered to be
surveyed contains a proper description of the required
building lines or easements.

- * No distance should be assumed by scaling.
- * No underground improvements have been located unless shown and noted.
- * No representation as to ownership, use, or possession should be hereon implied.
- * This Survey and Plat of Survey are void without original embossed or colored seal and signature affixed.

Compare your description and site markings with this
plat and AT ONCE report any discrepancies which you
may find.

STATE OF ILLINOIS)) S.S.
COUNTY OF McHENRY)

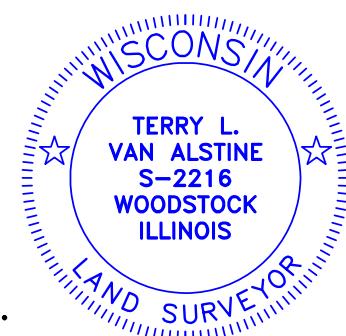

In my professional opinion, and based on my observations, I hereby certify
that the above described property has been surveyed under my direction
and that the above map is a true representation thereof and shows the
size and location of all visible structures, and dimensions of all principle
buildings thereon, boundary fences, apparent easements, roadways, and
visible encroachments, if any. This survey is made for the use of the
present owners of the property, and also those who purchase, mortgage, or
guarantee the title thereto within one year from the date hereof.

Dated at Woodstock, McHenry County, Illinois 4/1 A.D., 2025.

Vanderstappen Land Surveying, Inc.
Design Firm No. 184-002792

By: 
Wisconsin Registered Land Surveyor No. S2216