

# PLAT OF SURVEY

**LOCATION:** Lakeview Park Drive, Linn, Wisconsin


**LEGAL DESCRIPTION:** Lots 4 and 5 in **LAKEVIEW PARK**, located in the Northeast 1/4 of Section 16, Township 1 North, Range 17 East of the Fourth Principal Meridian, in the Town of Linn, Walworth County, Wisconsin

August 22, 2025



Survey No. 115702-B

NOTE:  
*Boundary and Legal  
Description Based upon  
Plat of Survey by Satter  
Surveying, LLC., Dated  
November 2, 2021.*

## GRAPHIC SCALE

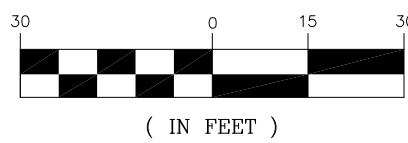

( IN FEET )

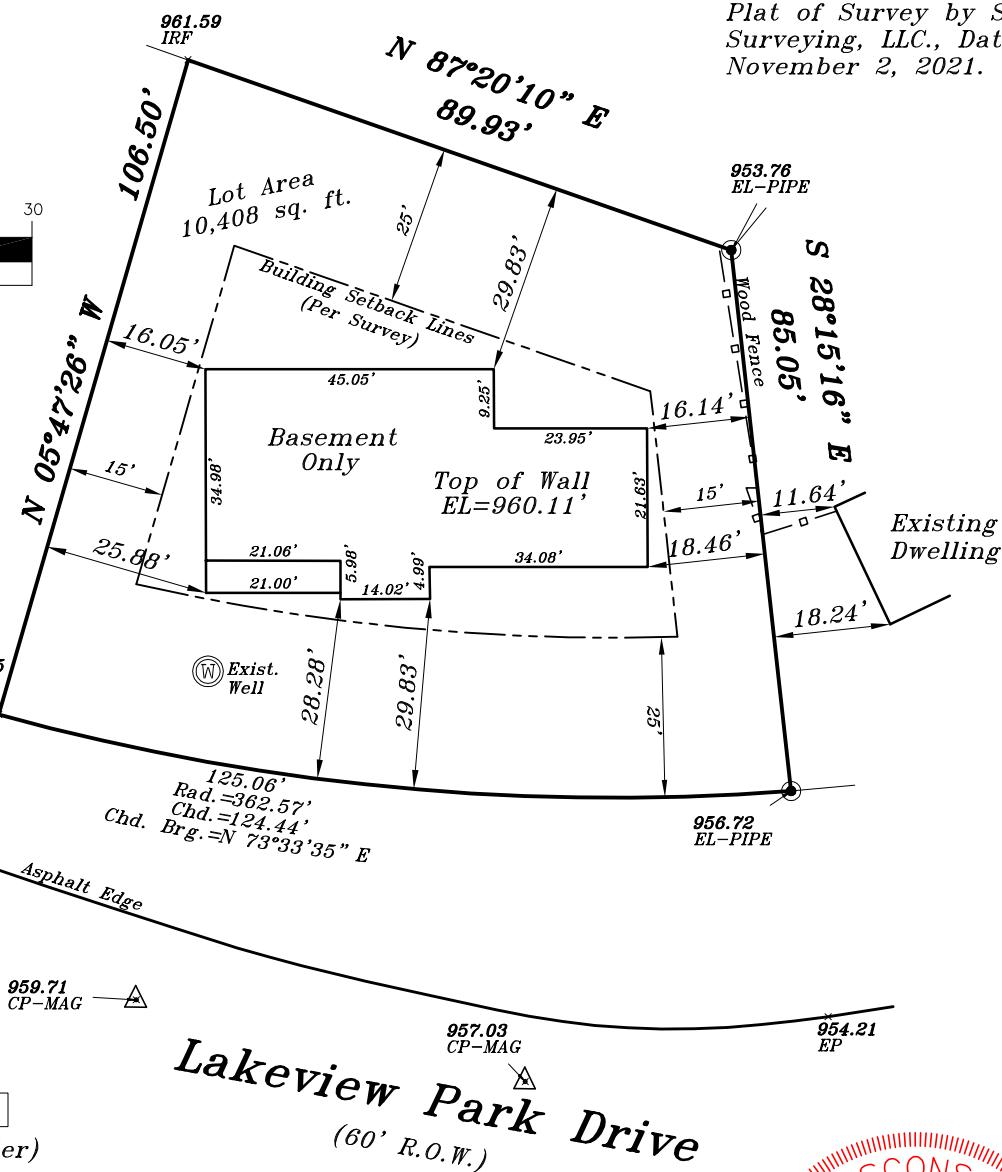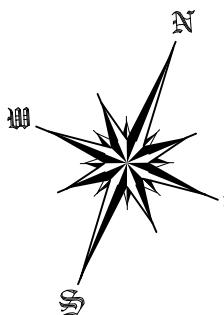

*Proposed finished yard, 1st floor or top of foundation grade shown on this drawing is a suggested grade and should be verified by the owner, builder or municipality.*

METROPOLITAN SURVEY  
SERVICE, INC.

**I HEREBY CERTIFY THAT I HAVE SURVEYED THE ABOVE DESCRIBED PROPERTY AND THAT THE ABOVE MAP IS A TRUE REPRESENTATION THEREOF AND SHOWS THE SIZE AND LOCATION OF THE PROPERTY, ITS EXTERIOR BOUNDARIES, THE LOCATION OF ALL VISIBLE STRUCTURES AND DIMENSIONS OF ALL PRINCIPAL BUILDINGS THEREON, BOUNDARY FENCES, APPARENT EASEMENTS AND ROADWAYS AND VISIBLE ENCROACHMENT, IF ANY.**

**THIS SURVEY IS MADE FOR THE EXCLUSIVE USE OF THE PRESENT OWNERS OF THE PROPERTY,  
AND ALSO THOSE WHO PURCHASE, MORTGAGE, OR GUARANTEE THE TITLE THERETO WITHIN  
ONE (1) YEAR FROM THE DATE HEREOF.**

**SIGNER**

~~Dennis C. Sauer~~