
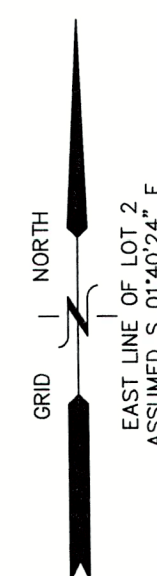


PLAT OF SURVEY LOT 2 OF SUNSET HILLS SHORES

LOCATED IN PART OF THE SE 1/4 OF THE NW 1/4 OF SECTION 4, TOWN 1 NORTH, RANGE 17 EAST,
TOWN OF LINN, WALWORTH COUNTY, WISCONSIN

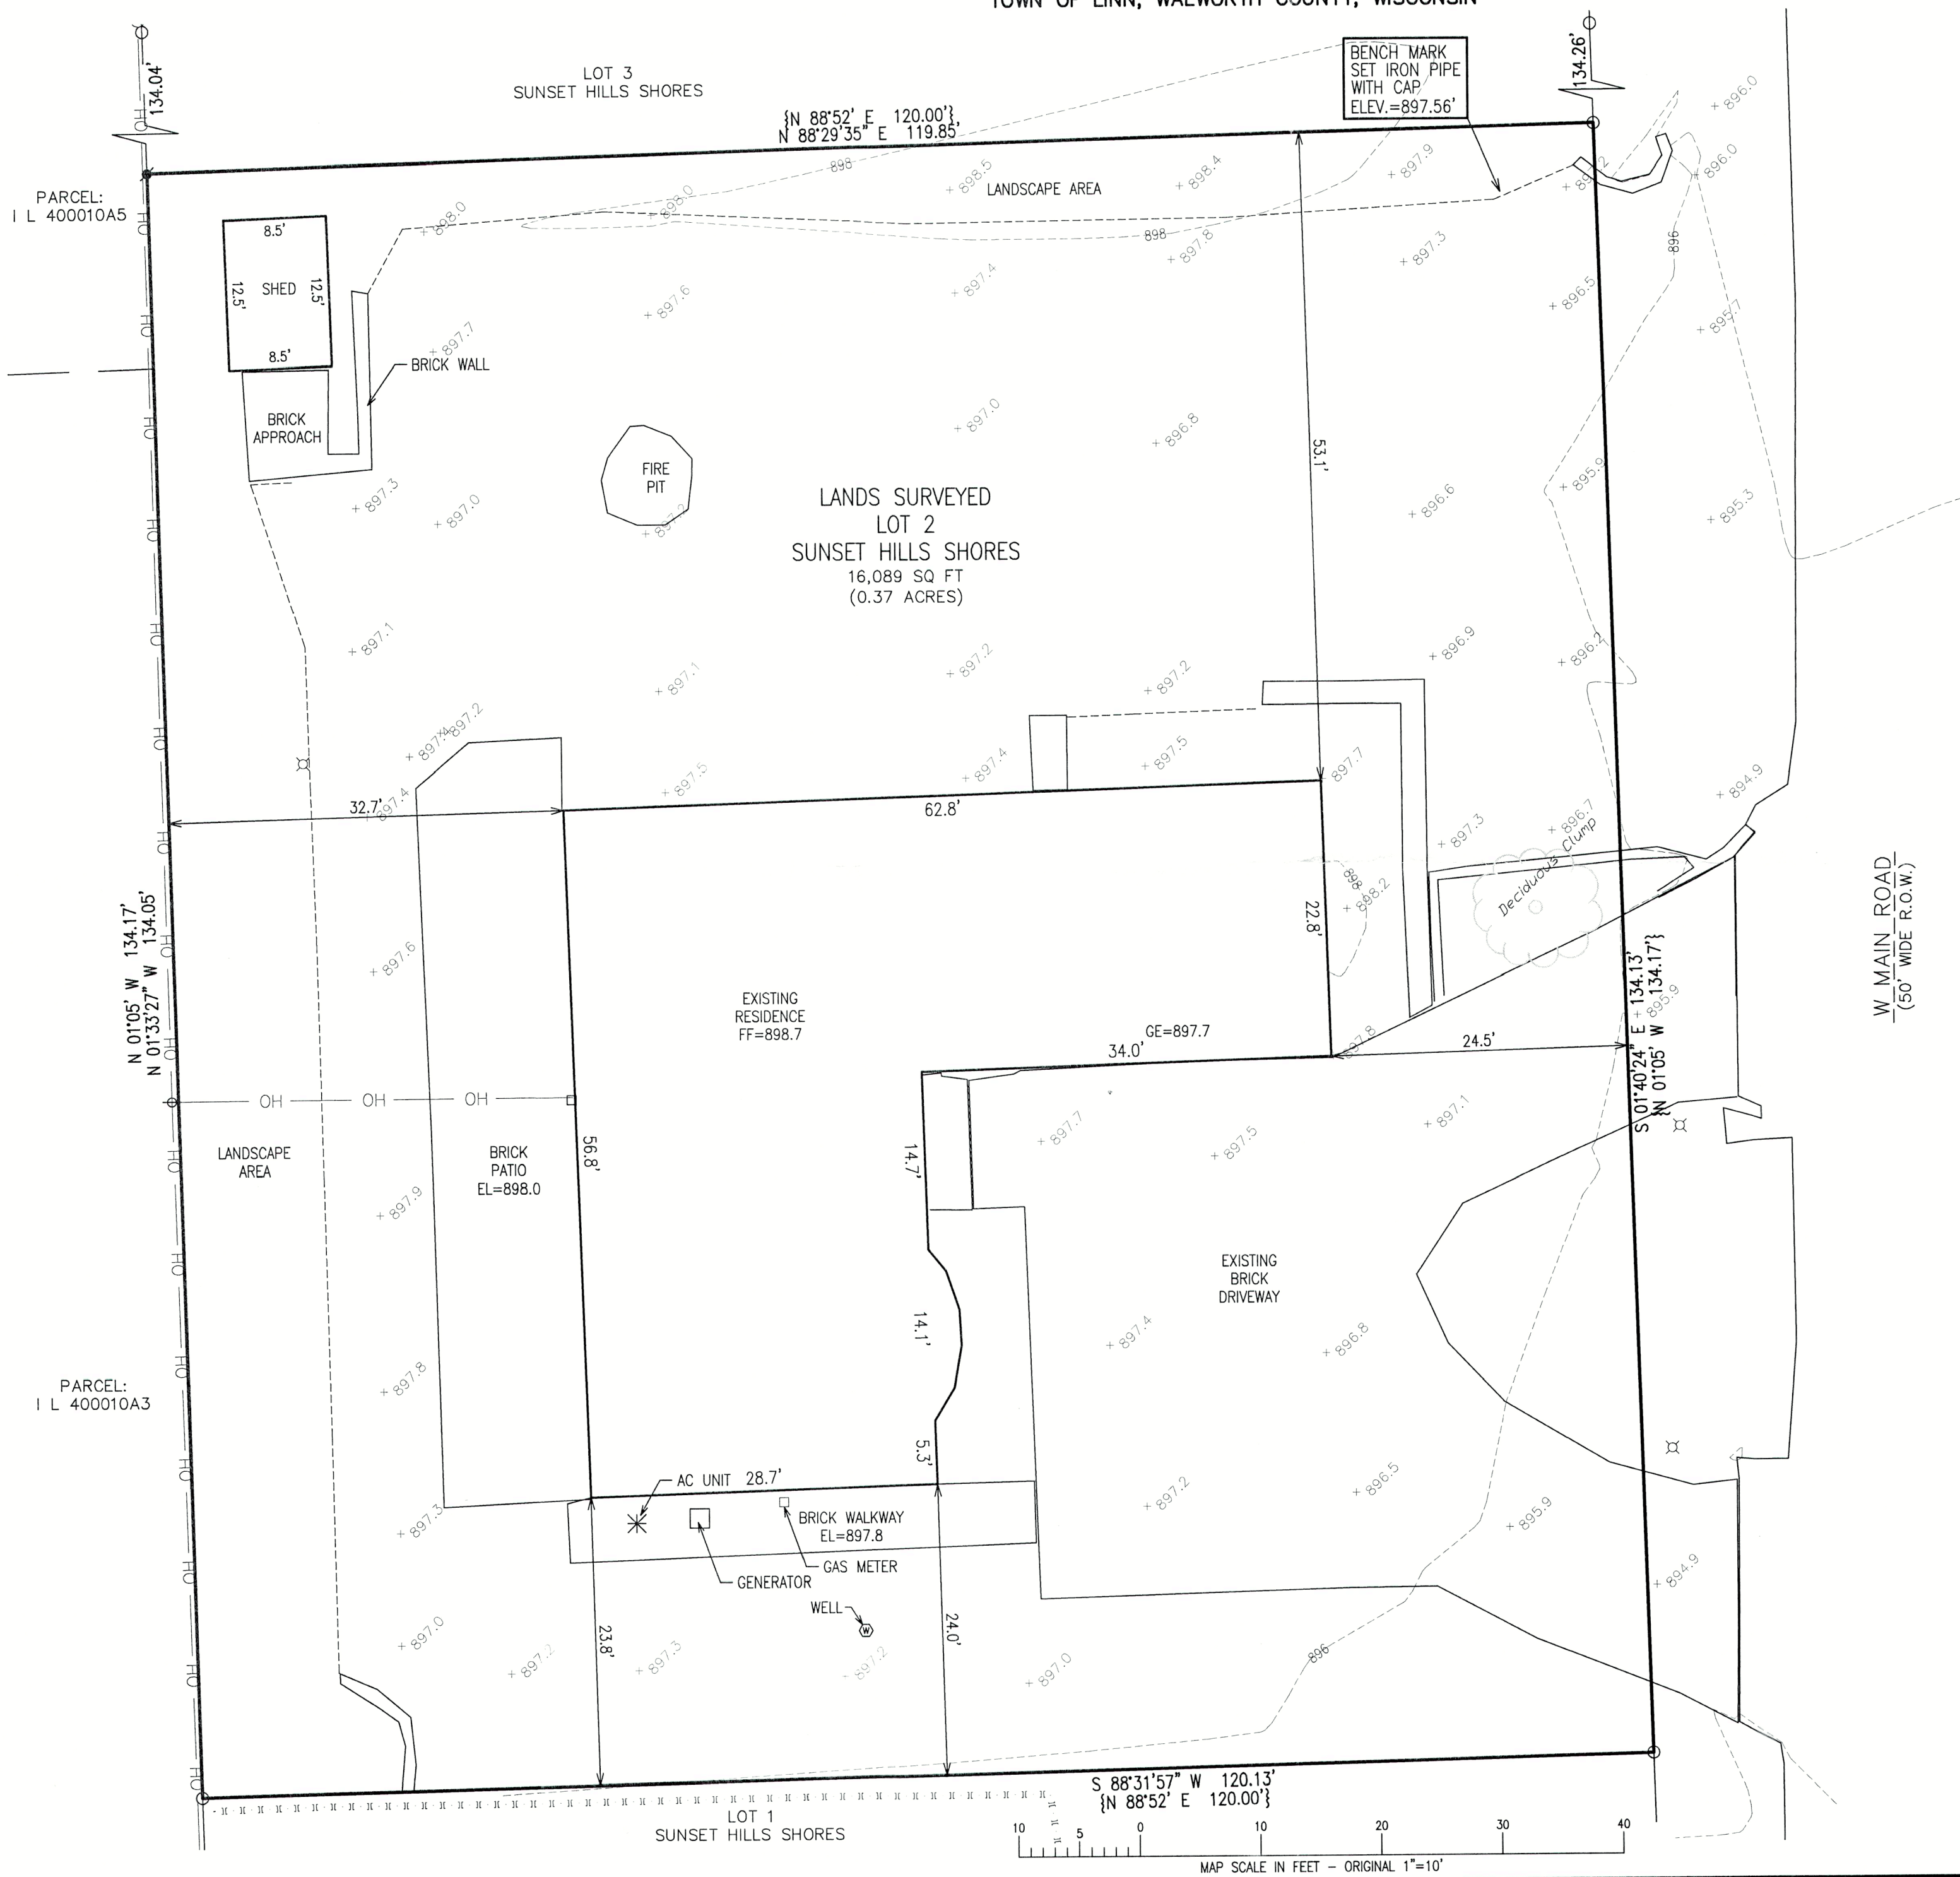

LEGEND

- = IRON PIPE FOUND 1 3/8" O.D.
- = IRON REBAR SET 3/4" x 18" x 1.13 lbs/ft
- ⊕ = BENCHMARK
- ⊥ ⊕ = GUY WIRE & UTILITY POLE
- {xxx} = RECORDED AS
- OH — = OVERHEAD UTILITY WIRES
- +xxxx = EXISTING GROUND ELEVATION
- - - - - = EXISTING LAND CONTOURS


NOTE: COPIES OF THIS MAP TO WHICH THE FOLLOWING CERTIFICATE WILL APPLY SHOW THE SURVEYOR'S ORIGINAL SEAL AND SIGNATURE IN RED INK. COPIES BY ANY OTHER MEANS MAY HAVE ALTERATIONS WHICH DO NOT REPRESENT THE SURVEYOR'S WORK PRODUCT.

I HEREBY CERTIFY THAT THE ABOVE DESCRIBED PROPERTY HAS BEEN SURVEYED UNDER MY DIRECTION AND THAT THE ABOVE MAP IS A TRUE REPRESENTATION THEREOF AND SHOWS THE SIZE AND LOCATION OF THE PROPERTY AND ITS EXTERIOR BOUNDARIES. THIS SURVEY IS MADE FOR THE USE OF THE PRESENT OWNERS OF THE PROPERTY, AND ALSO THOSE WHO PURCHASE, MORTGAGE, OR GUARANTEE THE TITLE THERETO WITHIN ONE YEAR FROM THE DATE HEREOF. FIELDWORK COMPLETED 6/02/2025.

DATED: 6/20/2025

CHRISTOPHER A. HODGES

P.L.S. 2760

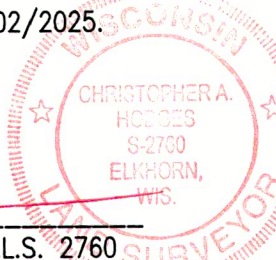

PLAT OF SURVEY

N2301 W MAIN ROAD
LAKE GENEVA, WI 53147

WORK ORDERED BY -
GENEVA LAKES DREAM HOMES, LLC
900 SOUTH WELLS STREET
LAKE GENEVA, WI 53147

FARRIS, HANSEN & ASSOCIATES, INC.

ENGINEERING - ARCHITECTURE - SURVEYING
7 RIDGWAY COURT P.O. BOX 437
ELKHORN, WISCONSIN 53121

PHONE: (262) 723-2098 e-mail: office@farris-hansen.com

REVISIONS

PROJECT NO.
11230
DATE:
5/30/2025
SHEET NO.
1 OF 1