


December 19, 2025

Proj No. 25.6006.03

LOCATION: W3806 Lackey Ln  
Lake Geneva, Wisconsin  
PREPARED FOR: Elite Piers LLC  
PROPERTY DESCRIPTION:  
Lot 1 Certified Survey No 4632 as recorded in  
Vol 30 CS on page 243 WCR. Located in the  
Southeast 1/4 and Northeast 1/4 of Section 9,  
Town 1 North, Range 17 East.  
TAX ID: IA 463200001

# PIER PLAT

## GENEVA LAKE

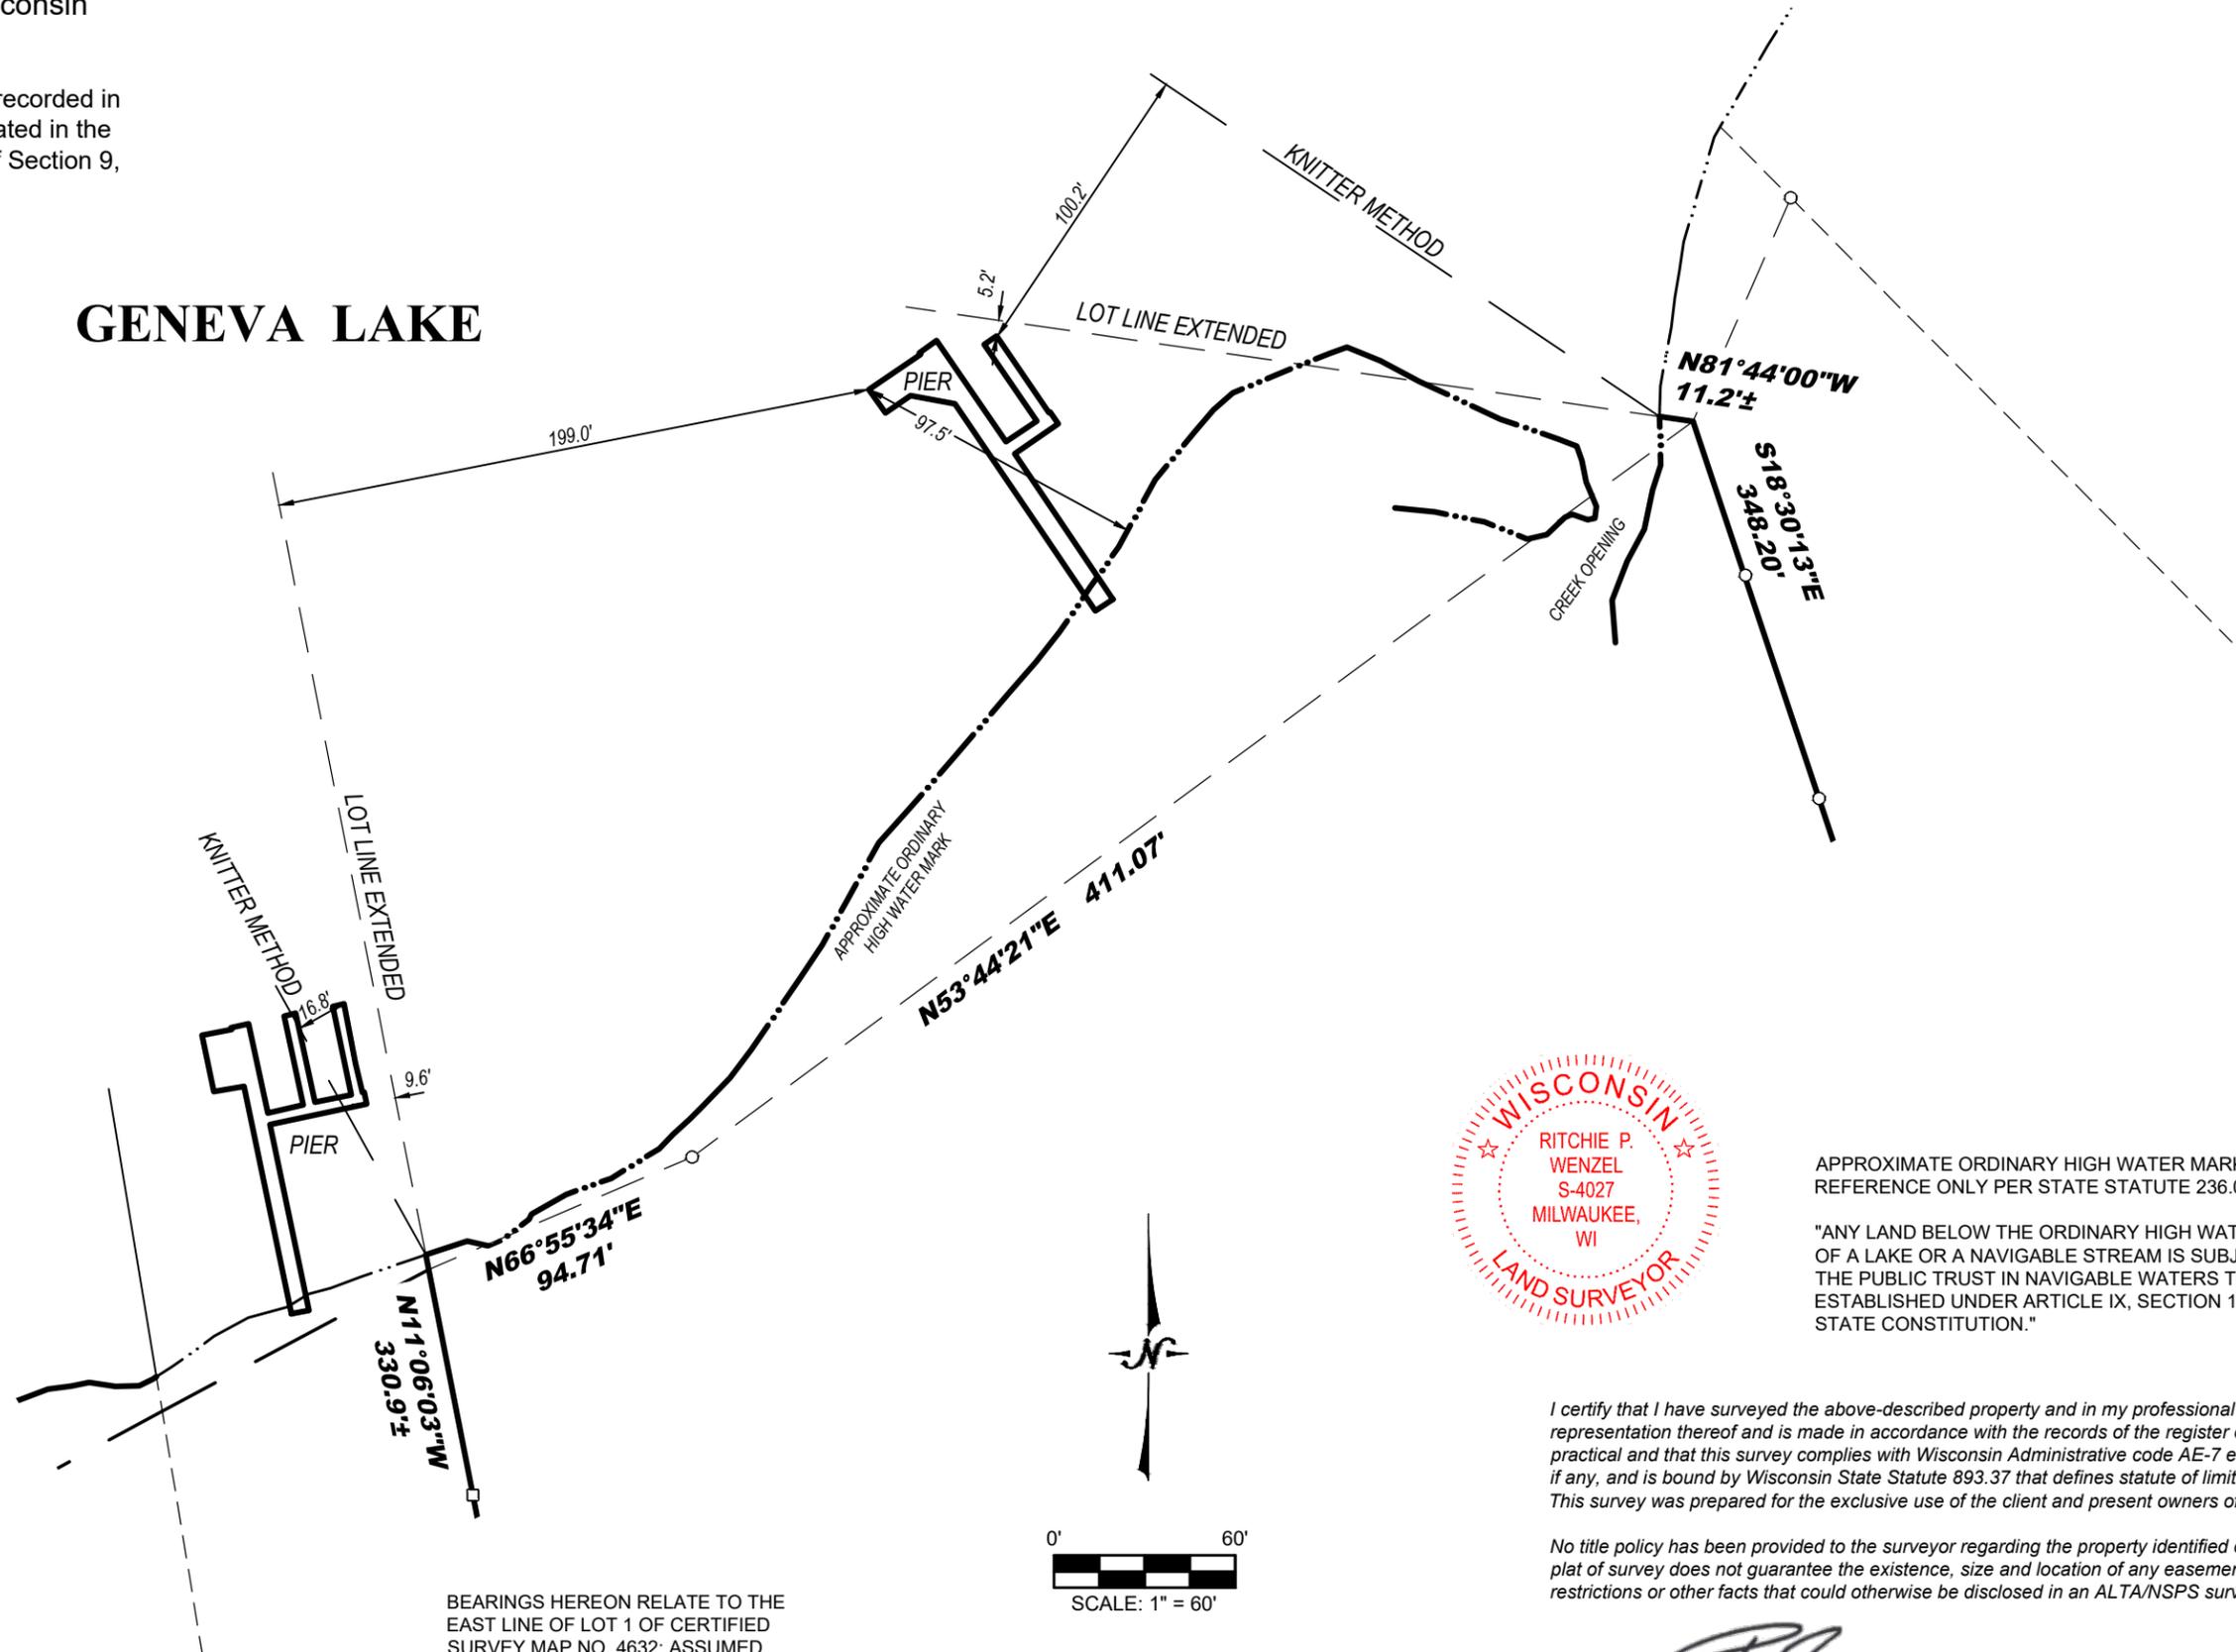

- Legend:**
- Found Iron Rod
  - Found 1" Iron Pipe



APPROXIMATE ORDINARY HIGH WATER MARK - FOR REFERENCE ONLY PER STATE STATUTE 236.025

"ANY LAND BELOW THE ORDINARY HIGH WATER MARK OF A LAKE OR A NAVIGABLE STREAM IS SUBJECT TO THE PUBLIC TRUST IN NAVIGABLE WATERS THAT IS ESTABLISHED UNDER ARTICLE IX, SECTION 1, OF THE STATE CONSTITUTION."

*I certify that I have surveyed the above-described property and in my professional opinion this map is a correct representation thereof and is made in accordance with the records of the register of deeds as nearly as practical and that this survey complies with Wisconsin Administrative code AE-7 except for those items waived, if any, and is bound by Wisconsin State Statute 893.37 that defines statute of limitations in regard to surveys. This survey was prepared for the exclusive use of the client and present owners of the property.*

*No title policy has been provided to the surveyor regarding the property identified on this map. Therefore this plat of survey does not guarantee the existence, size and location of any easements, encumbrances, restrictions or other facts that could otherwise be disclosed in an ALTA/NSPS survey.*



BEARINGS HEREON RELATE TO THE EAST LINE OF LOT 1 OF CERTIFIED SURVEY MAP NO. 4632; ASSUMED BEARING S18°30'13"E.

  
Ritchie P. Wenzel, Professional Land Surveyor, S-4027

COMPLETION DATE OF FIELD WORK: 12/16/25

F:\Shared\1 - Projects\2025\25.6006.03 - Elite Piers\25.6006.03 - Platt - W3806 Lackey Lane - Lake Geneva\CAD\Design\25.6006.03 S.dwg



**LYNCH & ASSOCIATES**  
ENGINEERING CONSULTANTS, LLC  
5000 S. TOWNE DRIVE, SUITE 160  
NEW BERLIN, WI 53151  
440 MILWAUKEE AVENUE  
BURLINGTON, WI 53105  
(262) 402-5040