


PLAT OF SURVEY – AS-BUILT
LOT 8 OF THE TRINKE ESTATES

LOCATED IN THE NE 1/4 OF THE SE 1/4 OF SECTION 10
TOWN 1 SOUTH, RANGE 17 EAST
TOWN OF LINN, WALWORTH COUNTY, WISCONSIN

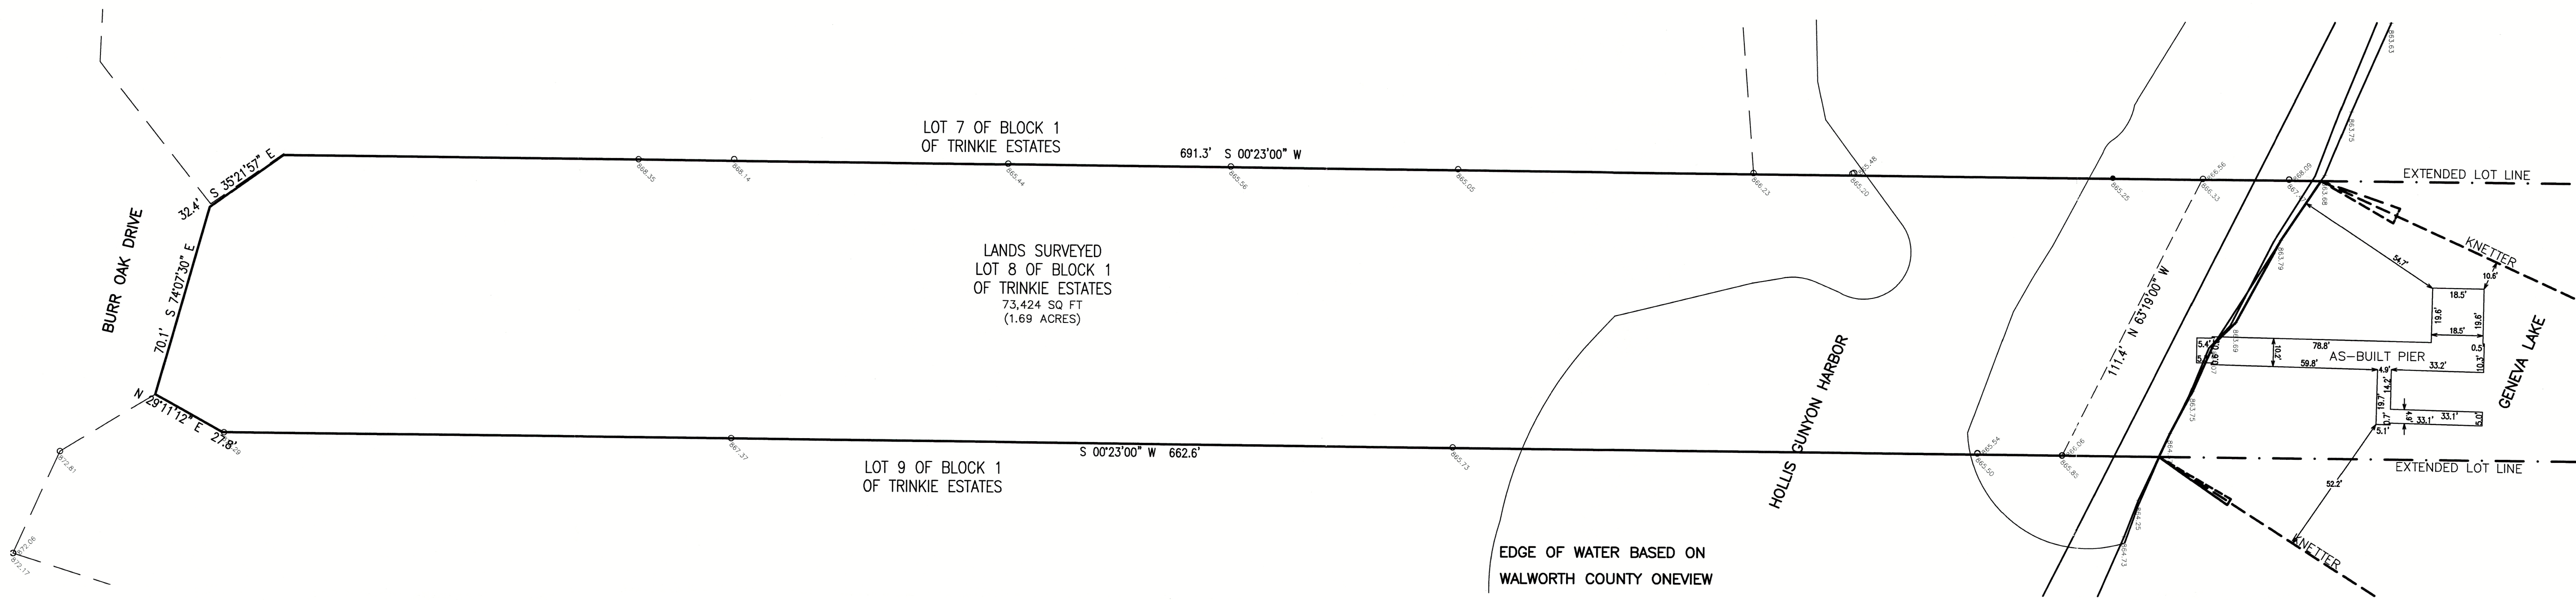

GRID NORTH
WISCONSIN STATE PLANE COORDINATE SYSTEM
SOUTH ZONE (NAD-83)
SOUTH LINE OF THE NE 1/4 OF
SECTION 10-1-17 BEARS
N 00°23'00" W



LEGEND	
○	= IRON PIPE FOUND 1 3/8" O.D.
{xxx}	= RECORDED AS
+xxxx	= EXISTING GROUND ELEVATION
xxxxx	= EXISTING LAND CONTOURS
xxxxx	= EXISTING GRADE
xxxxx	= PROPOSED FINISHED GRADE

NOTE: COPIES OF THIS MAP TO WHICH THE FOLLOWING CERTIFICATE WILL APPLY SHOW THE SURVEYOR'S ORIGINAL SEAL AND SIGNATURE IN RED INK. COPIES BY ANY OTHER MEANS MAY HAVE ALTERATIONS WHICH DO NOT REPRESENT THE SURVEYOR'S WORK PRODUCT.

I HEREBY CERTIFY THAT THE ABOVE DESCRIBED PROPERTY HAS BEEN SURVEYED UNDER MY DIRECTION AND THAT THE ABOVE MAP IS A TRUE REPRESENTATION THEREOF AND SHOWS THE SIZE AND LOCATION OF THE PROPERTY AND ITS EXTERIOR BOUNDARIES. THIS SURVEY IS MADE FOR THE USE OF THE PRESENT OWNERS OF THE PROPERTY, AND ALSO THOSE WHO PURCHASE, MORTGAGE, OR GUARANTEE THE TITLE THERETO WITHIN ONE YEAR FROM THE DATE HEREOF. FIELDWORK COMPLETED 07/17/2025.

DATED: 07/25/2025

CHRISTOPHER A. HODGES P.L.S. 2760

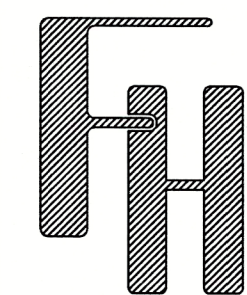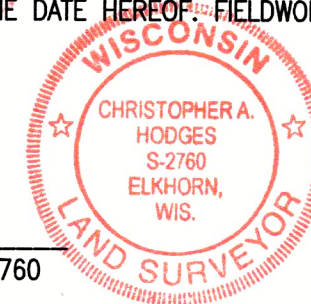

AS-BUILT
W3322 BURR OAK DRIVE
LINN, WI

— WORK ORDERED BY —
COMPLETE PIERS & LIFTS
P.O. BOX 917
EAST TROY, WI 53120

FARRIS, HANSEN & ASSOCIATES, INC.
ENGINEERING — ARCHITECTURE — SURVEYING
7 RIDGWAY COURT P.O. BOX 437
ELKHORN, WISCONSIN 53121
PHONE: (262) 723-2098 e-mail: office@farris-hansen.com

REVISIONS
10/30/2025 - KK
As-built pier

PROJECT NO.
11249
DATE
07/25/2025
SHEET NO.
1 OF 1