
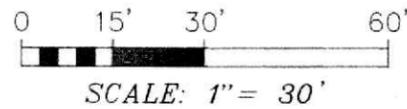


**LEGEND**

- FOUND 1-3/4" O.D. IRON PIPE
- FOUND 1-5/16" O.D. IRON PIPE
- FOUND PINCHED IRON PIPE
- ♂ FOUND IRON PIPE WITH 1" DIAMETER STEEL CAP
- ( ) RECORDED AS
- ▲ UTILITY POLE
- UTILITY BOX


BEARINGS HEREON RELATE TO THE SOUTH LINE OF LOT 18A IN BLOCK 2 OF "TRINKE ESTATES". ASSUMED BEARING OF WEST AS PLATTED.

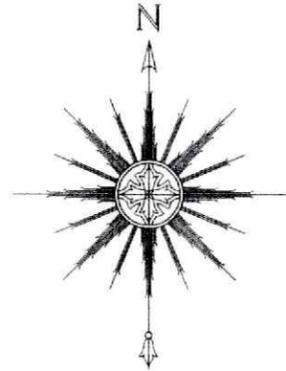


"I HEREBY CERTIFY THAT I HAVE SURVEYED THE ABOVE DESCRIBED PROPERTY AND THAT THE ABOVE MAP IS A CORRECT REPRESENTATION THEREOF AND SHOWS THE SIZE AND LOCATION OF THE PROPERTY, ITS EXTERIOR BOUNDARIES, THE LOCATION OF ALL VISIBLE STRUCTURES AND DIMENSIONS OF ALL PRINCIPAL BUILDINGS THEREON, BOUNDARY FENCES, APPARENT EASEMENTS, ROADWAYS AND ENCROACHMENTS, IF ANY."

"THIS SURVEY IS MADE FOR THE USE OF THE PRESENT OWNERS OF THE PROPERTY, AND THOSE WHO PURCHASE, MORTGAGE, OR GUARANTEE THE TITLE THERETO WITHIN ONE YEAR FROM DATE HEREOF."

**SATTER SURVEYING, LLC**  
 LAND SURVEYS, MAPPING AND PLANNING  
 272 ORIGEN STREET  
 BURLINGTON, WI 53105  
 262-661-4239

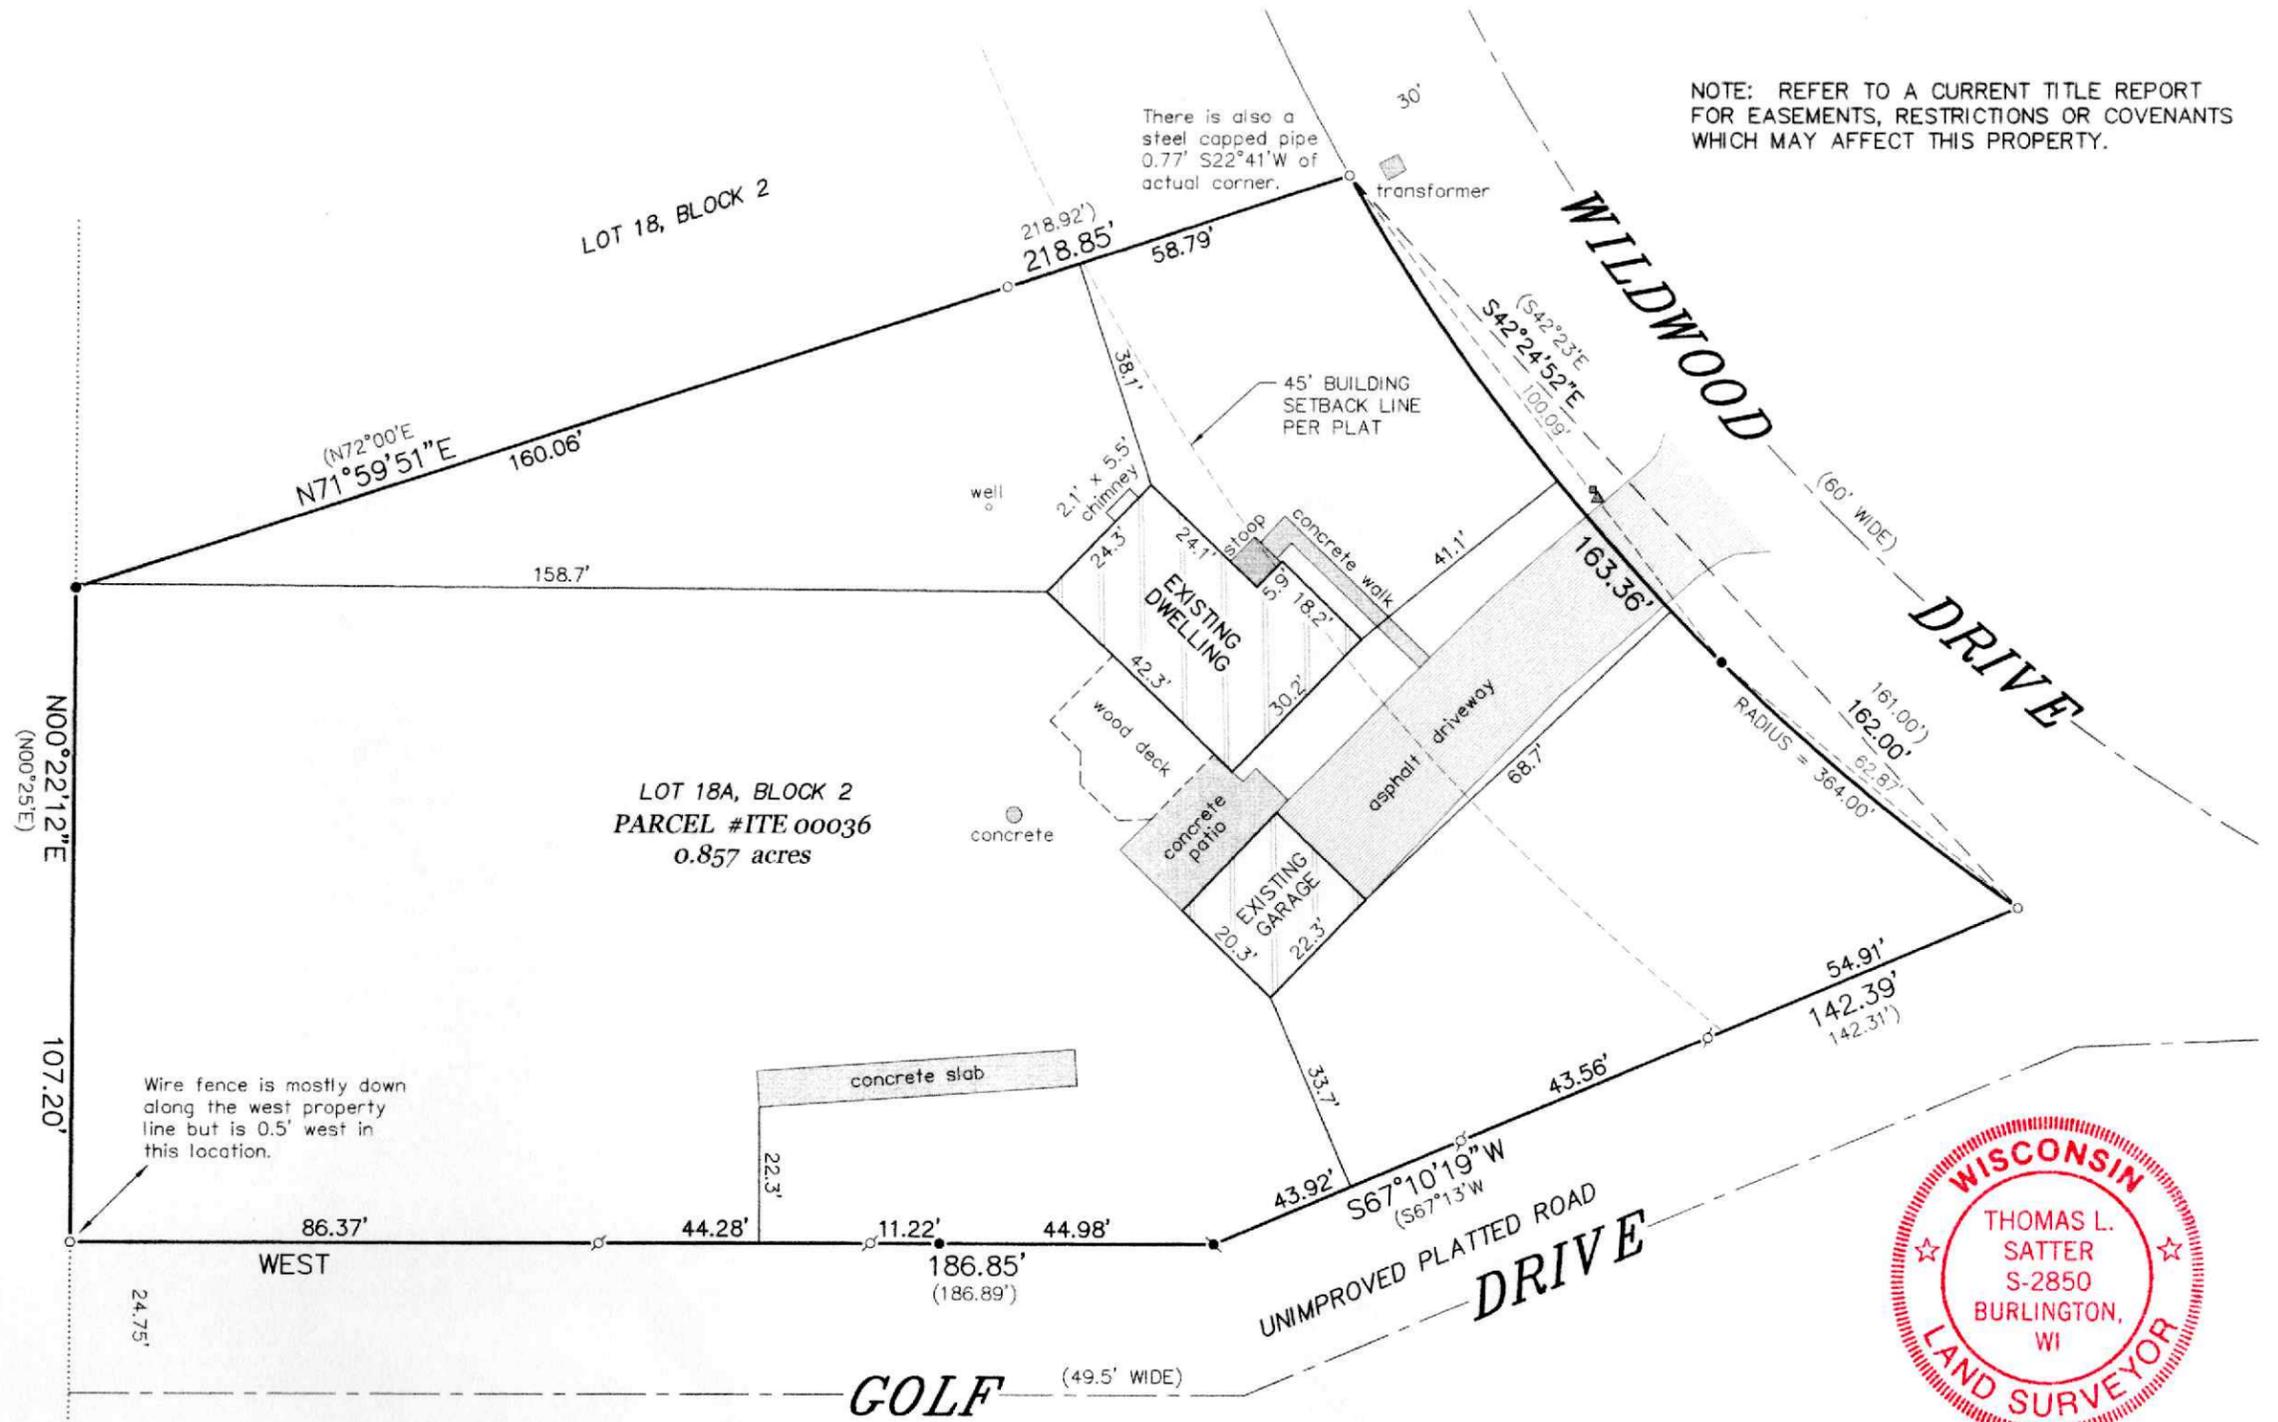

NOTE: REFER TO A CURRENT TITLE REPORT FOR EASEMENTS, RESTRICTIONS OR COVENANTS WHICH MAY AFFECT THIS PROPERTY.

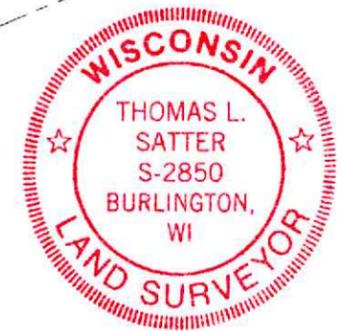

THIS IS NOT AN ORIGINAL PRINT UNLESS THIS SEAL IS RED.

*Thomas L. Satter*  
 THOMAS L. SATTER S-2850

**PLAT OF SURVEY**  
 -OF-

LOT 18A IN BLOCK 2 OF "TRINKE ESTATES", A SUBDIVISION LOCATED IN GOVERNMENT LOT 1 IN THE SOUTHEAST 1/4 OF THE SOUTHEAST 1/4 AND THE NORTHEAST 1/4 OF THE SOUTHEAST 1/4 OF SECTION 10, TOWNSHIP 1 NORTH, RANGE 17 EAST OF THE FOURTH PRINCIPAL MERIDIAN, IN THE TOWN OF LINN, WALWORTH COUNTY, WISCONSIN.

SURVEY FOR: TRICIA FORBECK OF COMPASS REAL ESTATE  
 SURVEY ADDRESS: N1757 WILDWOOD DRIVE, LAKE GENEVA, WI 53147

NOVEMBER 14, 2025  
 DATE

112501  
 JOB NUMBER