
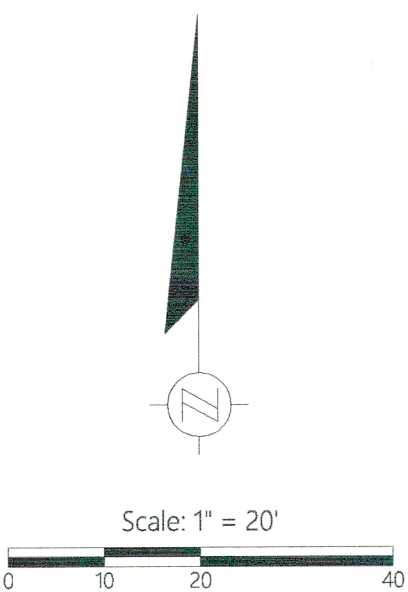
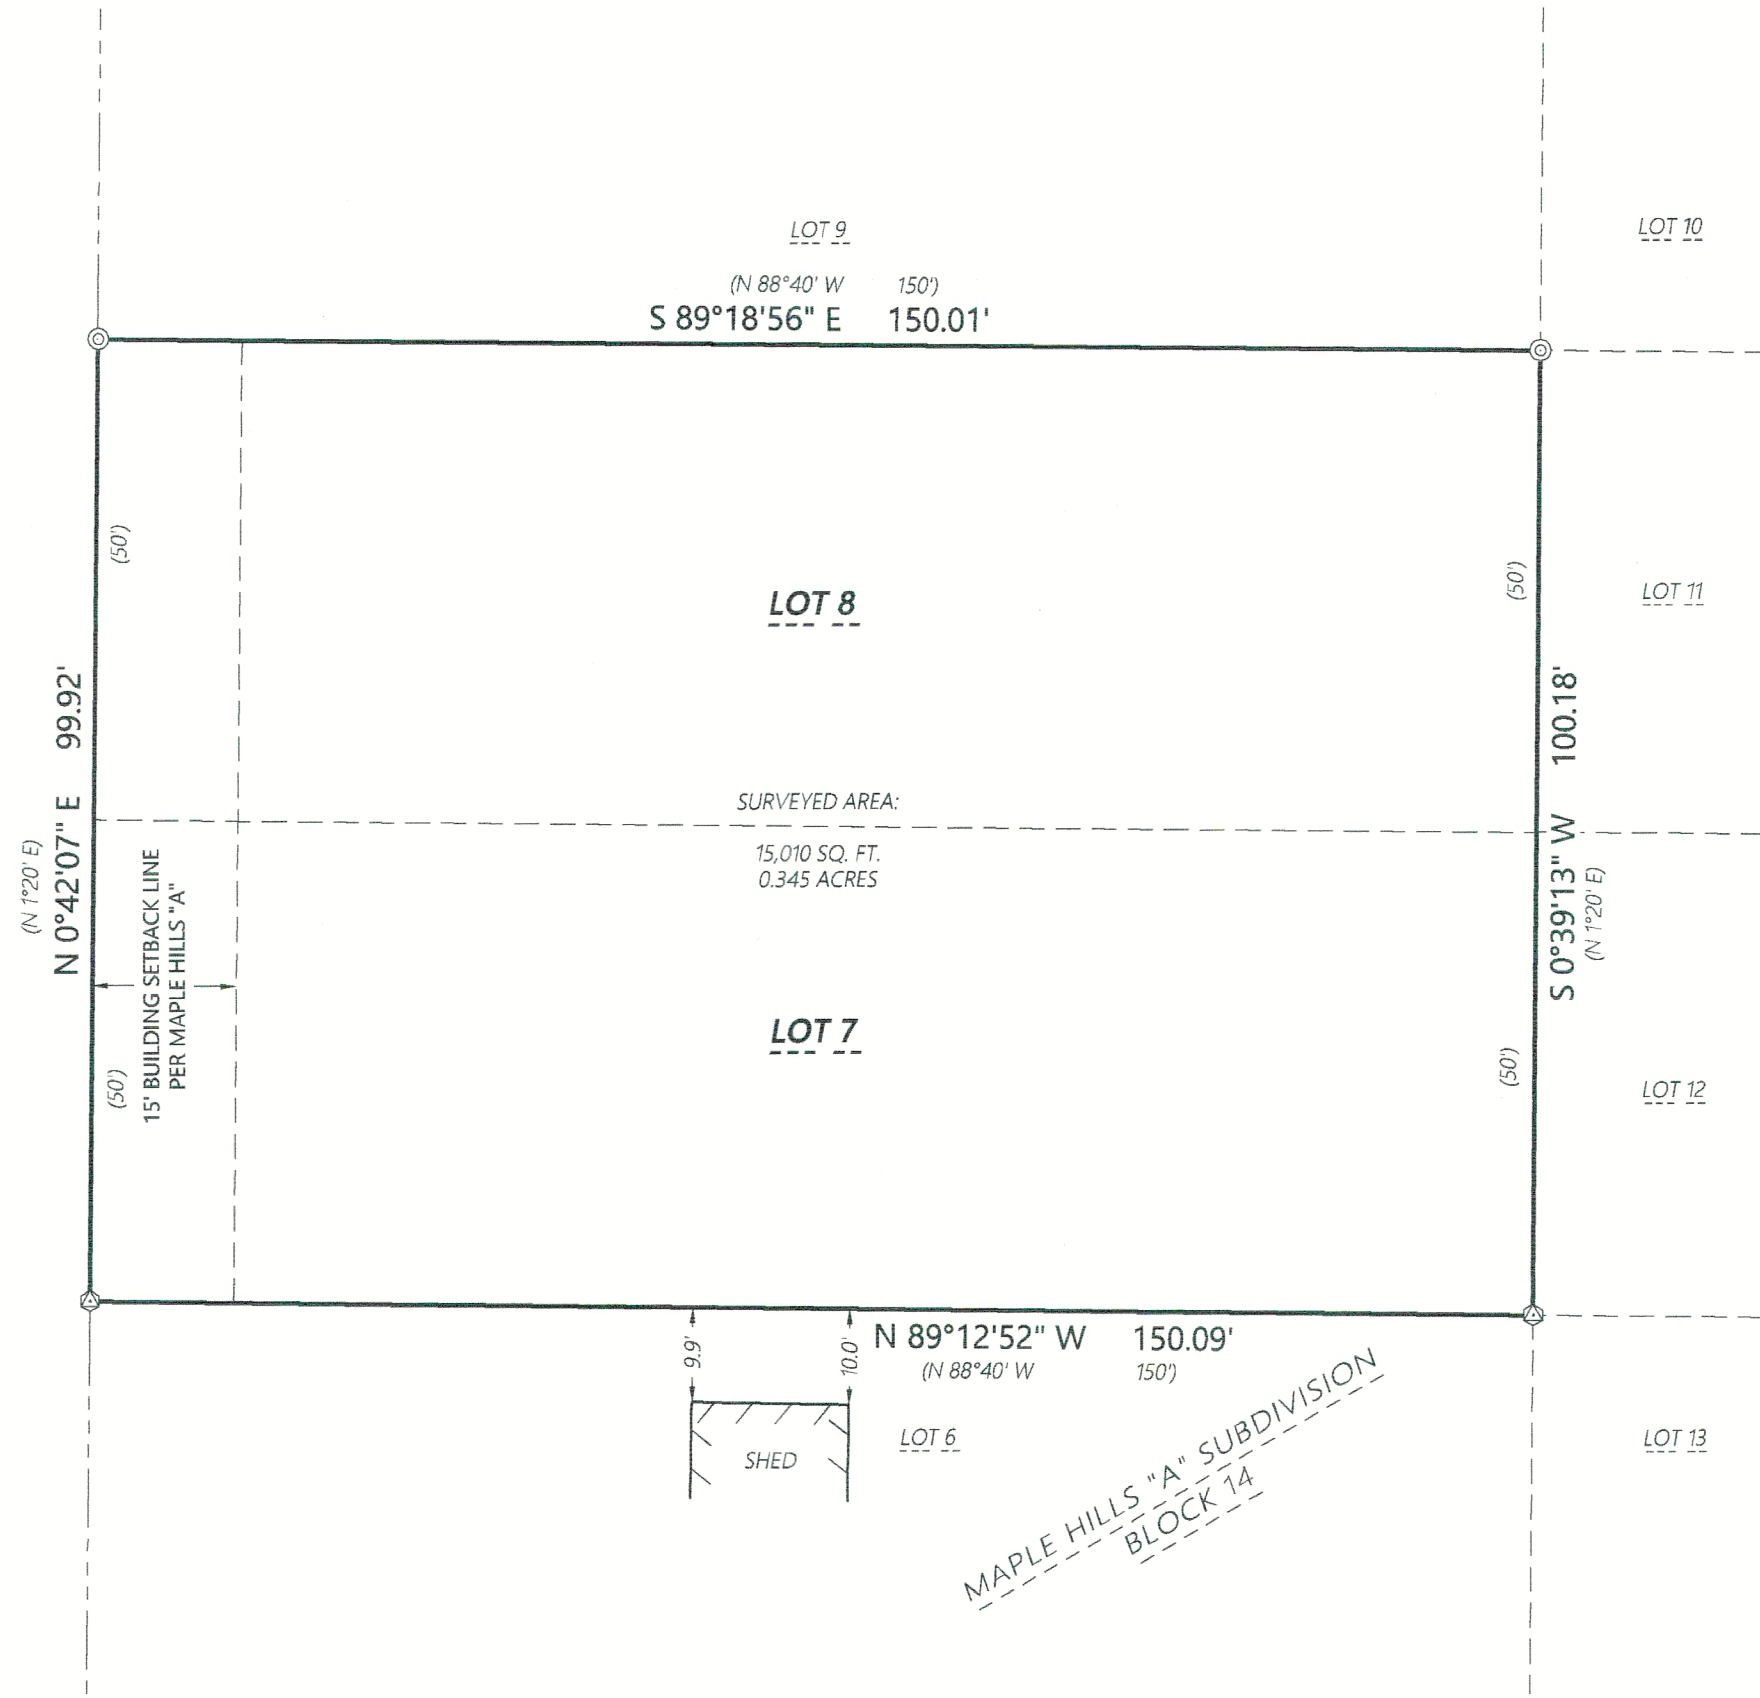


PLAT OF SURVEY

OF LOTS 7 & 8, BLOCK 14, AND LOT 12, BLOCK 13 OF MAPLE HILLS "A" SUBDIVISION,
BEING PART OF THE SW 1/4 OF THE SE 1/4 OF SECTION 18, T. 1 N., R. 17 E.,
OF THE 4TH P.M., TOWN OF LINN, WALWORTH COUNTY, WISCONSIN

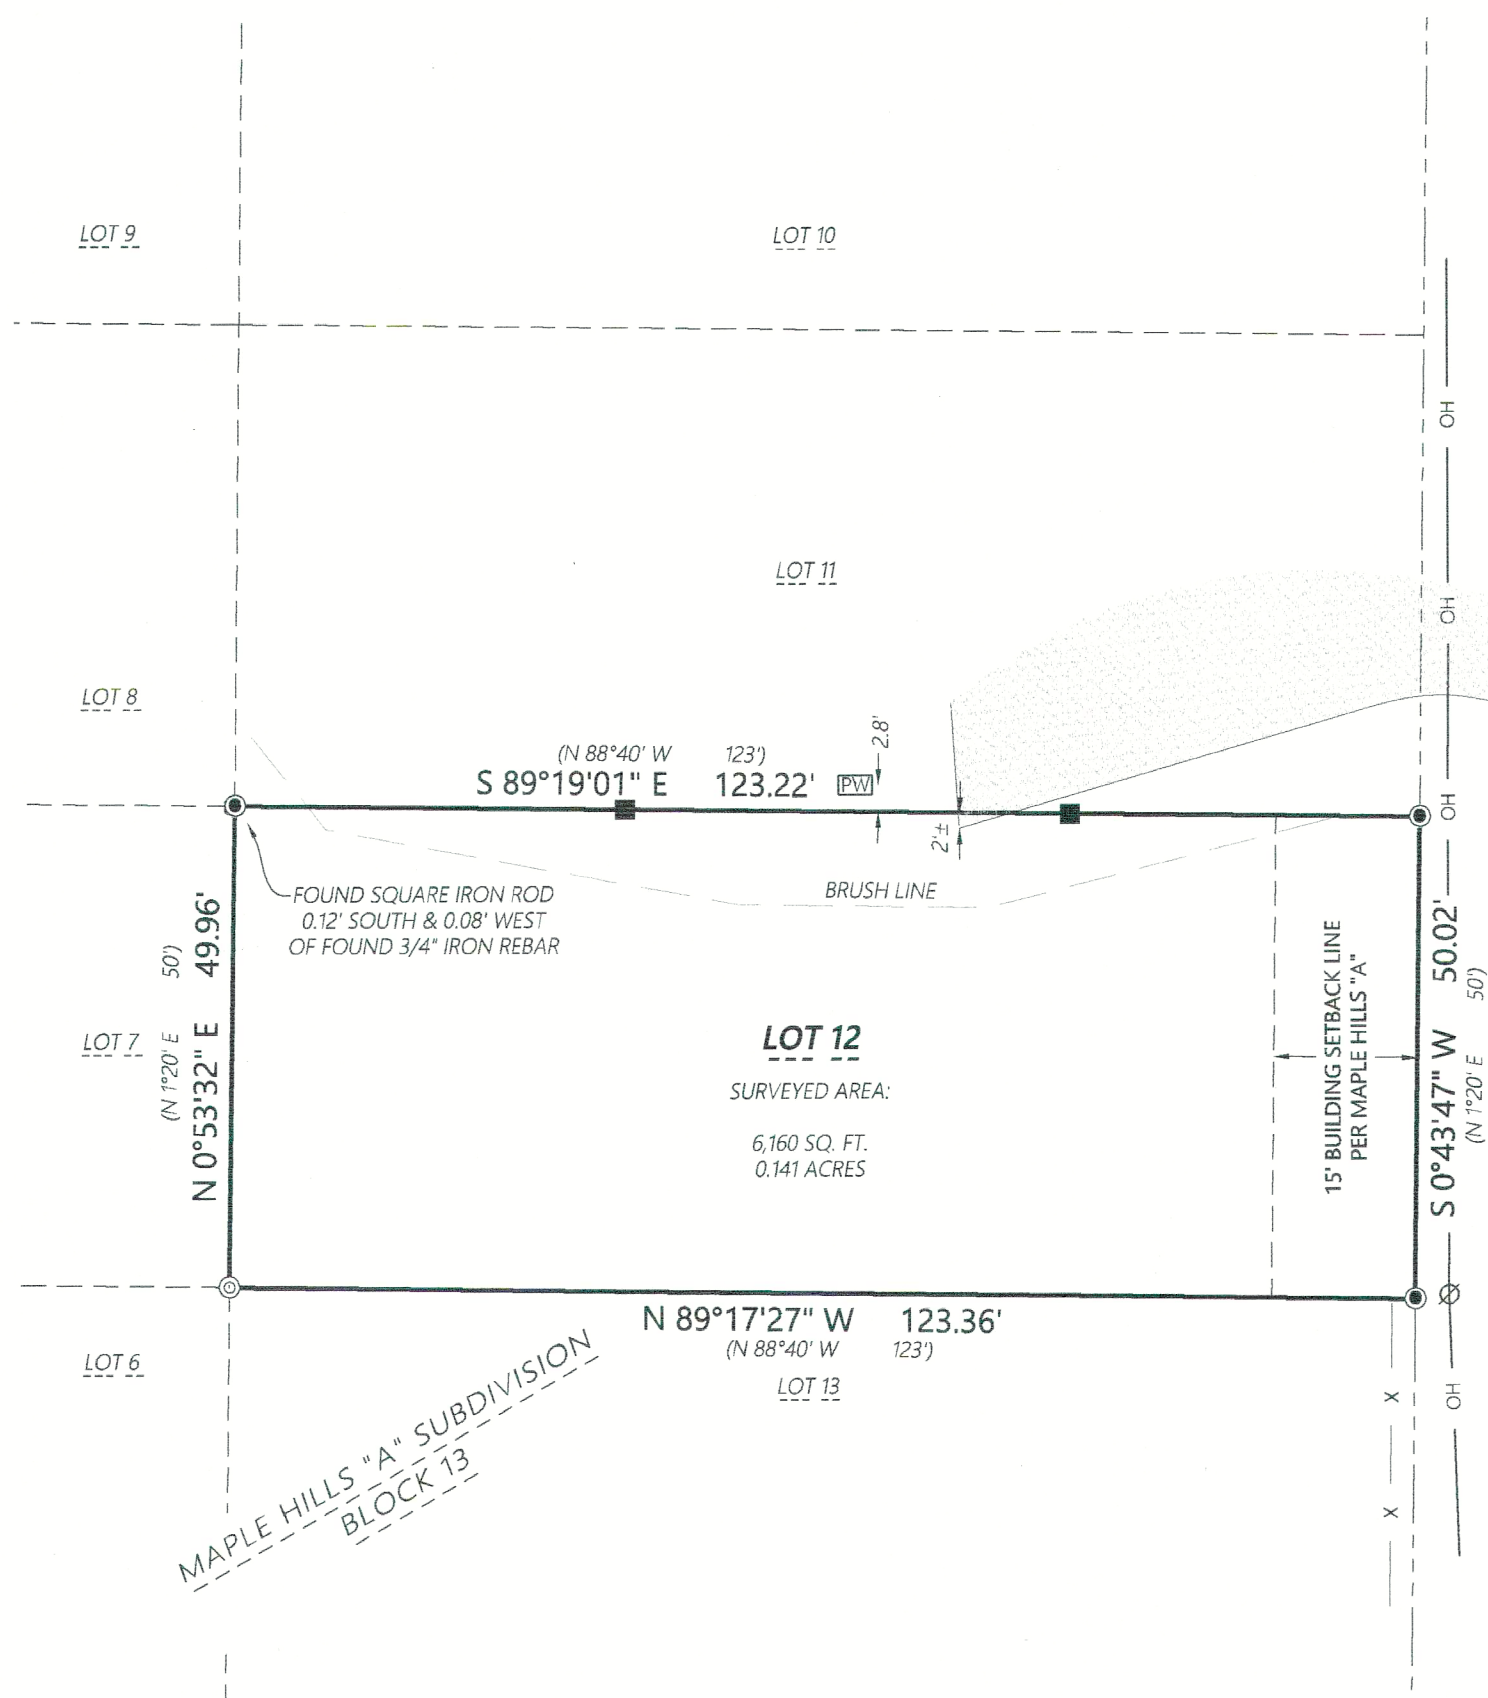

DISTANCE UNITS BASED ON THE UNITED STATES SURVEY FOOT
BEARINGS BASED ON THE WISCONSIN COORDINATE REFERENCE
SYSTEM, WALWORTH ZONE. THE EAST LINE OF SUMMIT DRIVE
BEARING N 0°42'07" E

SURVEY NOTES

1. SURVEYED PROPERTY SUBJECT TO ANY AND ALL EASEMENTS AND AGREEMENTS RECORDED AND UNRECORDED.
2. NO BUILDINGS EXIST ON SUBJECT PROPERTY AT THE TIME OF THIS SURVEY.

MONUMENT KEY

- 3/4" Iron Rebar Found
- ⊙ Square Iron Rod
- Wooden Lath Set on Line
- (XXX.XX) Record Information

LEGEND


- Existing Boundary Line
- - - Existing Right-of-Way
- - - Existing Adjacent Property
- X Existing Wood Plank Fence
- OH Existing Overhead Power
- ⊗ Existing Utility Pole
- Ⓜ Existing Well
- Existing Asphalt Pavement
- Existing Gravel Driveway

Kristin J. Belongia

Kristin J. Belongia, P.L.S.
Wisconsin Professional Land Surveyor S-2943

State of Wisconsin } ss
County of Walworth }

I hereby certify that I have supervised the survey of the property described above and to the best of my knowledge and belief, the plat drawn hereon complies with Chapter A-E 7 of the State of Wisconsin Administrative Code, Minimum Standards for Property Surveys and correctly represents said survey and its location.
Given under my hand and seal at Elkhorn, Wisconsin this 3rd day of March, 2026
Last day of field work March 2nd, 2026

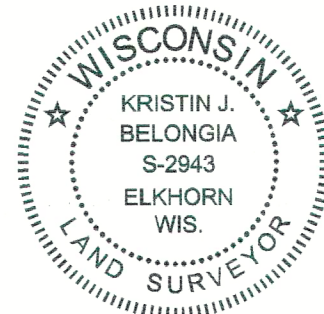

If the surveyor's signature is not red in color, the plan is a copy that should be assumed to contain unauthorized alterations.
The certification contained on this document shall not apply to any copies.



Batterman
engineers surveyors planners
BELOIT | ELKHORN | JANESVILLE
2857 S. Bartells Dr., Beloit, WI 53511
608.365.4464 | www.rhbatterman.com

PLAT OF SURVEY

FOR THE EXCLUSIVE USE OF:
Xavier Keutgen
2425 N Maplewood Avenue
Chicago, IL 60647

ORDER NO: 35833

FIELD CREW: BMR
DRAWN BY: BMR
SHEET 1 OF 1

1M1-266 + 278A

117-5133