


REGISTERED PROFESSIONAL LAND SURVEYOR
LAKE GENEVA, WISCONSIN



LDT 12, ROBINSON'S FIRST SUBDIVISION,
T 1 N, R 17 E, WALWORTH COUNTY,
WISCONSIN.

ACCURACY: DISTANCES: $\pm 0.01'$
 ANGLES: $\pm 15''$
 ERROR OF CLOSURE: LESS THAN
 ONE PART IN 3,000

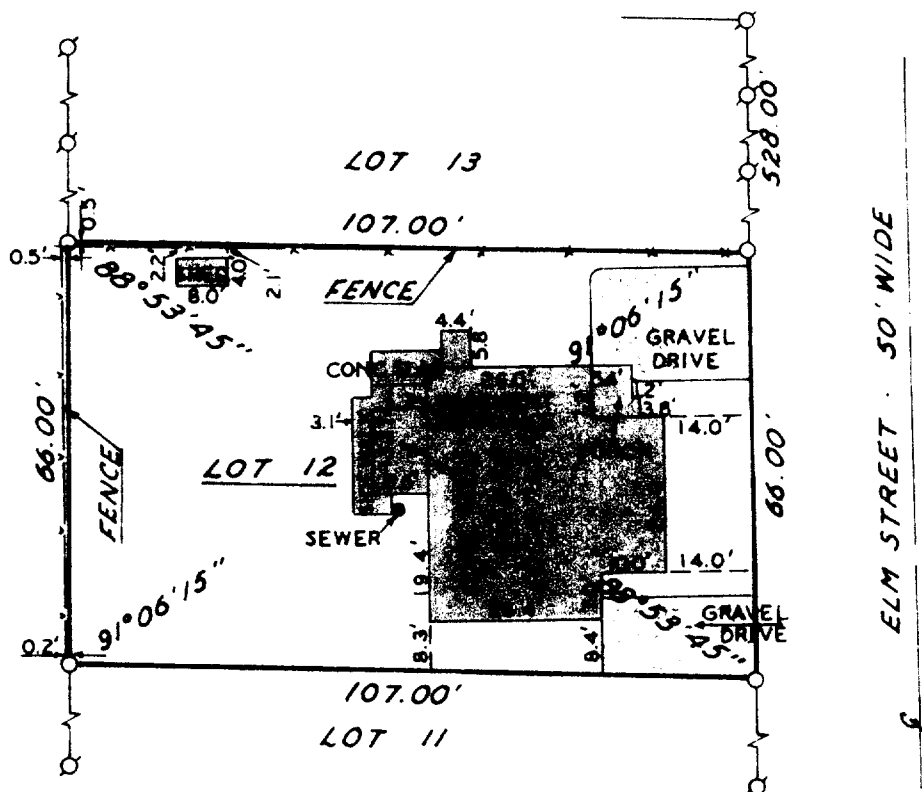

SCALE: 1"=30'

LEGEND

- φ — IRON PIPE FOUND
 O — IRON PIPE PLACED
 ● — CONCRETE MONUMENT
 x — SPIKE
 () PLATTED AS

I, HAROLD H. KOLB, DO HEREBY CERTIFY THAT I HAVE SURVEYED THE PROPERTY HEREON DESCRIBED ACCORDING TO THE OFFICIAL RECORDS AND THAT THE PLAT HEREON IS A CORRECT REPRESENTATION OF THE LOT LINES, AND THE PRINCIPLE BOUNDING LINE THEREON.

HAROLD H. KOLB
WISCONSIN REGISTERED LAND SURVEYOR. S-187
DATE April 12, 1976

117-518