


PLAT OF SURVEY

OF

Lots 52 and 54 of Shore Haven, A Subdivision Located in
Government Lot 2, Section 18, Town 1 North, Range 17 East
Walworth County, Wisconsin

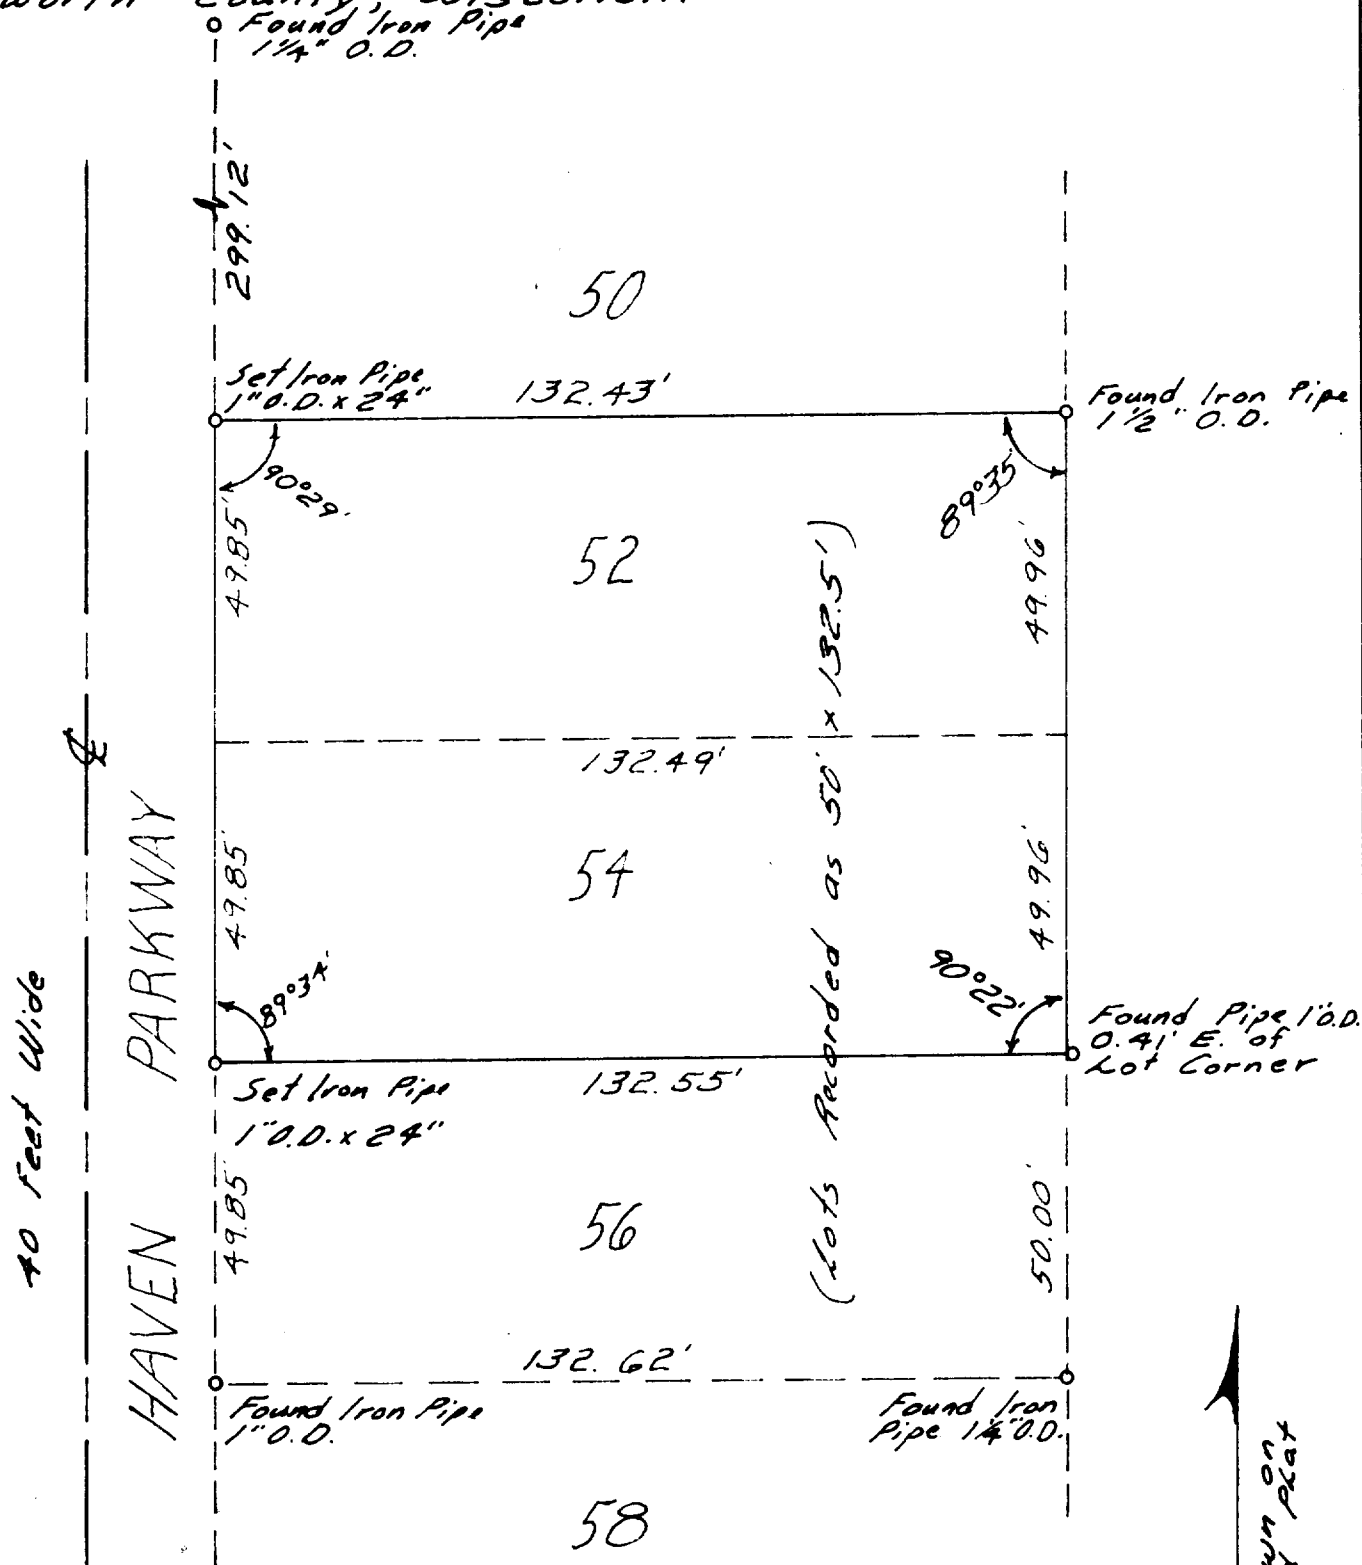

SURVEY AND PLAT BY

JENSEN & JOHNSON, INC.

CIVIL ENGINEERS AND SURVEYORS

Elkhorn, Wisconsin

LEGEND

- — Iron Pipe
- — Concrete Monument

Scale 1" = 30'

WE CERTIFY: That we have surveyed the above described property and that the plat shown hereon is an accurate survey and a true representation thereof and correctly shows the exterior boundary lines and all divisions of said property.

ISA-51

Date Oct. 1, 1976

Job # 1658.057

Survey & Plat for Alma Thompson

Lloyd L. Jensen
LLOYD L. JENSEN,

Wisconsin Registered Land Surveyor, No. S-211

117-521