


DUNHAM SURVEYING, S.C.
SURVEYING & SUBDIVIDING
DELAVAL, WISCONSIN 53115

N

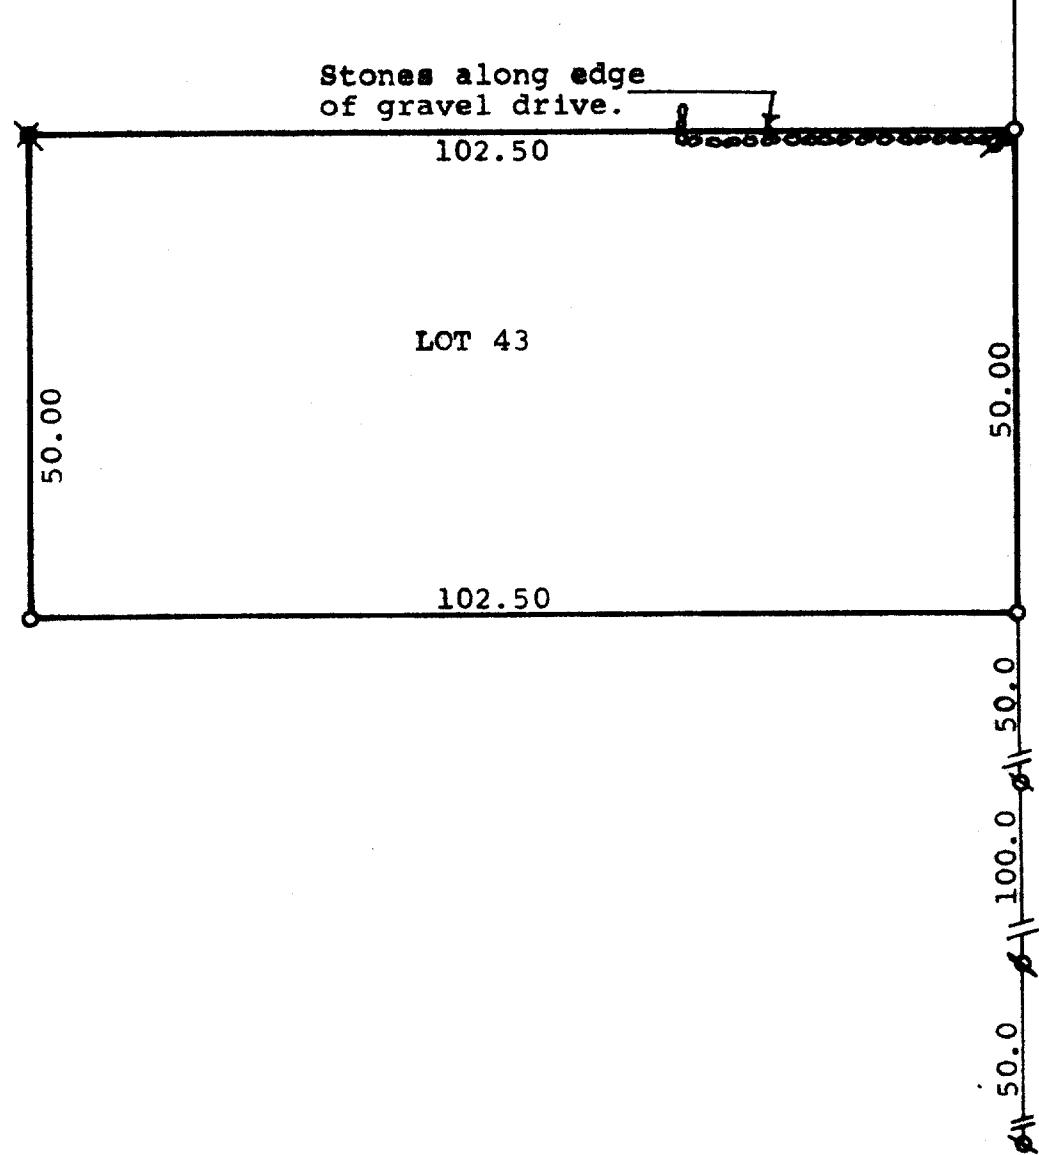

Scale - 1" = 20'
○ = Iron Pipe Set
✖ = Iron Pipe Found
and reset
✖ = Iron Pipe Found

STATE OF WISCONSIN)
COUNTY OF WALWORTH) SS

I, James M. Dunham, Surveyor, certify that I have
surveyed the property described as follows,
Lot 43 of Shore Haven, a subdivision located in
Fractional Section 18, T 1 N, R 17 E, Walworth
County, Wisconsin,
and the above map is a true representation thereof and shows
the size and location of the property, its exterior boundaries,
the location and dimensions of all structures thereon, fences,
apparent easements and roadways and visible encroachments, if
any.
This survey is made for the exclusive use of the present owners
of the property, and also those who purchase, mortgage, or
guarantee the title thereto within one (1) year from date hereof;
and as to them I warrant the accuracy of said survey and map.
October 20, 1976

James M. Dunham
James M. Dunham, Surveyor

