


KOLB LAND CONSULTING, INC.
LAND SURVEYING • SUBDIVIDING • LAND PLANNING

LAKE GENEVA, WISCONSIN 53147

WHITEWATER, WISCONSIN 53190

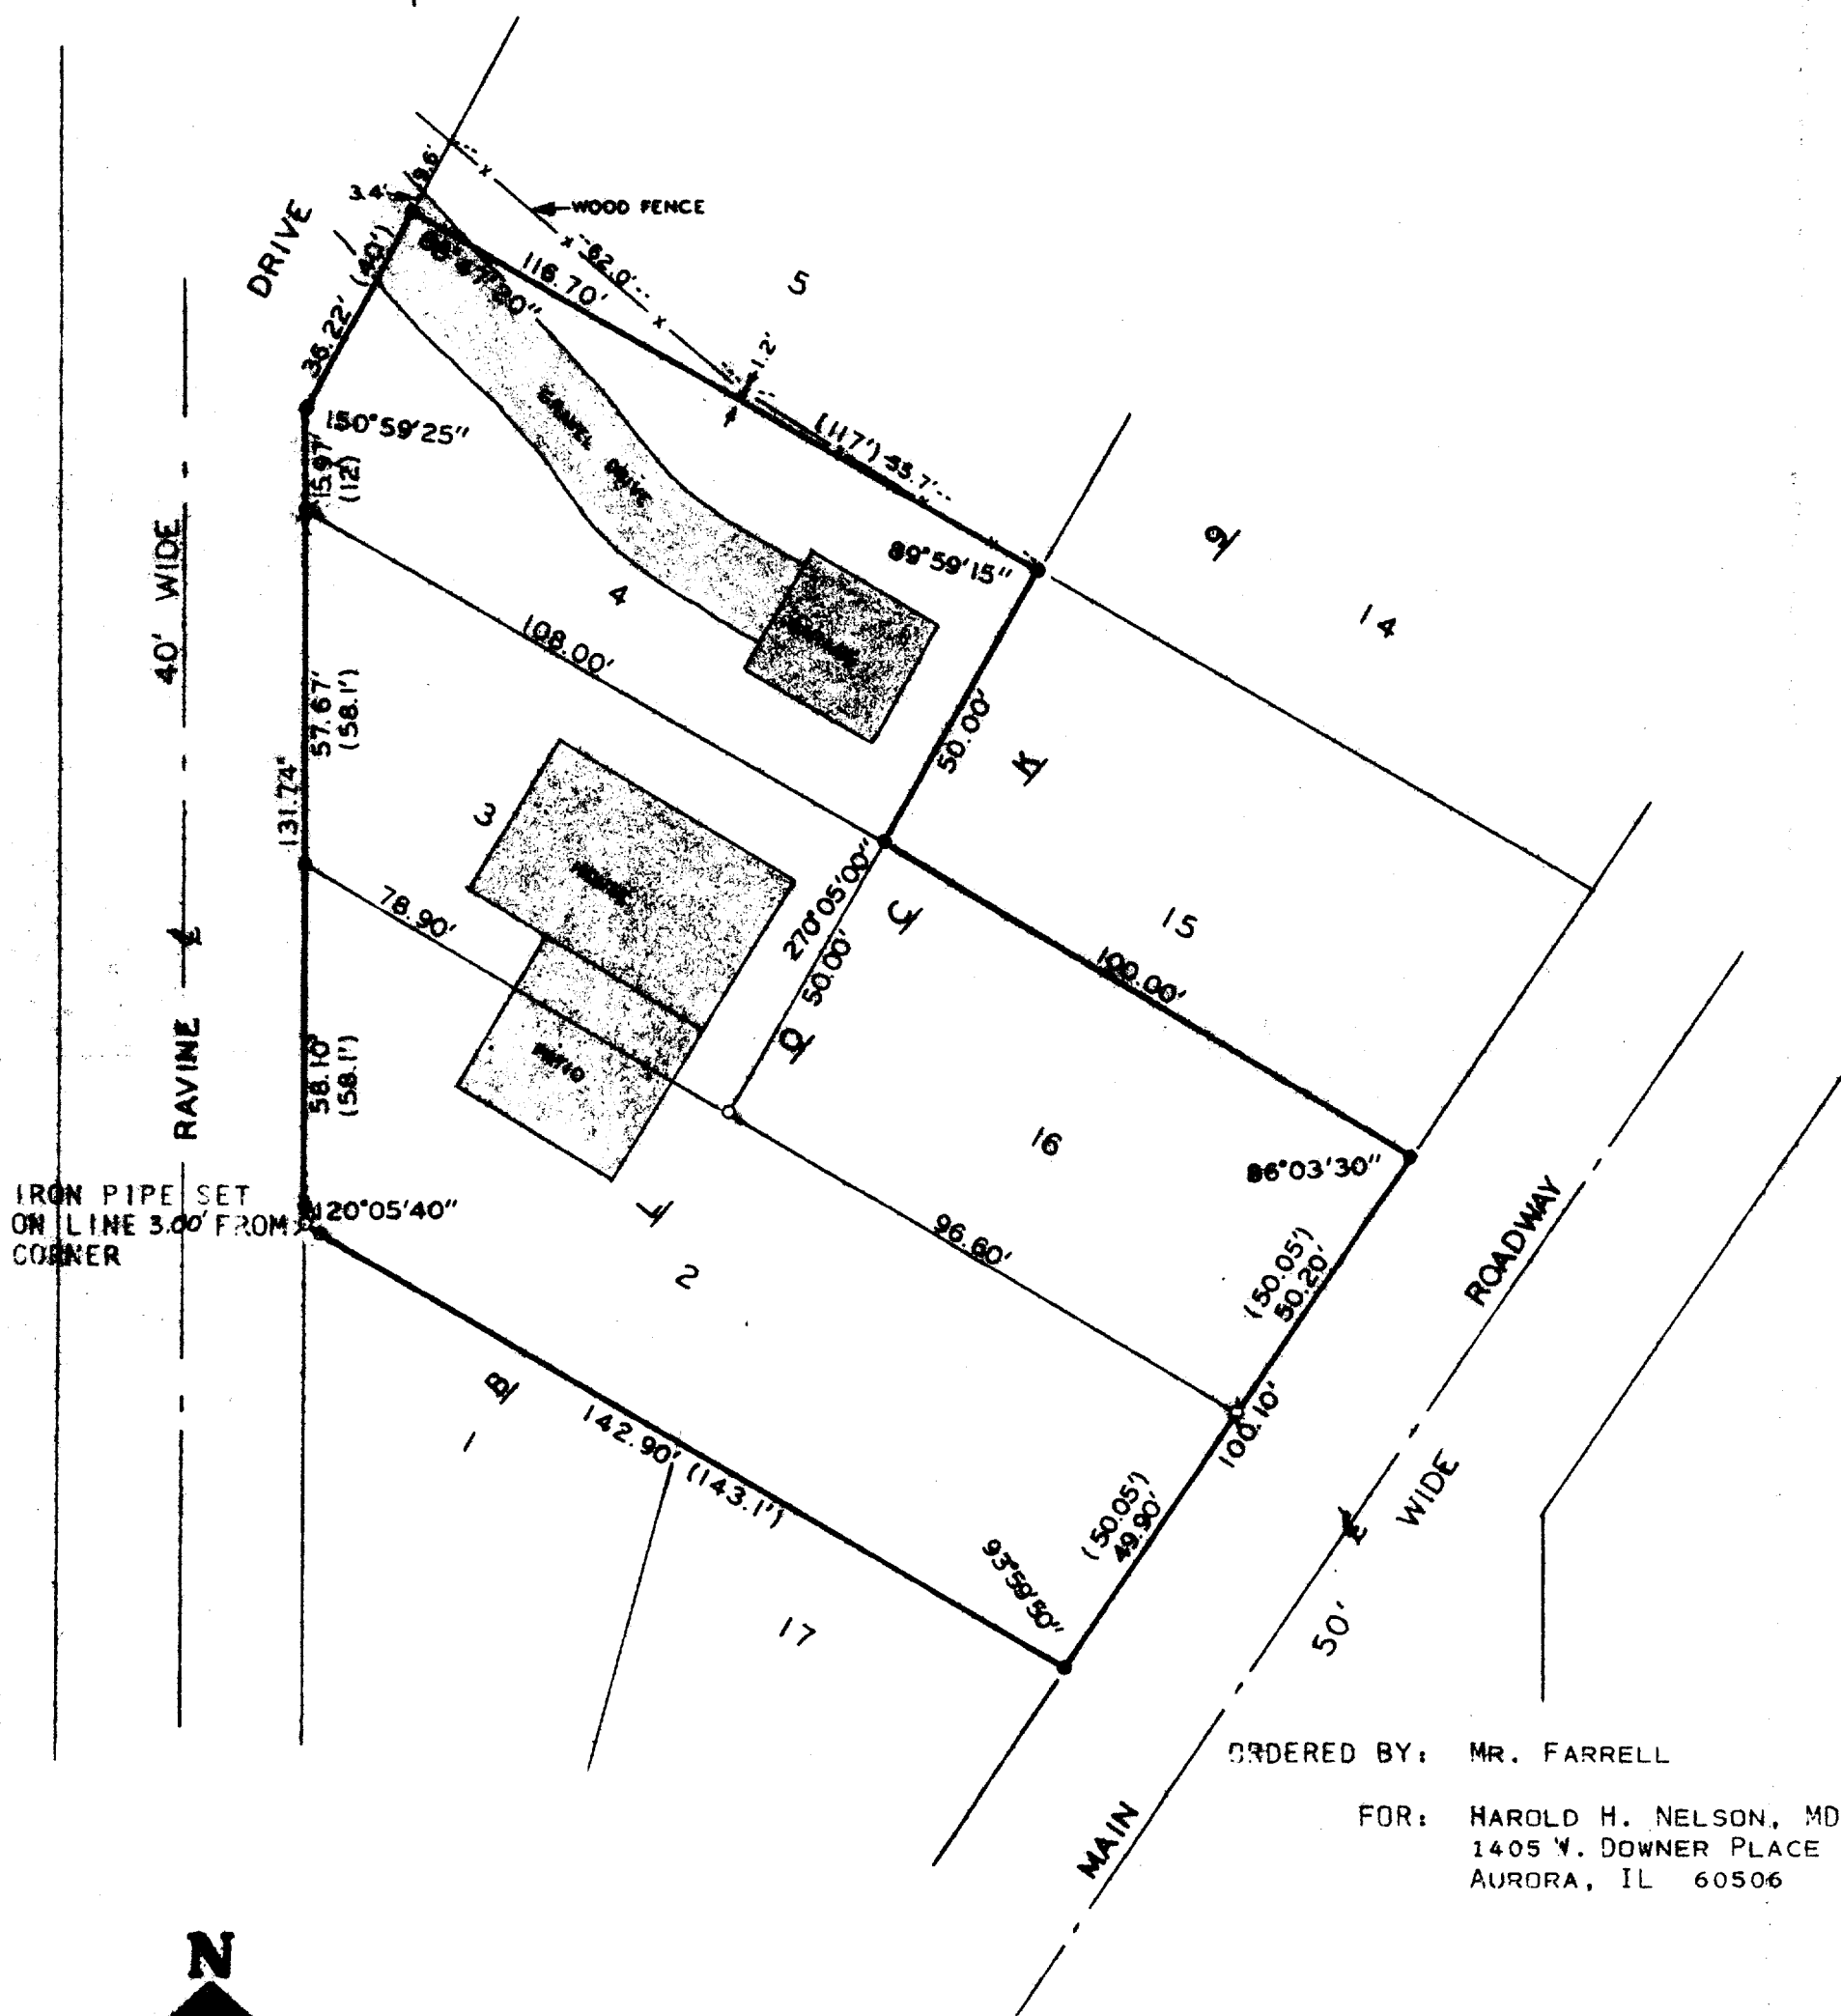

ORDERED BY: MR. FARRELL

FOR: HAROLD H. NELSON, MD
1405 W. DOWNER PLACE
AURORA, IL 60506



PLAT OF SURVEY OF

SCALE: 1"=30'

LEGEND

- - IRON PIPE FOUND, REPLACED WITH CONCRETE MONUMENTS
- - IRON PIPE FOUND
- - IRON PIPE SET

PLAT OF SURVEY OF LOTS 2, 3, 4 AND 16, BLOCK 9, SUNSET HILLS SUBDIVISION, TOWN 1 NORTH, RANGE 17 EAST, WALWORTH COUNTY, WISCONSIN.



I, HAROLD H. KOLB, DO HEREBY CERTIFY THAT I HAVE SURVEYED THE PROPERTY HEREON DESCRIBED ACCORDING TO THE OFFICIAL RECORDS, AND THAT THE PLAT HEREON IS A CORRECT REPRESENTATION OF THE LOT LINES TO THE BEST OF MY KNOWLEDGE AND BELIEF.

Harold H. Kolb
HAROLD H. KOLB
WISCONSIN REGISTERED LAND SURVEYOR, S-187
DATE April 22, 1979
REVISED: NONE, 1965

ISH-116A, 116B, 116C, 122

117-540K