

ROBERS & BOYD, INC.
CONSULTING ENGINEERS & LAND SURVEYORS


PHONE (414) 763-2652

116 E. CHESTNUT ST.

BURLINGTON, WIS. 53105

PLAT OF SURVEY
 FOR
 A. T. KOLTON

Lot 20, Lake Geneva Beach, a subdivision located in the Southwest 1/4 of Section 11, T11N., R17E., of the 4th P.M., Township of Linn, County of Walworth, State of Wisconsin.

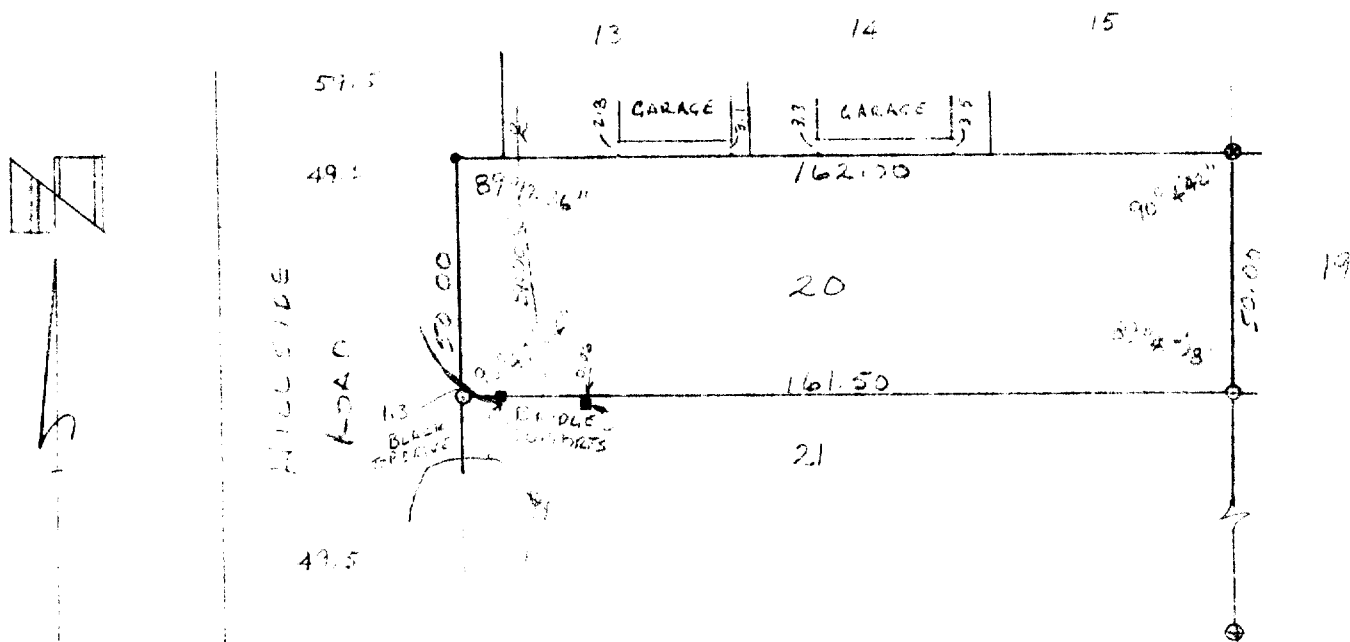

- ~ LEGEND ~
- FOUND 1" IRON PIPE
 - ⊙ FOUND CONCRETE MONUMENT
 - SET 1" X 24" IRON PIPE
- SCALE 1" = 40'

I HEREBY CERTIFY THAT WE HAVE SURVEYED THE LANDS DESCRIBED ABOVE ACCORDING TO OFFICIAL RECORDS AND THAT THE PLAT DRAWN HEREON IS A CORRECT REPRESENTATION OF SAID SURVEY.

WIS. REG. LAND SURVEYOR

DATE

8/17/77

JOB NO.

77171