


HAROLD H. KOLB

REGISTERED PROFESSIONAL LAND SURVEYOR
LAKE GENEVA, WISCONSIN

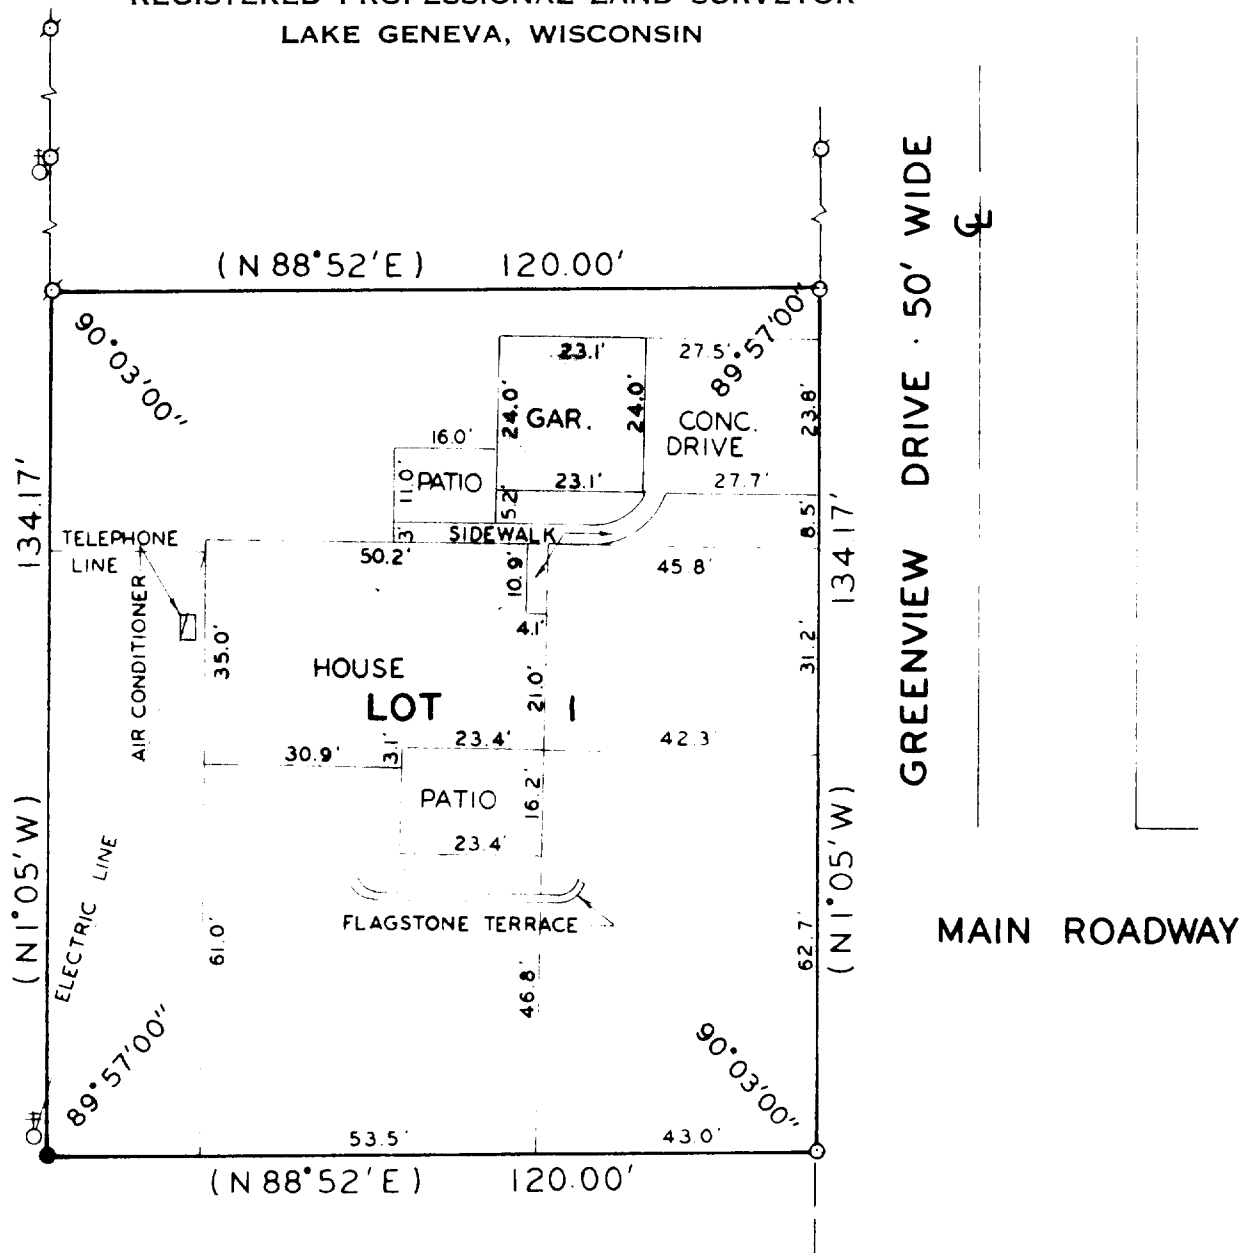

PLAT OF SURVEY OF

LOT 1, SUNSET HILLS SHORES, T1N,
R17E, WALWORTH COUNTY, WISCONSIN.

ACCURACY: DISTANCES $\pm 0.01'$
ANGLES $\pm 05''$

ORDERED BY: MARITTA PALMGREN

ERROR OF CLOSURE LESS THAN
ONE PART IN 3000

NOTE: ALL VISIBLE IMPROVEMENTS LOCATED. COULD NOT LOCATE WELL OR SEPTIC.

I HAVE SURVEYED THE ABOVE-DESCRIBED PROPERTY AND THE ABOVE MAP IS A TRUE REPRESENTATION THEREOF AND SHOWS THE SIZE AND LOCATION OF THE PROPERTY, ITS EXTERIOR BOUNDARIES, THE LOCATION OF ALL APPARENT EASEMENTS AND ROADWAYS AND VISIBLE ENCROACHMENTS, IF ANY.

THIS SURVEY IS MADE FOR THE USE OF THE PRESENT OWNERS OF THE PROPERTY, AND ALSO THOSE WHO PURCHASE, MORTGAGE, OR GUARANTEE THE TITLE THERETO WITHIN ONE (1) YEAR FROM DATE HEREOF.

N
SCALE · 1" = 30'
LEGEND

○ — IRON PIPE PLACED. 1" x 24" 1.13 LB. LIN. FT.
● — IRON BAR FOUND
⊗ — IRON PIPE FOUND
⊕ — POWER POLE

Harold H. Kolb
HAROLD H. KOLB
WISCONSIN REGISTERED LAND SURVEYOR, S-187
DATE FEB. 17, 1977

117-554