


DUNHAM SURVEYING, S.C.
SURVEYING & SUBDIVIDING
DELAVAN, WISCONSIN 53115

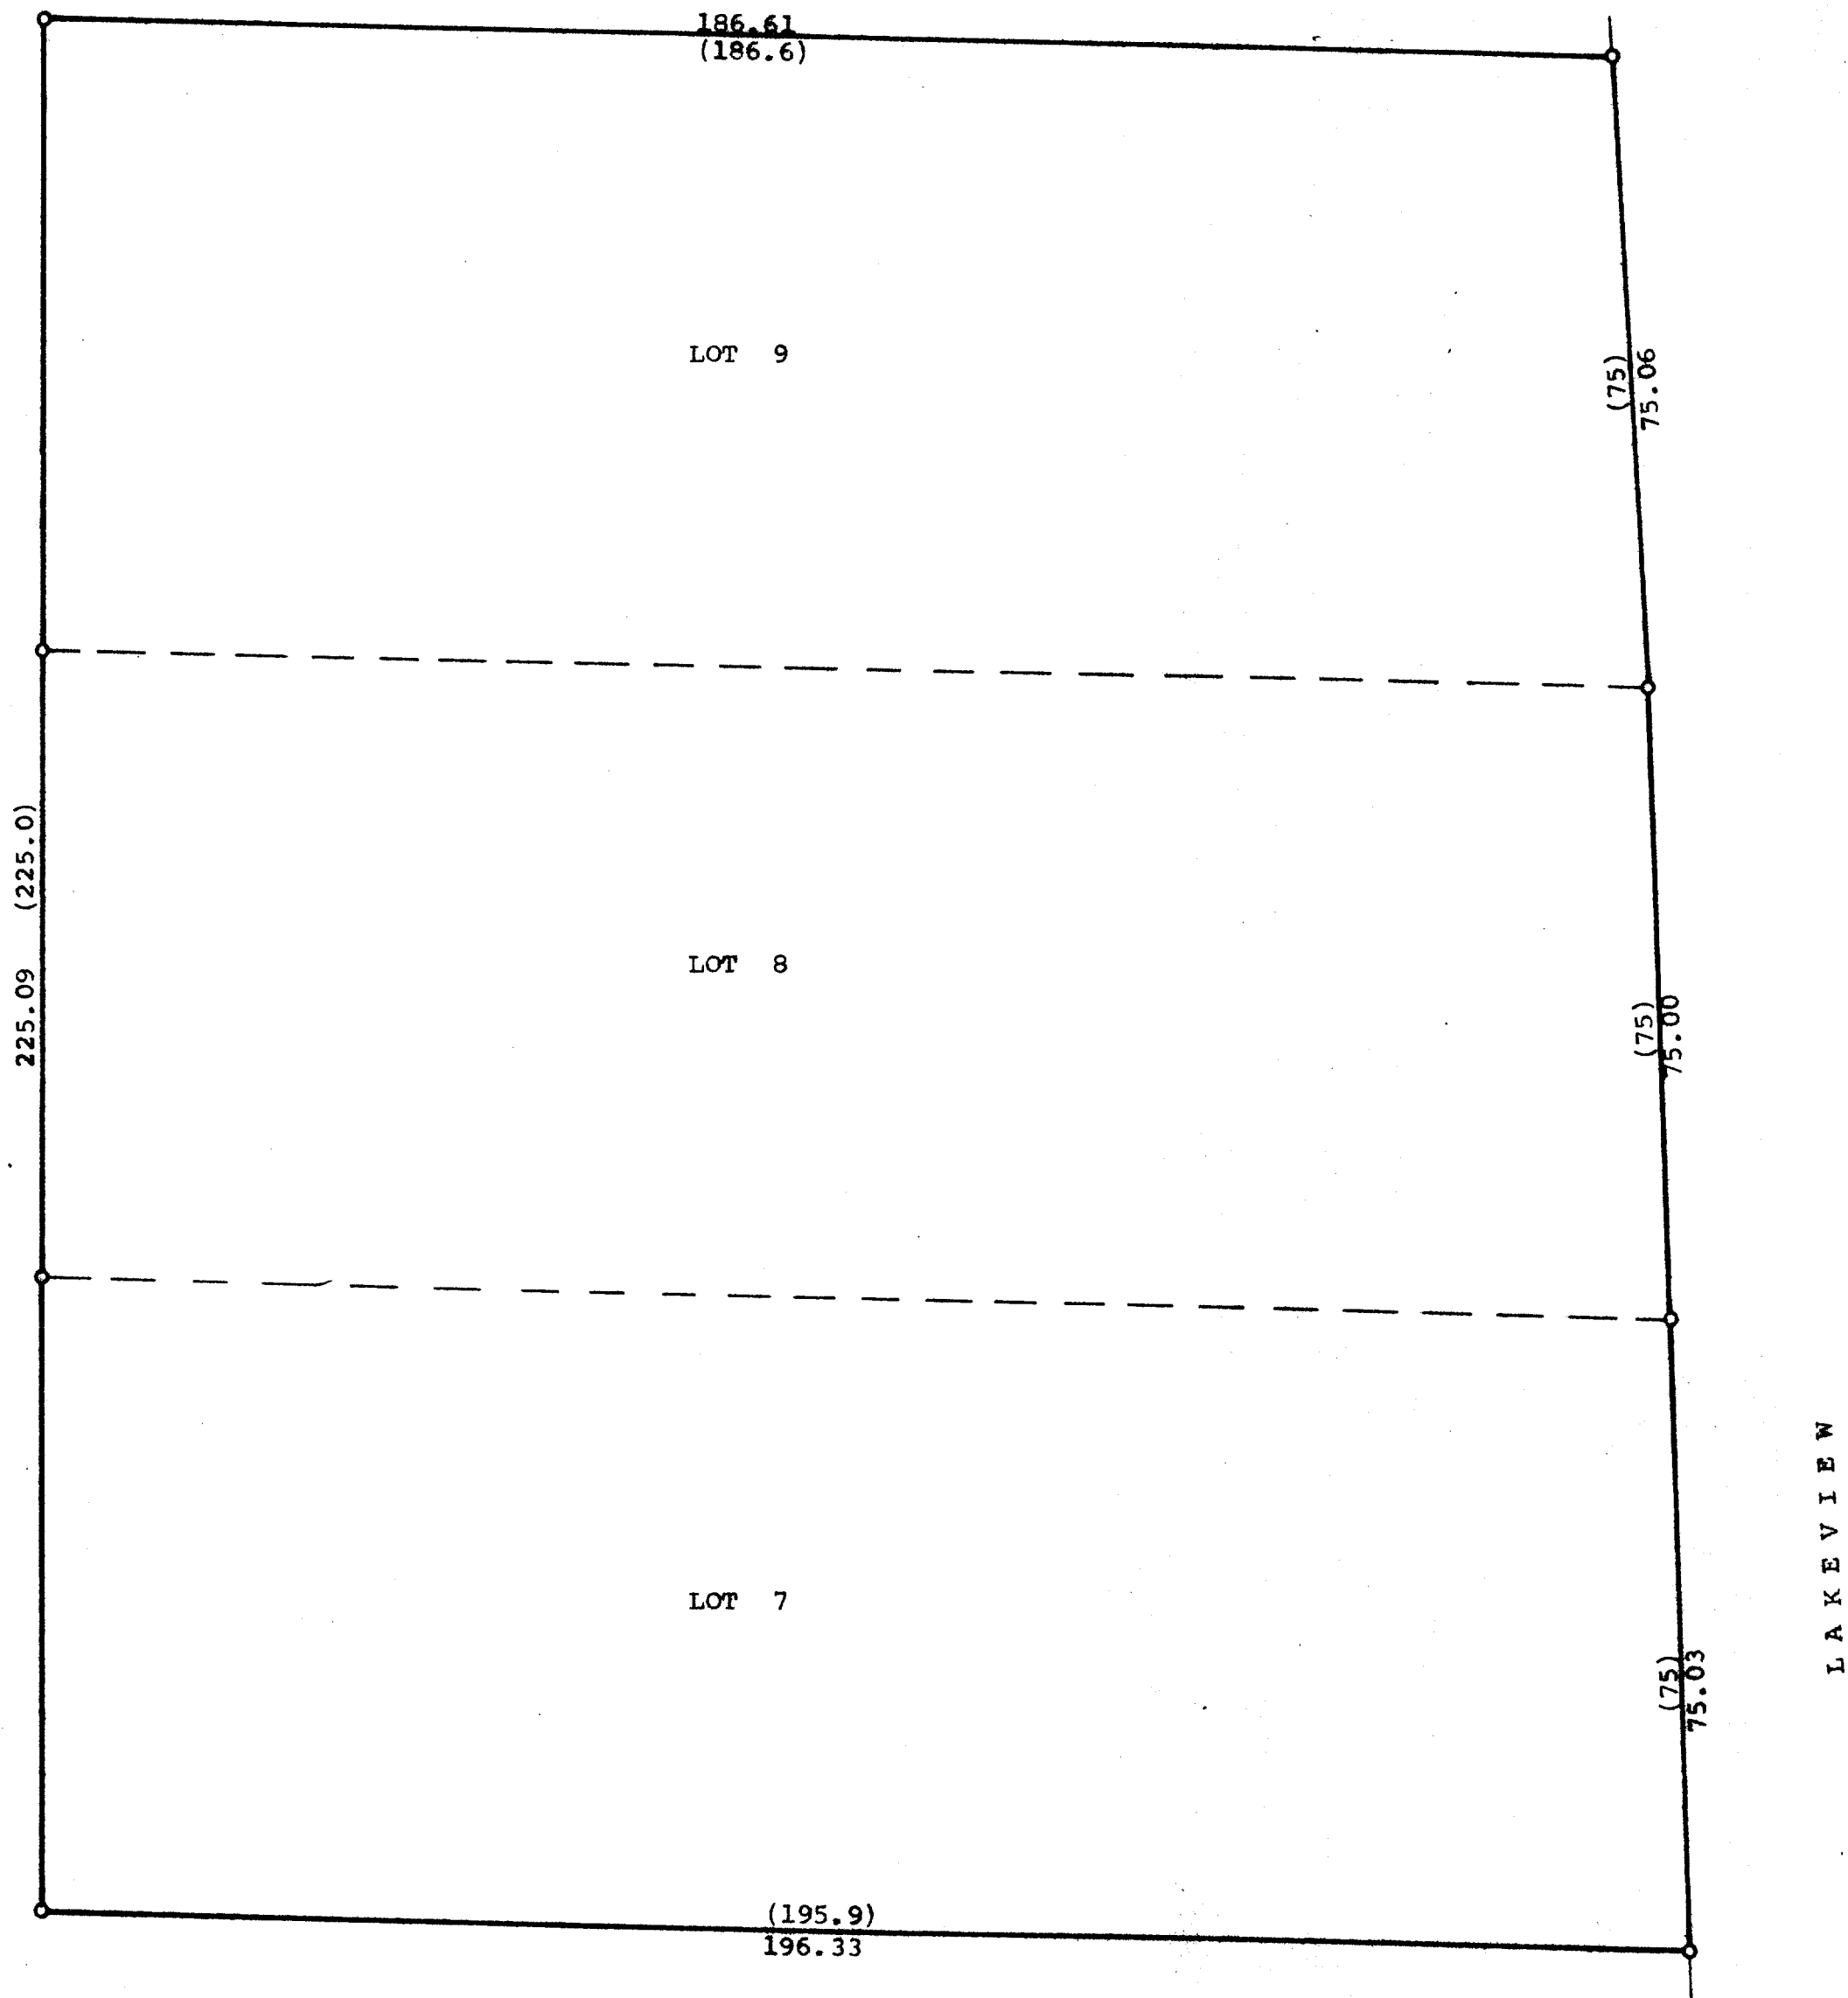

Scale - 1" = 20'
O = Iron Pipe Found
() = Recorded Distance

STATE OF WISCONSIN) SS
COUNTY OF WALWORTH)


I, James M. Dunham, Surveyor, certify that I have surveyed the property described as follows:

Lots 7, 8, and 9 in Block 6, Wooddale Addition, located in Sections 9 and 16, T1N, R17E, Walworth County, Wisconsin, and the above plat is a true representation thereof and shows the size and location of the property, its exterior boundaries, the location and dimensions of all structures thereon, fences, apparent easements and roadways and visible encroachments, if any.

This survey is made for the exclusive use of the present owners of the property, and also those who purchase, mortgage, or guarantee the title thereto within one (1) year from date hereof; and as to them I warrant the accuracy of said survey and map.

March 29, 1977

James M. Dunham
James M. Dunham, Surveyor

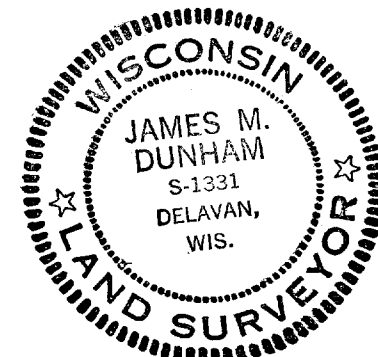

117-574