


DUNHAM SURVEYING, S.C.
SURVEYING & SUBDIVIDING
DELAVER, WISCONSIN 53115

N


Scale - 1" = 30'
Ø = Iron Pipe Found
○ = Iron Pipe Set
✱ = Iron Pin Found &
Iron Pipe Set
(0.00) = Recorded Distance

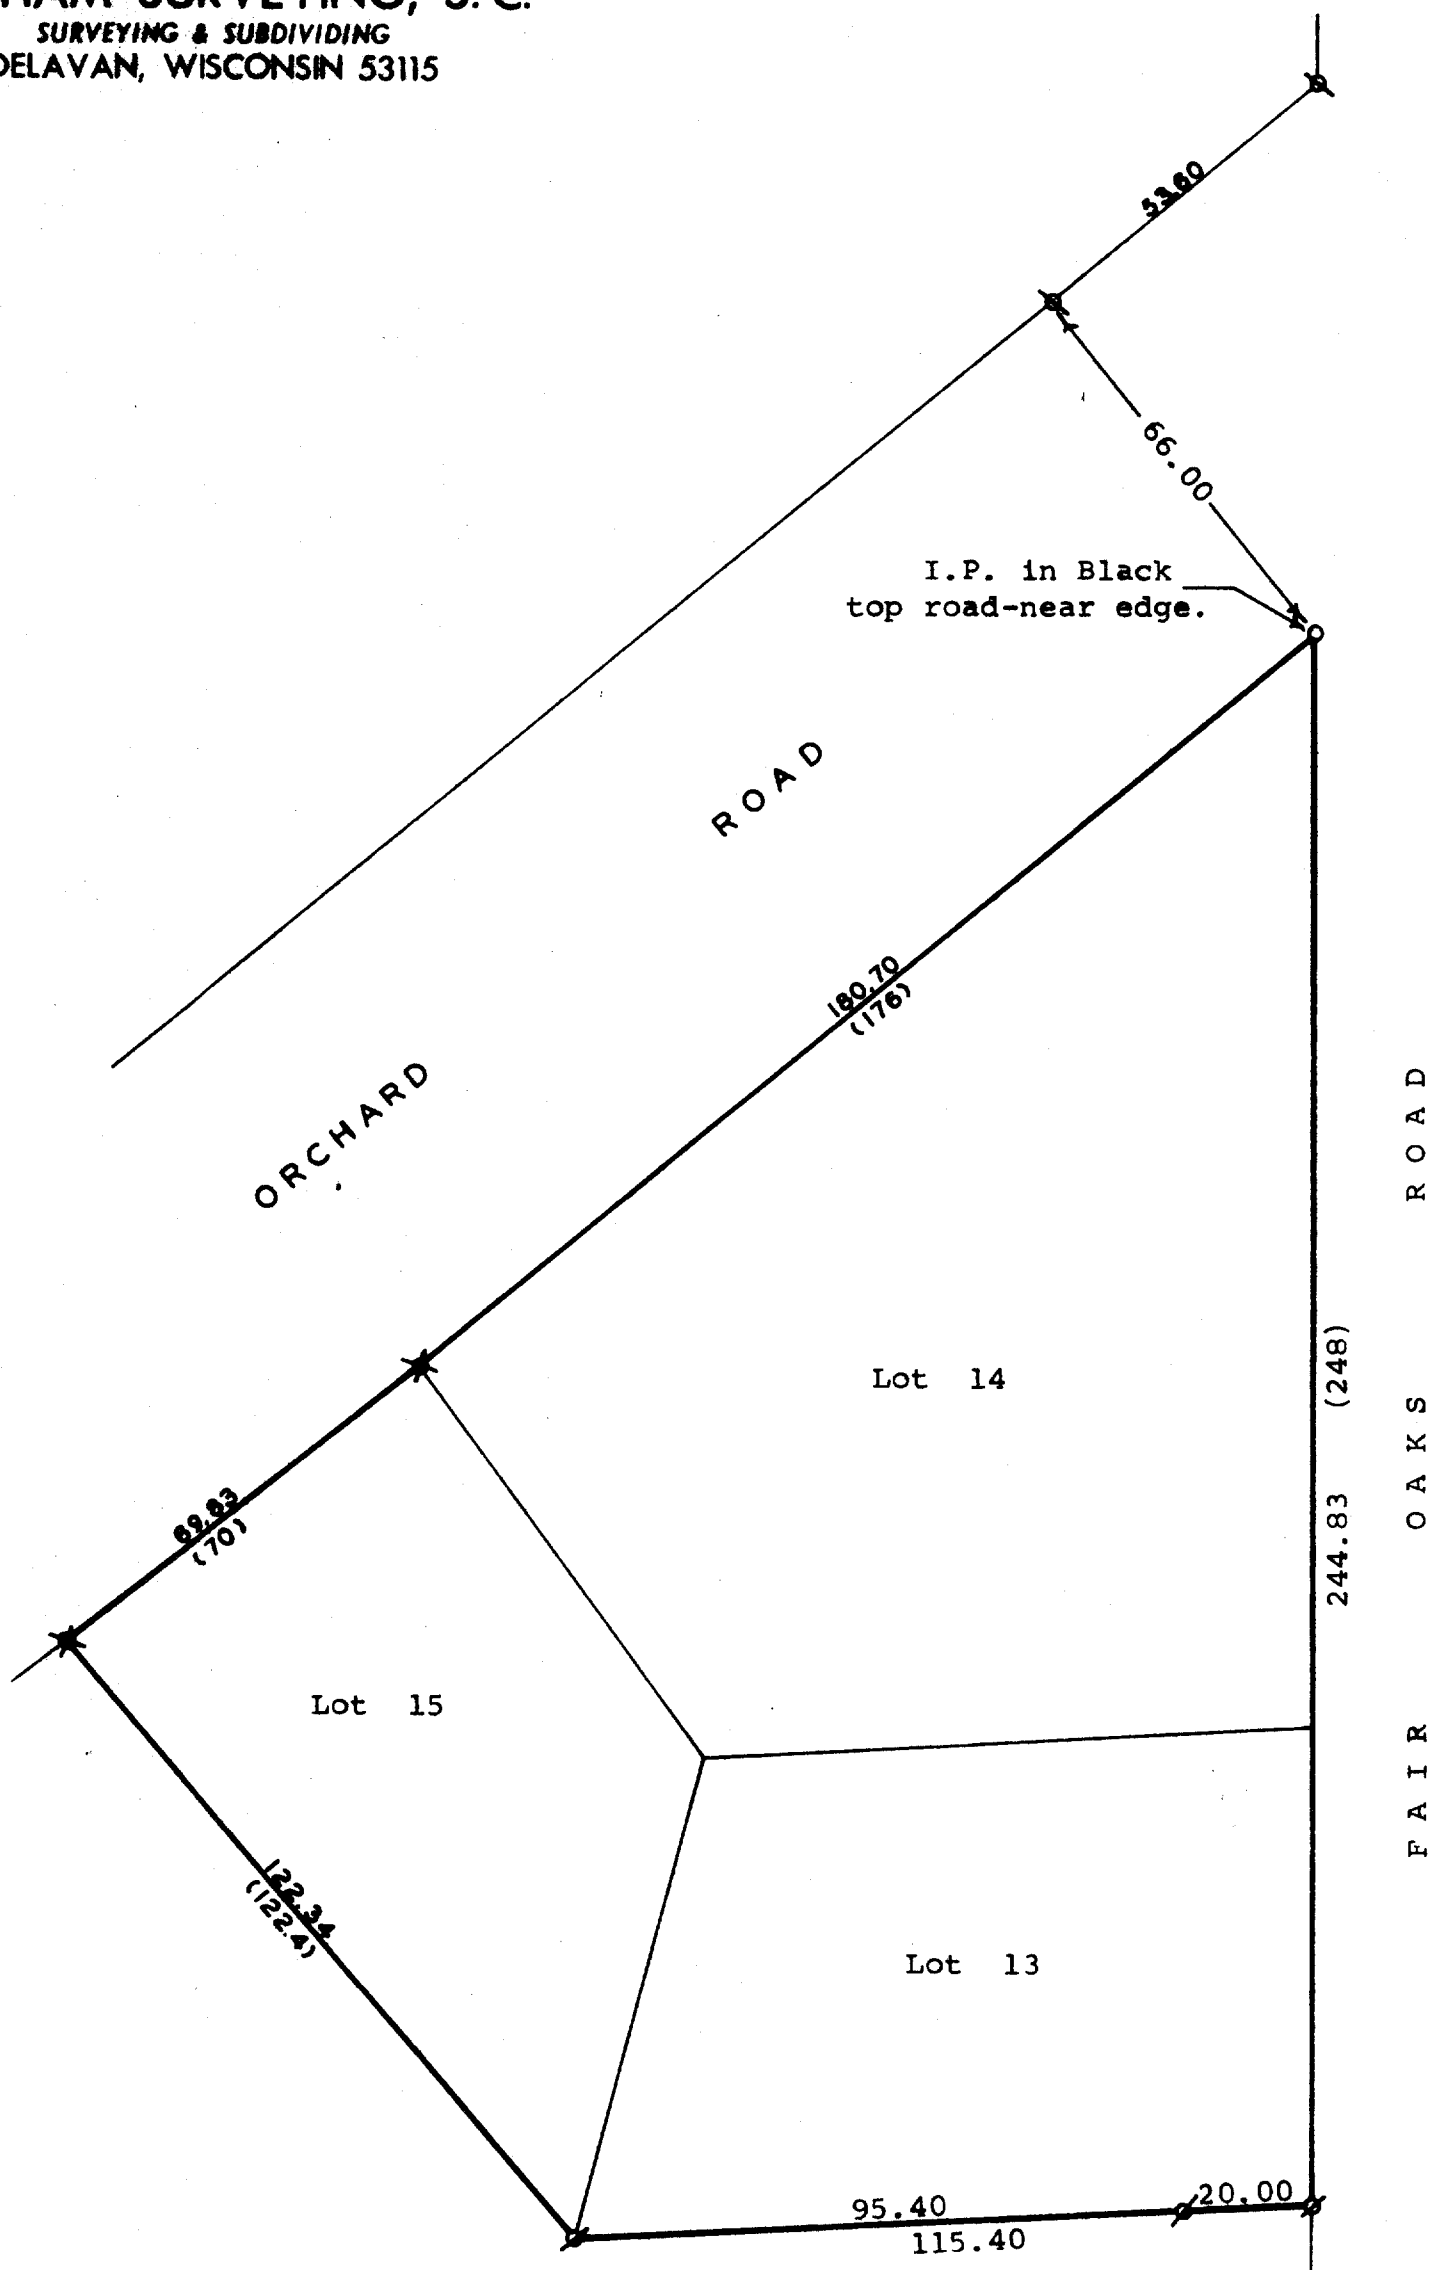

STATE OF WISCONSIN) SS
COUNTY OF WALWORTH)

I, James M. Dunham, Surveyor, certify that I have surveyed the property described as follows,
Lots 13, 14 & 15, Block 10 of Wooddale Addition, a subdivision located in the Southwest $\frac{1}{4}$ of fractional Section 9, and in Section 16, T 1 N, R 17 E, Walworth County, Wisconsin, and the above map is a true representation thereof and shows the size and location of the property, its exterior boundaries, the location and dimensions of all structures thereon, fences, apparent easements and roadways and visible encroachments, if any.
This survey is made for the exclusive use of the present owners of the property, and also those who purchase, mortgage, or guarantee the title thereto within one (1) year from date hereof; and as to them I warrant the accuracy of said survey and map.
May 23, 1977

James M. Dunham
James M. Dunham, Surveyor

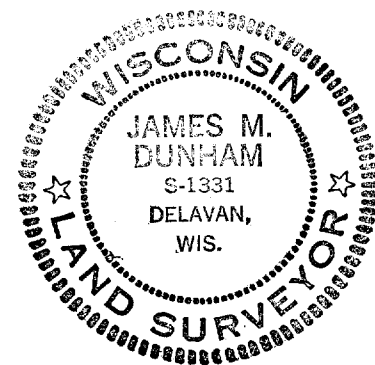

117-577